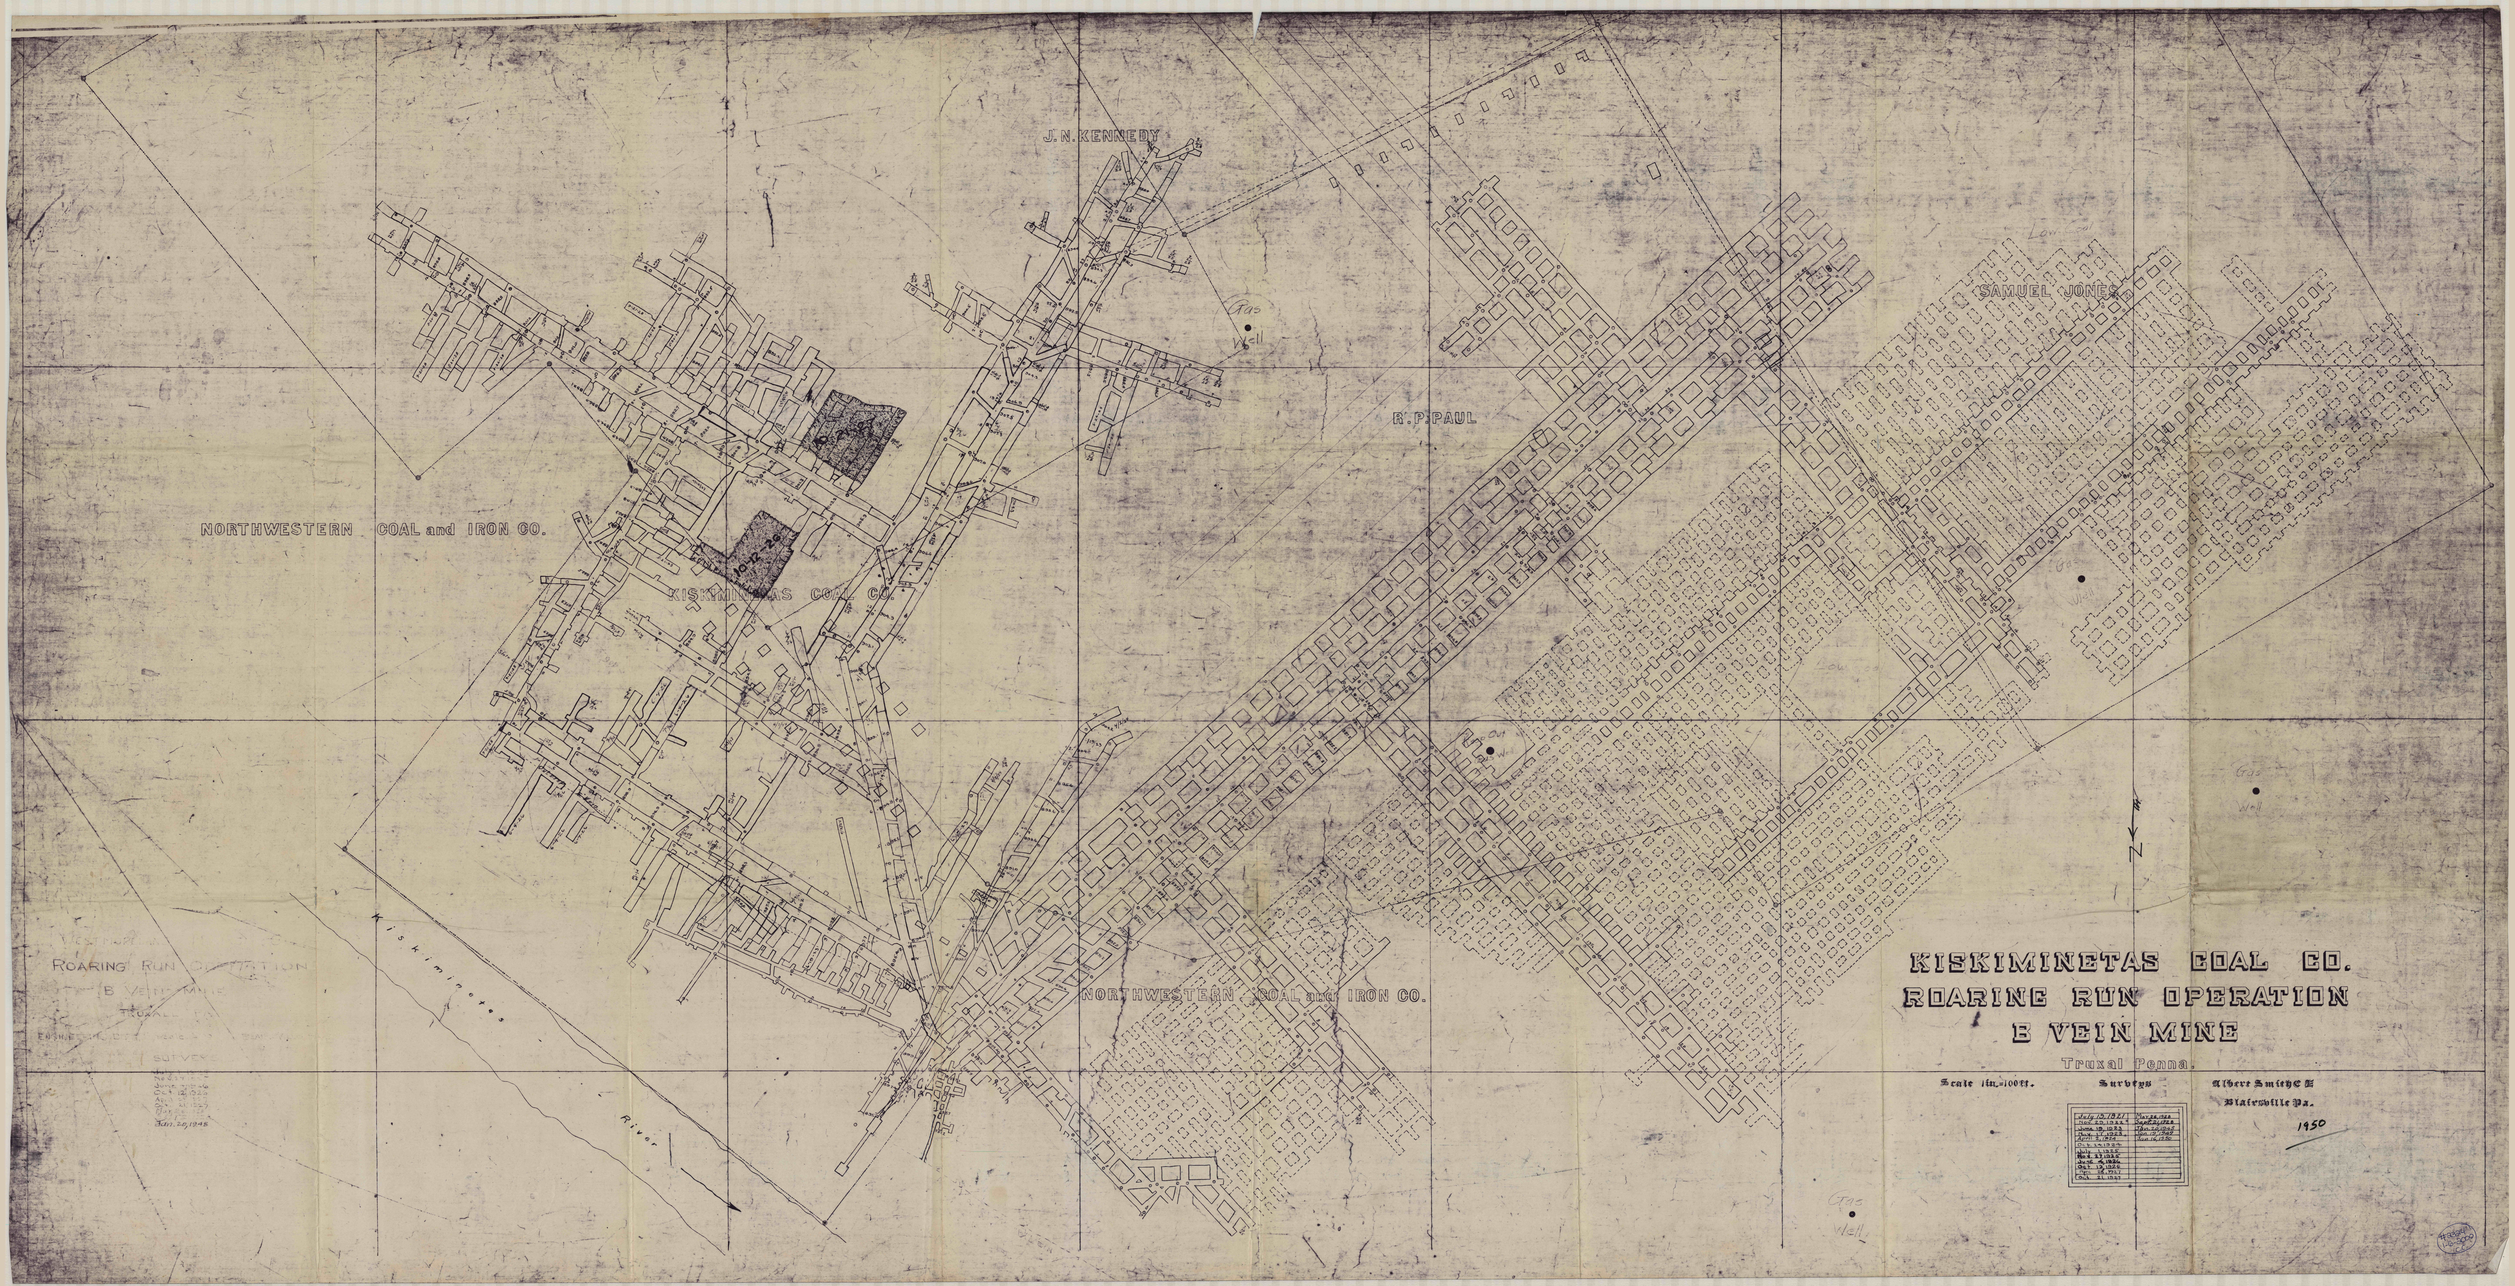
J. N. KENNEDY
R. P. PAUL
SAMUEL JONES
NORTHWESTERN COAL and IRON CO.
KISKIMINETAS COAL CO.
NORTHWESTERN COAL and IRON CO.
Kiskiminetas
River
Gas Well
KISKIMINETAS COAL CO.
ROARING RUN OPERATION
B VEIN MINE
Truxal Penna.
Scale 1in.=100ft.
Surveys
Albert Smith & Son
Blairsville Pa.
1950