


**LEGEND**

- ⊙ BODIES OF MEN
- CANVAS
- ⊔ DOORS
- | STOPPINGS
- ⊠ OVERCASTS
- AIR CURRENTS

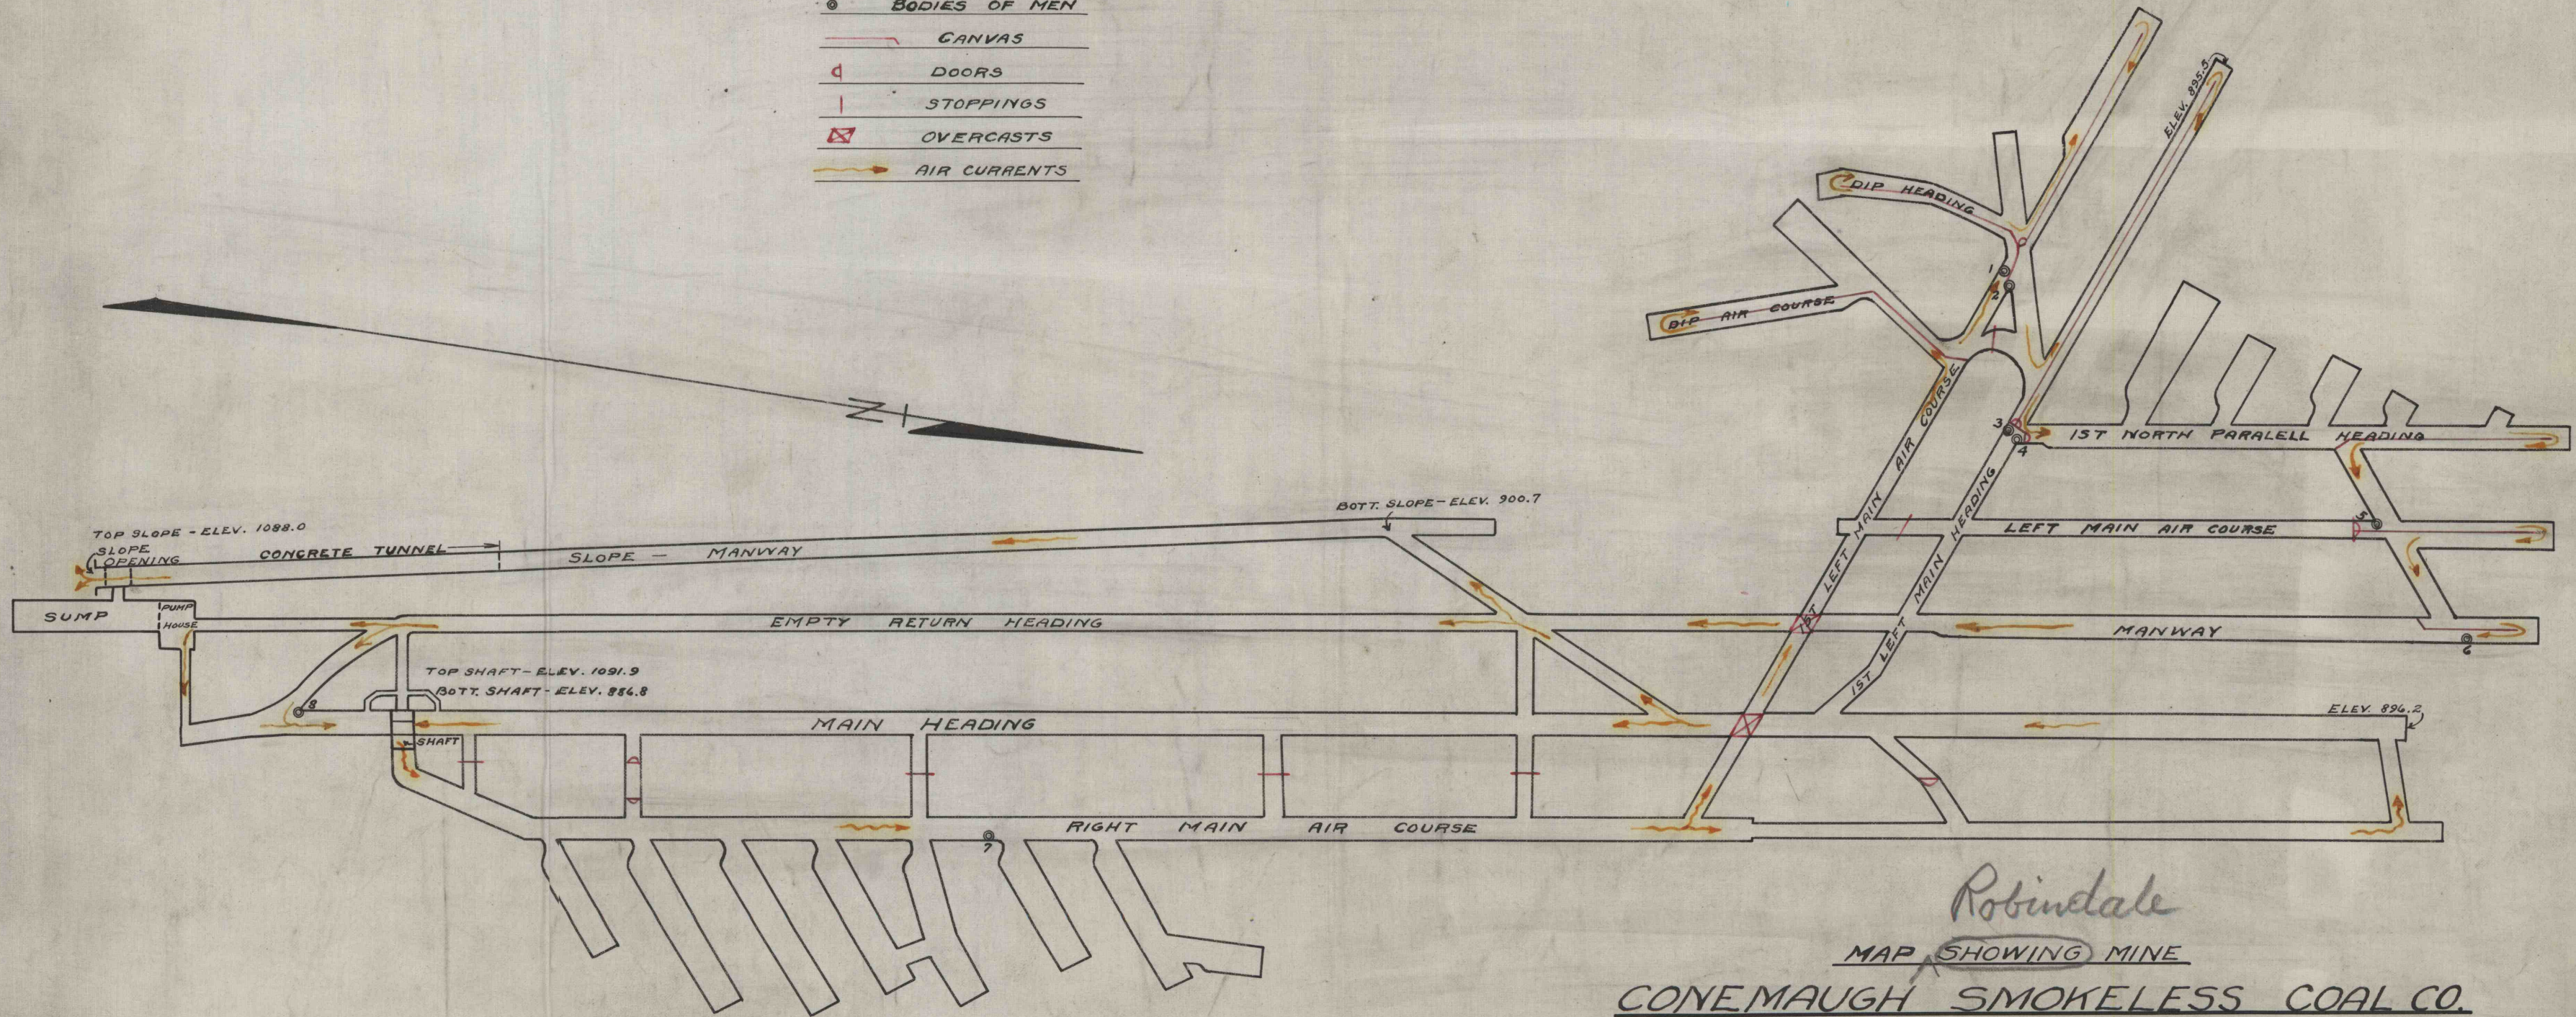

*Robindale*

MAP SHOWING MINE

**CONEMAUGH SMOKELESS COAL CO.**

SITUATE IN

**E. WHEATFIELD TWP. - INDIANA CO. PA.**

MAR. 30, 1916

SCALE: 1" = 100'

FETTERMAN ENG. CO.

#2335  
1-11-2000  
CC