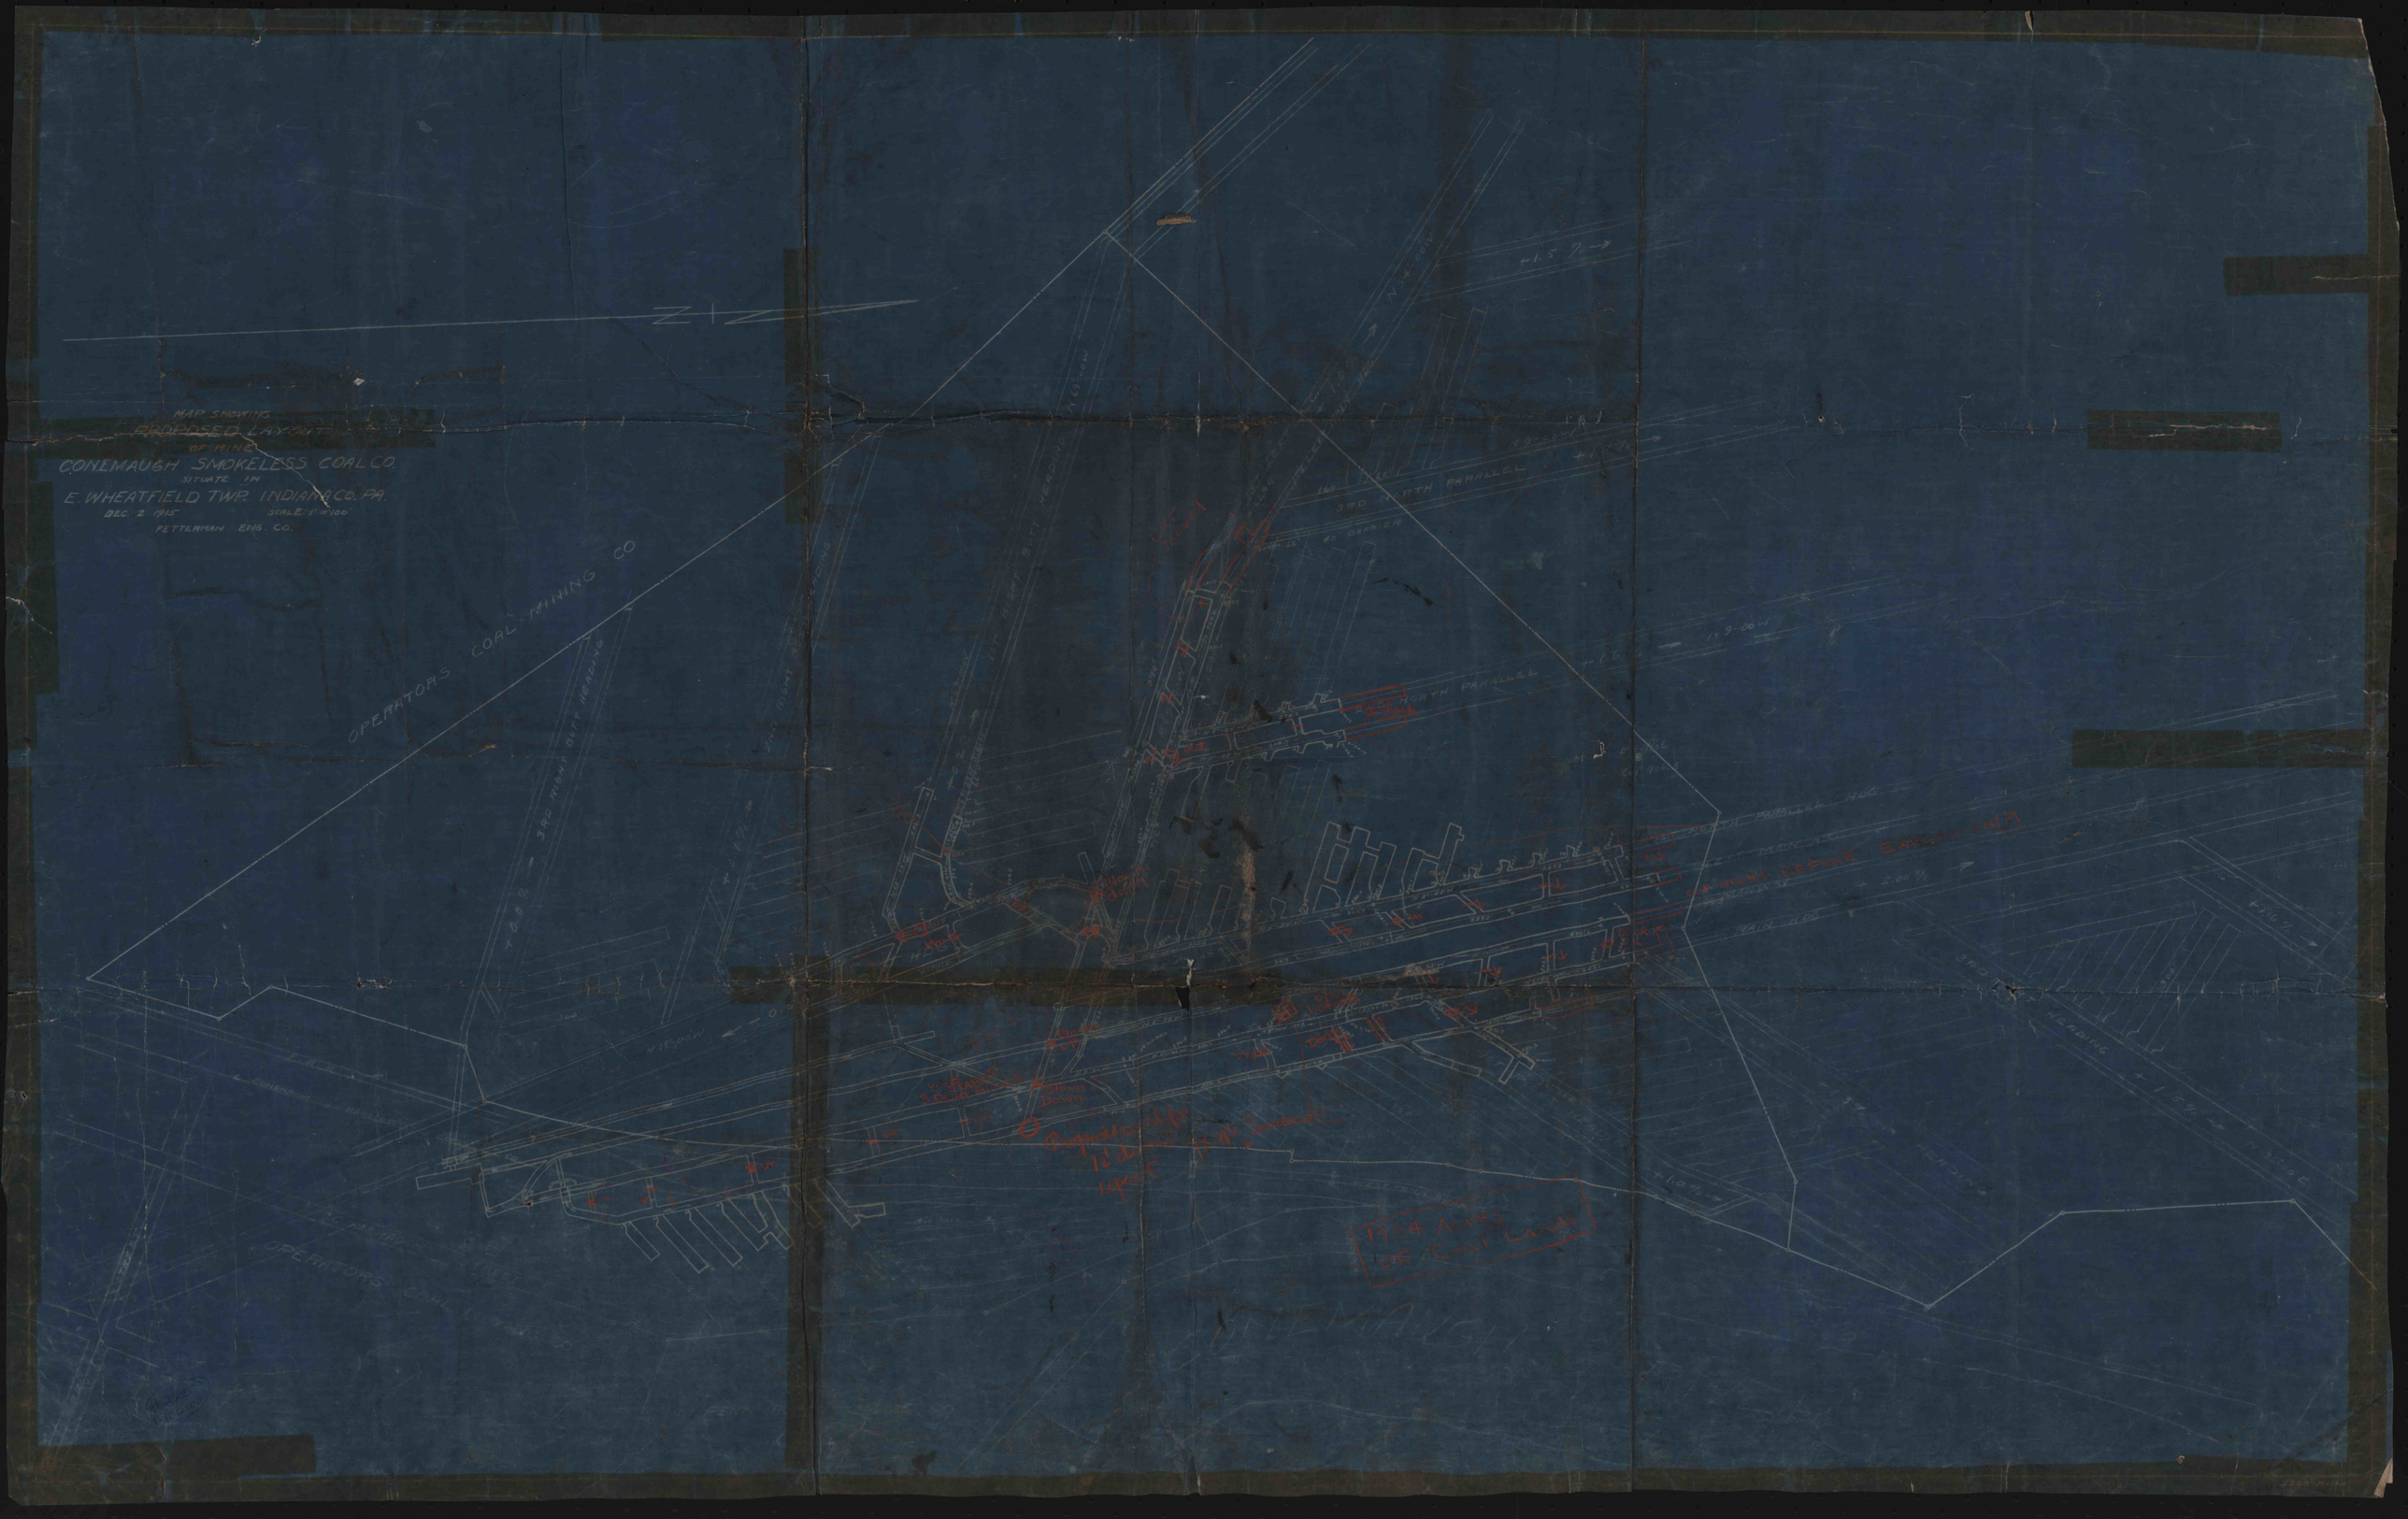
MAP SHOWING
PROPOSED LAYOUT
OF MINE
CONEMAUGH SMOKELESS COAL CO.
SITUATE IN
E. WHEATFIELD TWP. INDIANA CO. PA.
DEC. 2 1915
SCALE: 1" = 100'
FETTERMAN ENG. CO.
OPERATORS COAL MINING CO
3RD NORTH PARALLEL
1st RIGHT BUTT HEADING
3RD RIGHT BUTT HEADING
1924 ACRES OF COAL LAND