


MAP SHOWING
 PROPOSED LAYOUT
 OF MINE
 CONEMAUGH SMOKELESS COAL CO.
 SITUATE IN
 E. WHEATFIELD TWP. INDIANA CO. PA.
 DEC. 2. 1915 SCALE 1" = 100'
 FETTERMAN ENG. CO.

PRINT SHOWING CONDITION OF THE MINE AT TIME OF EXPLOSION
 MARCH 30, 1916

LEGEND

- BODIES OF MEN
- CANVAS
- D DOOR
- AIR CURRENT
- ⊠ OVERCAST
- MASONRY STOPPING

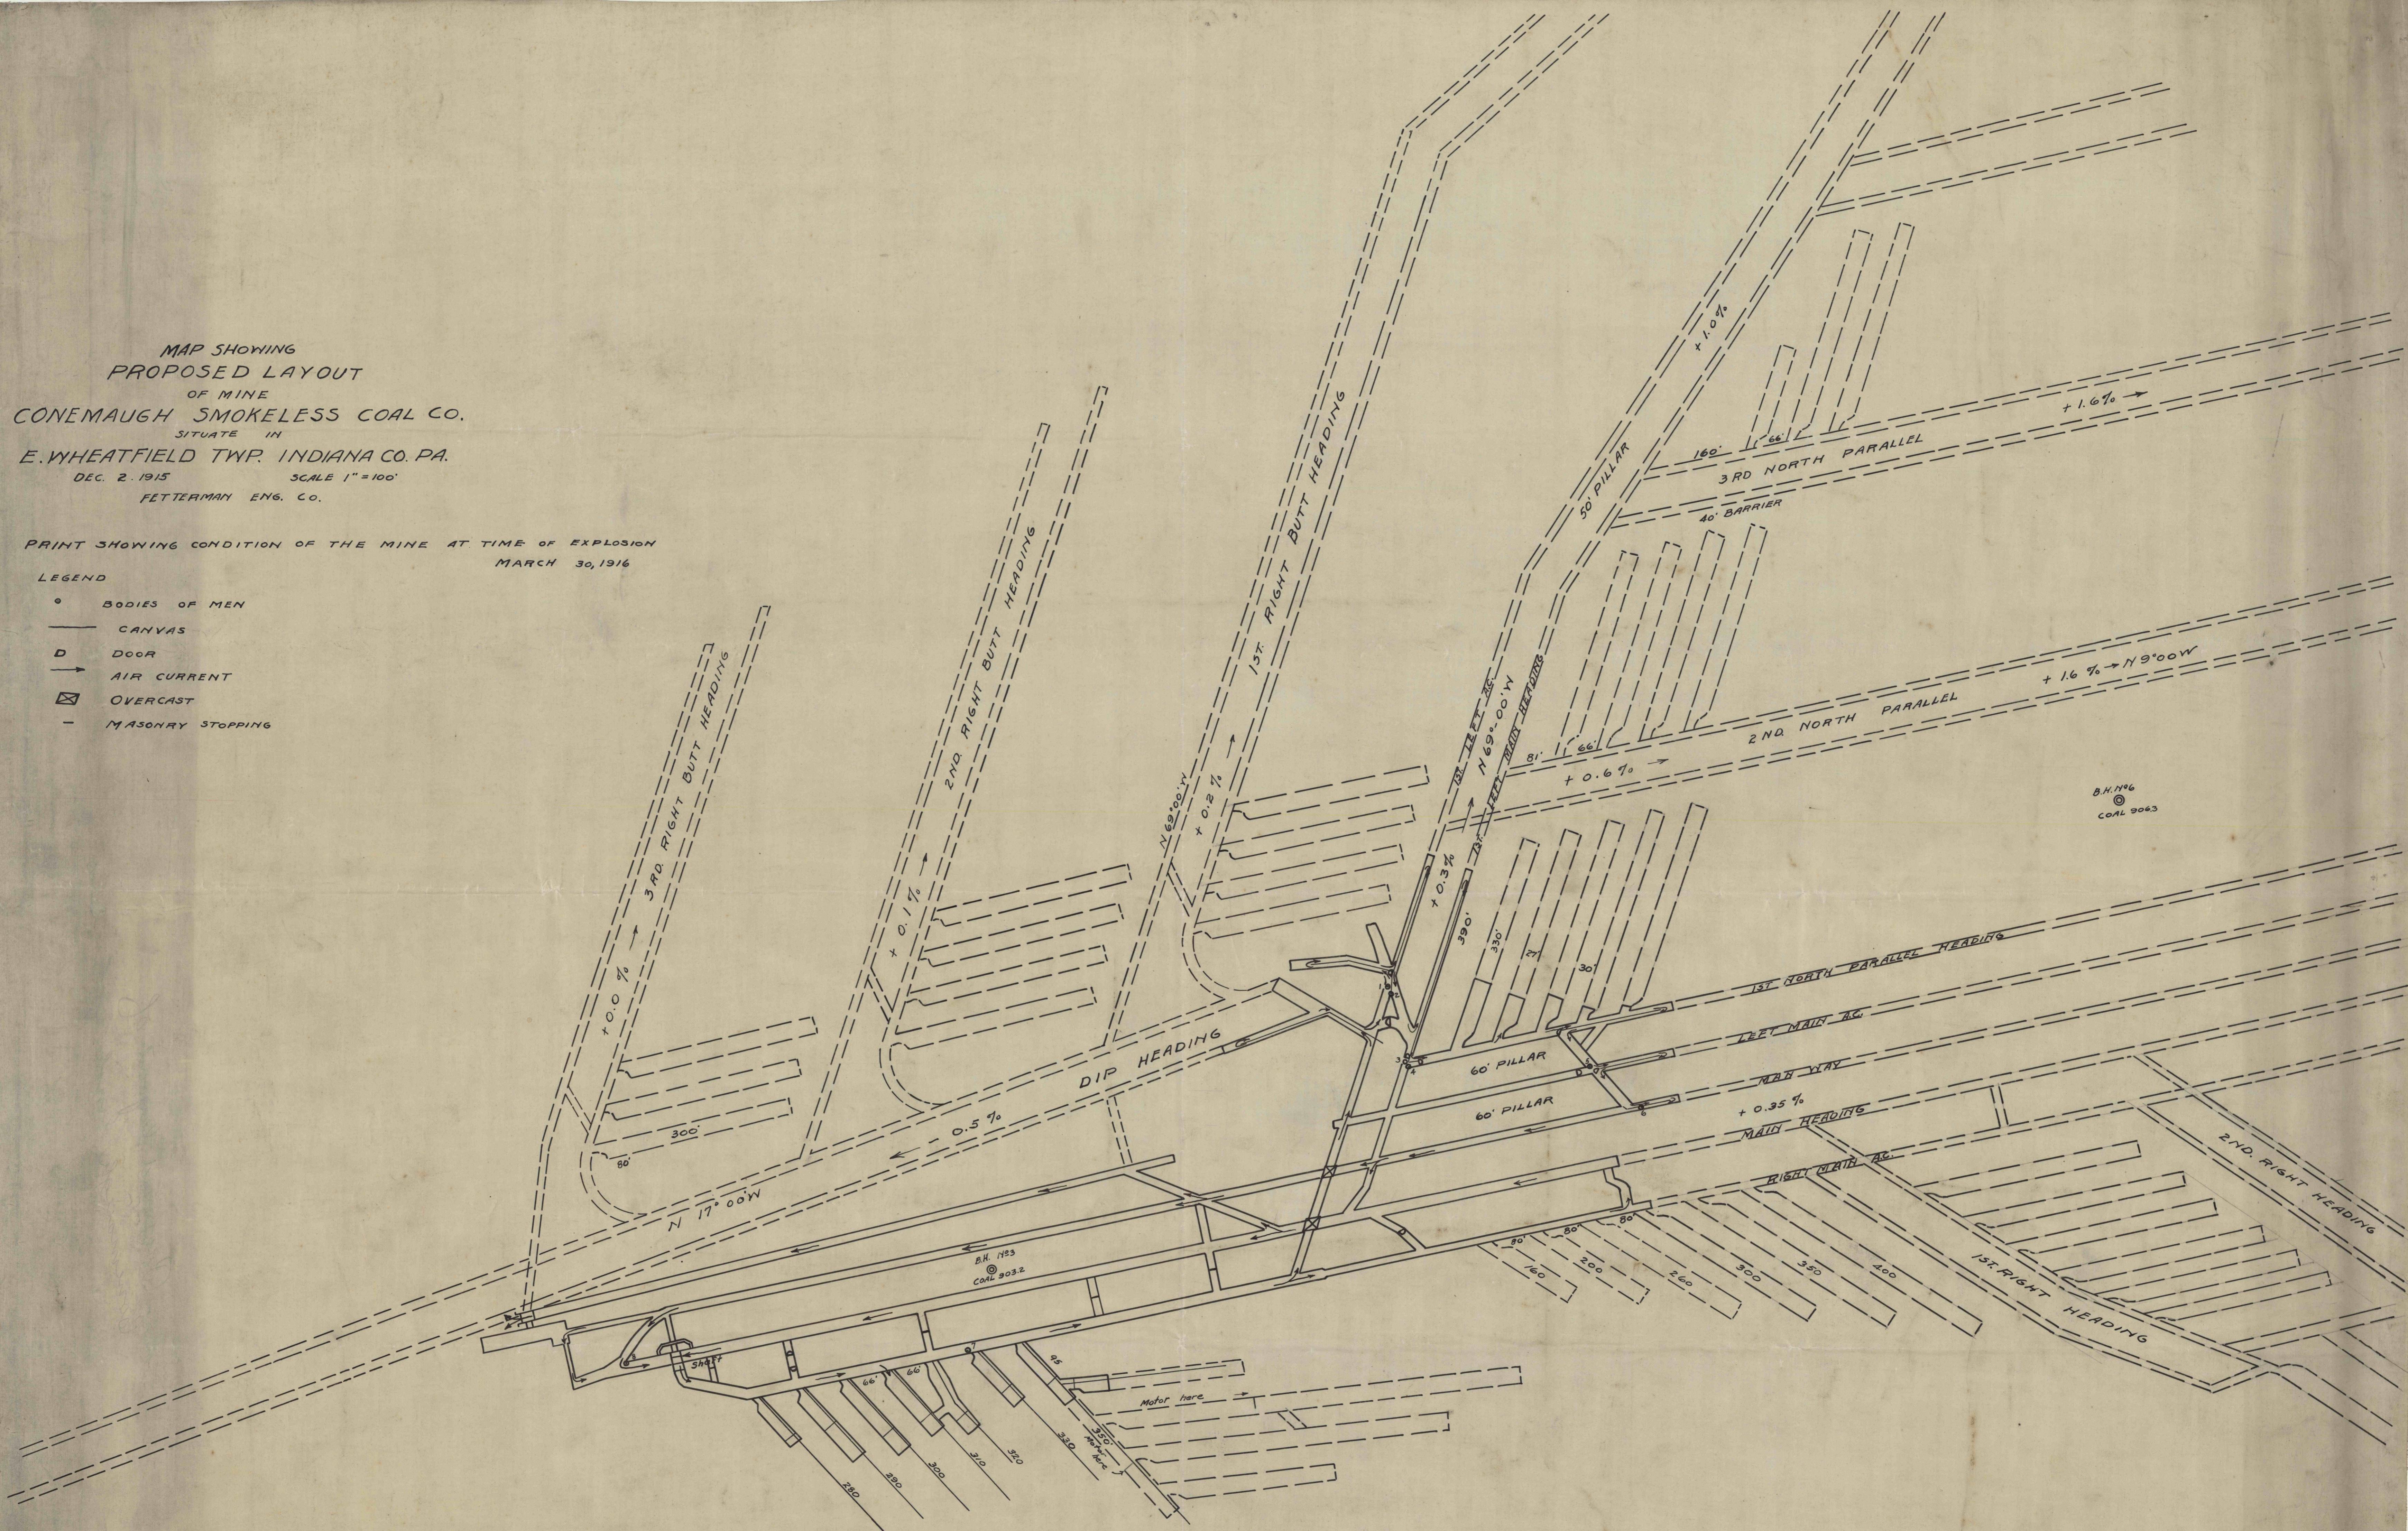

2335
 1-11-2000
 cc