


Scene 2



5-16,000

5-12,000

5-8,000

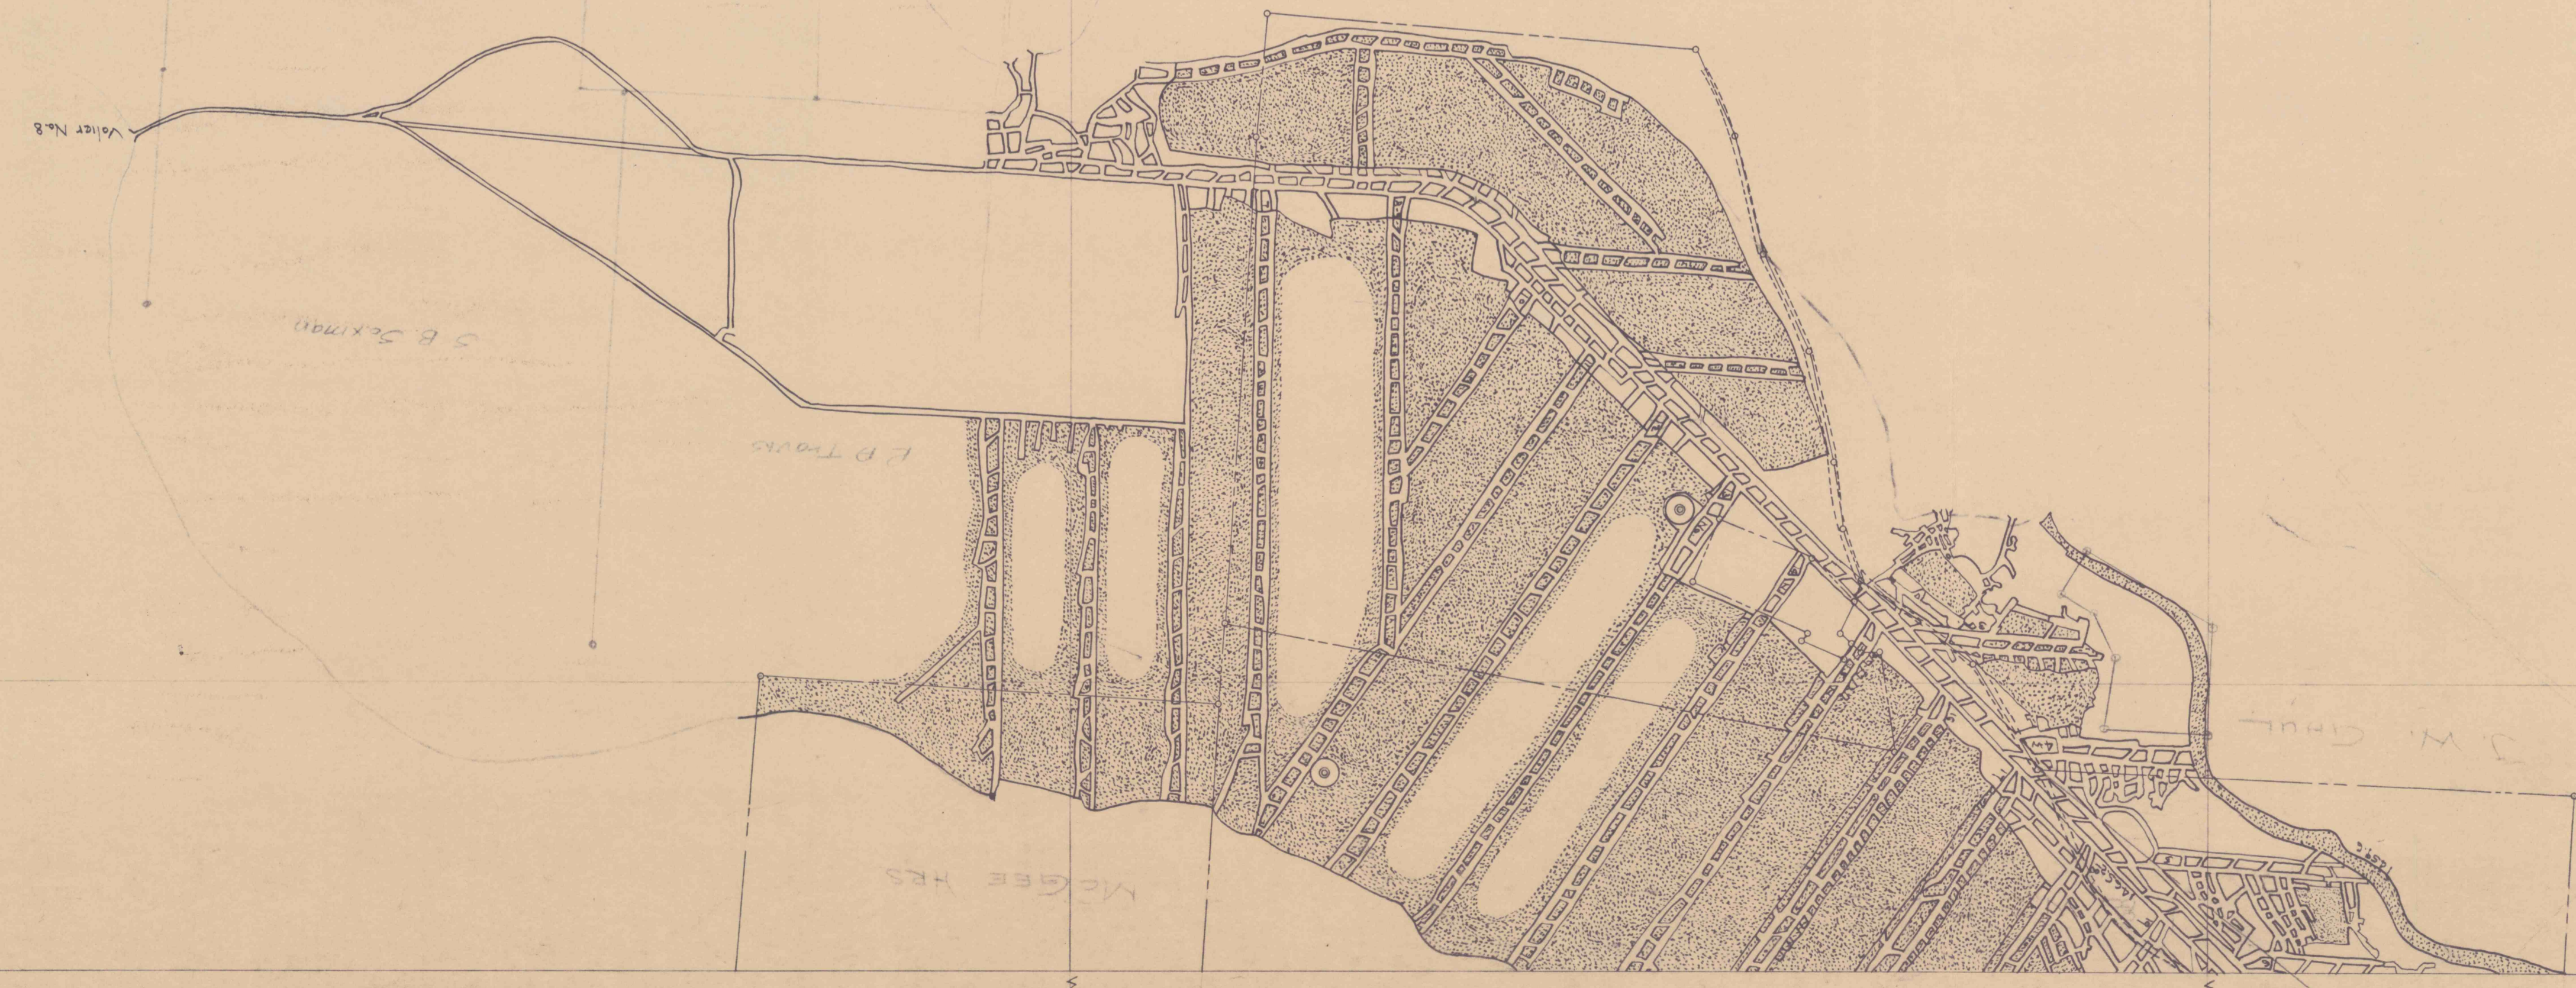

5-16,000

5-12,000

5-8,000