




N-222,000

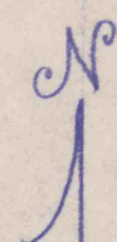

N-221,000

N-220,000

N-219,000

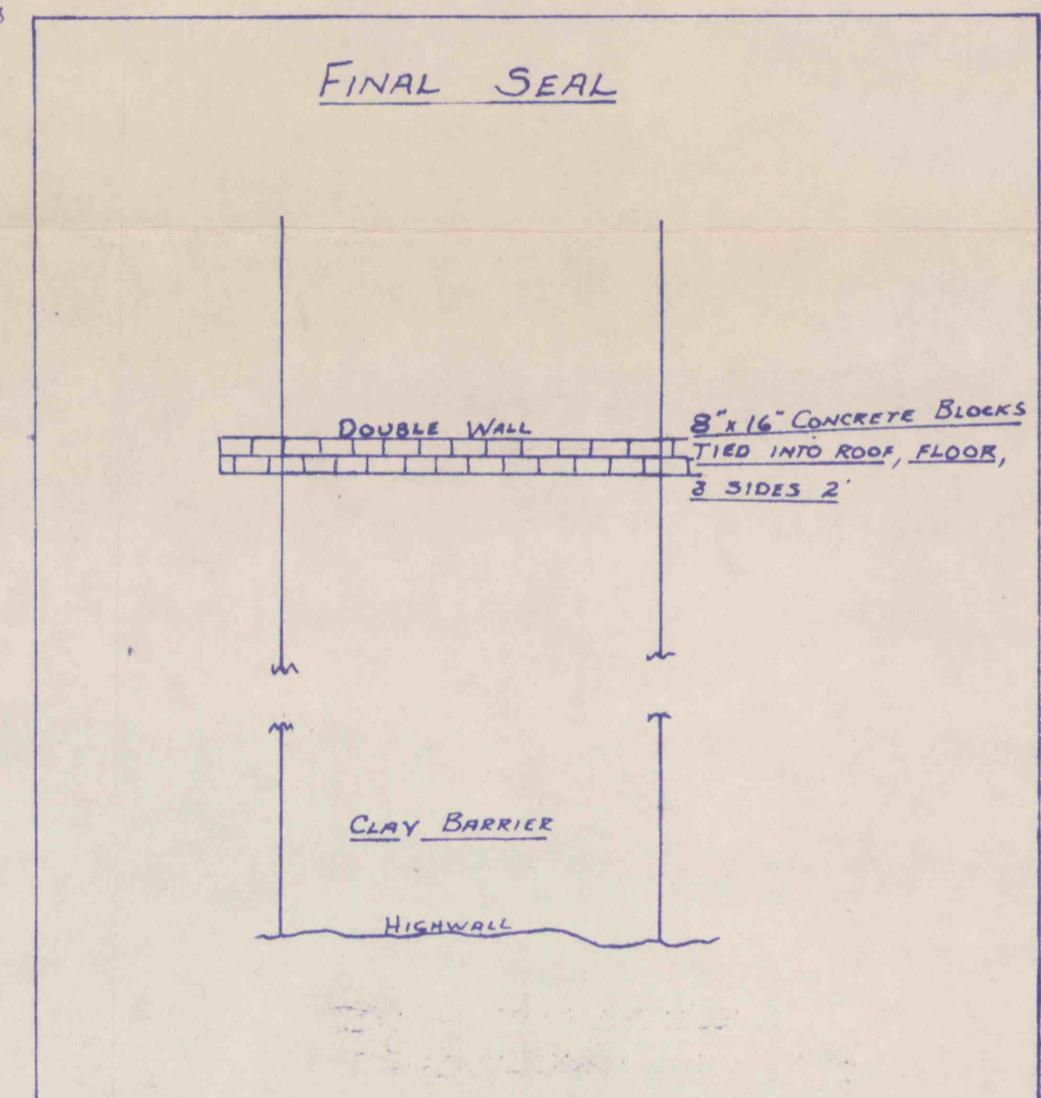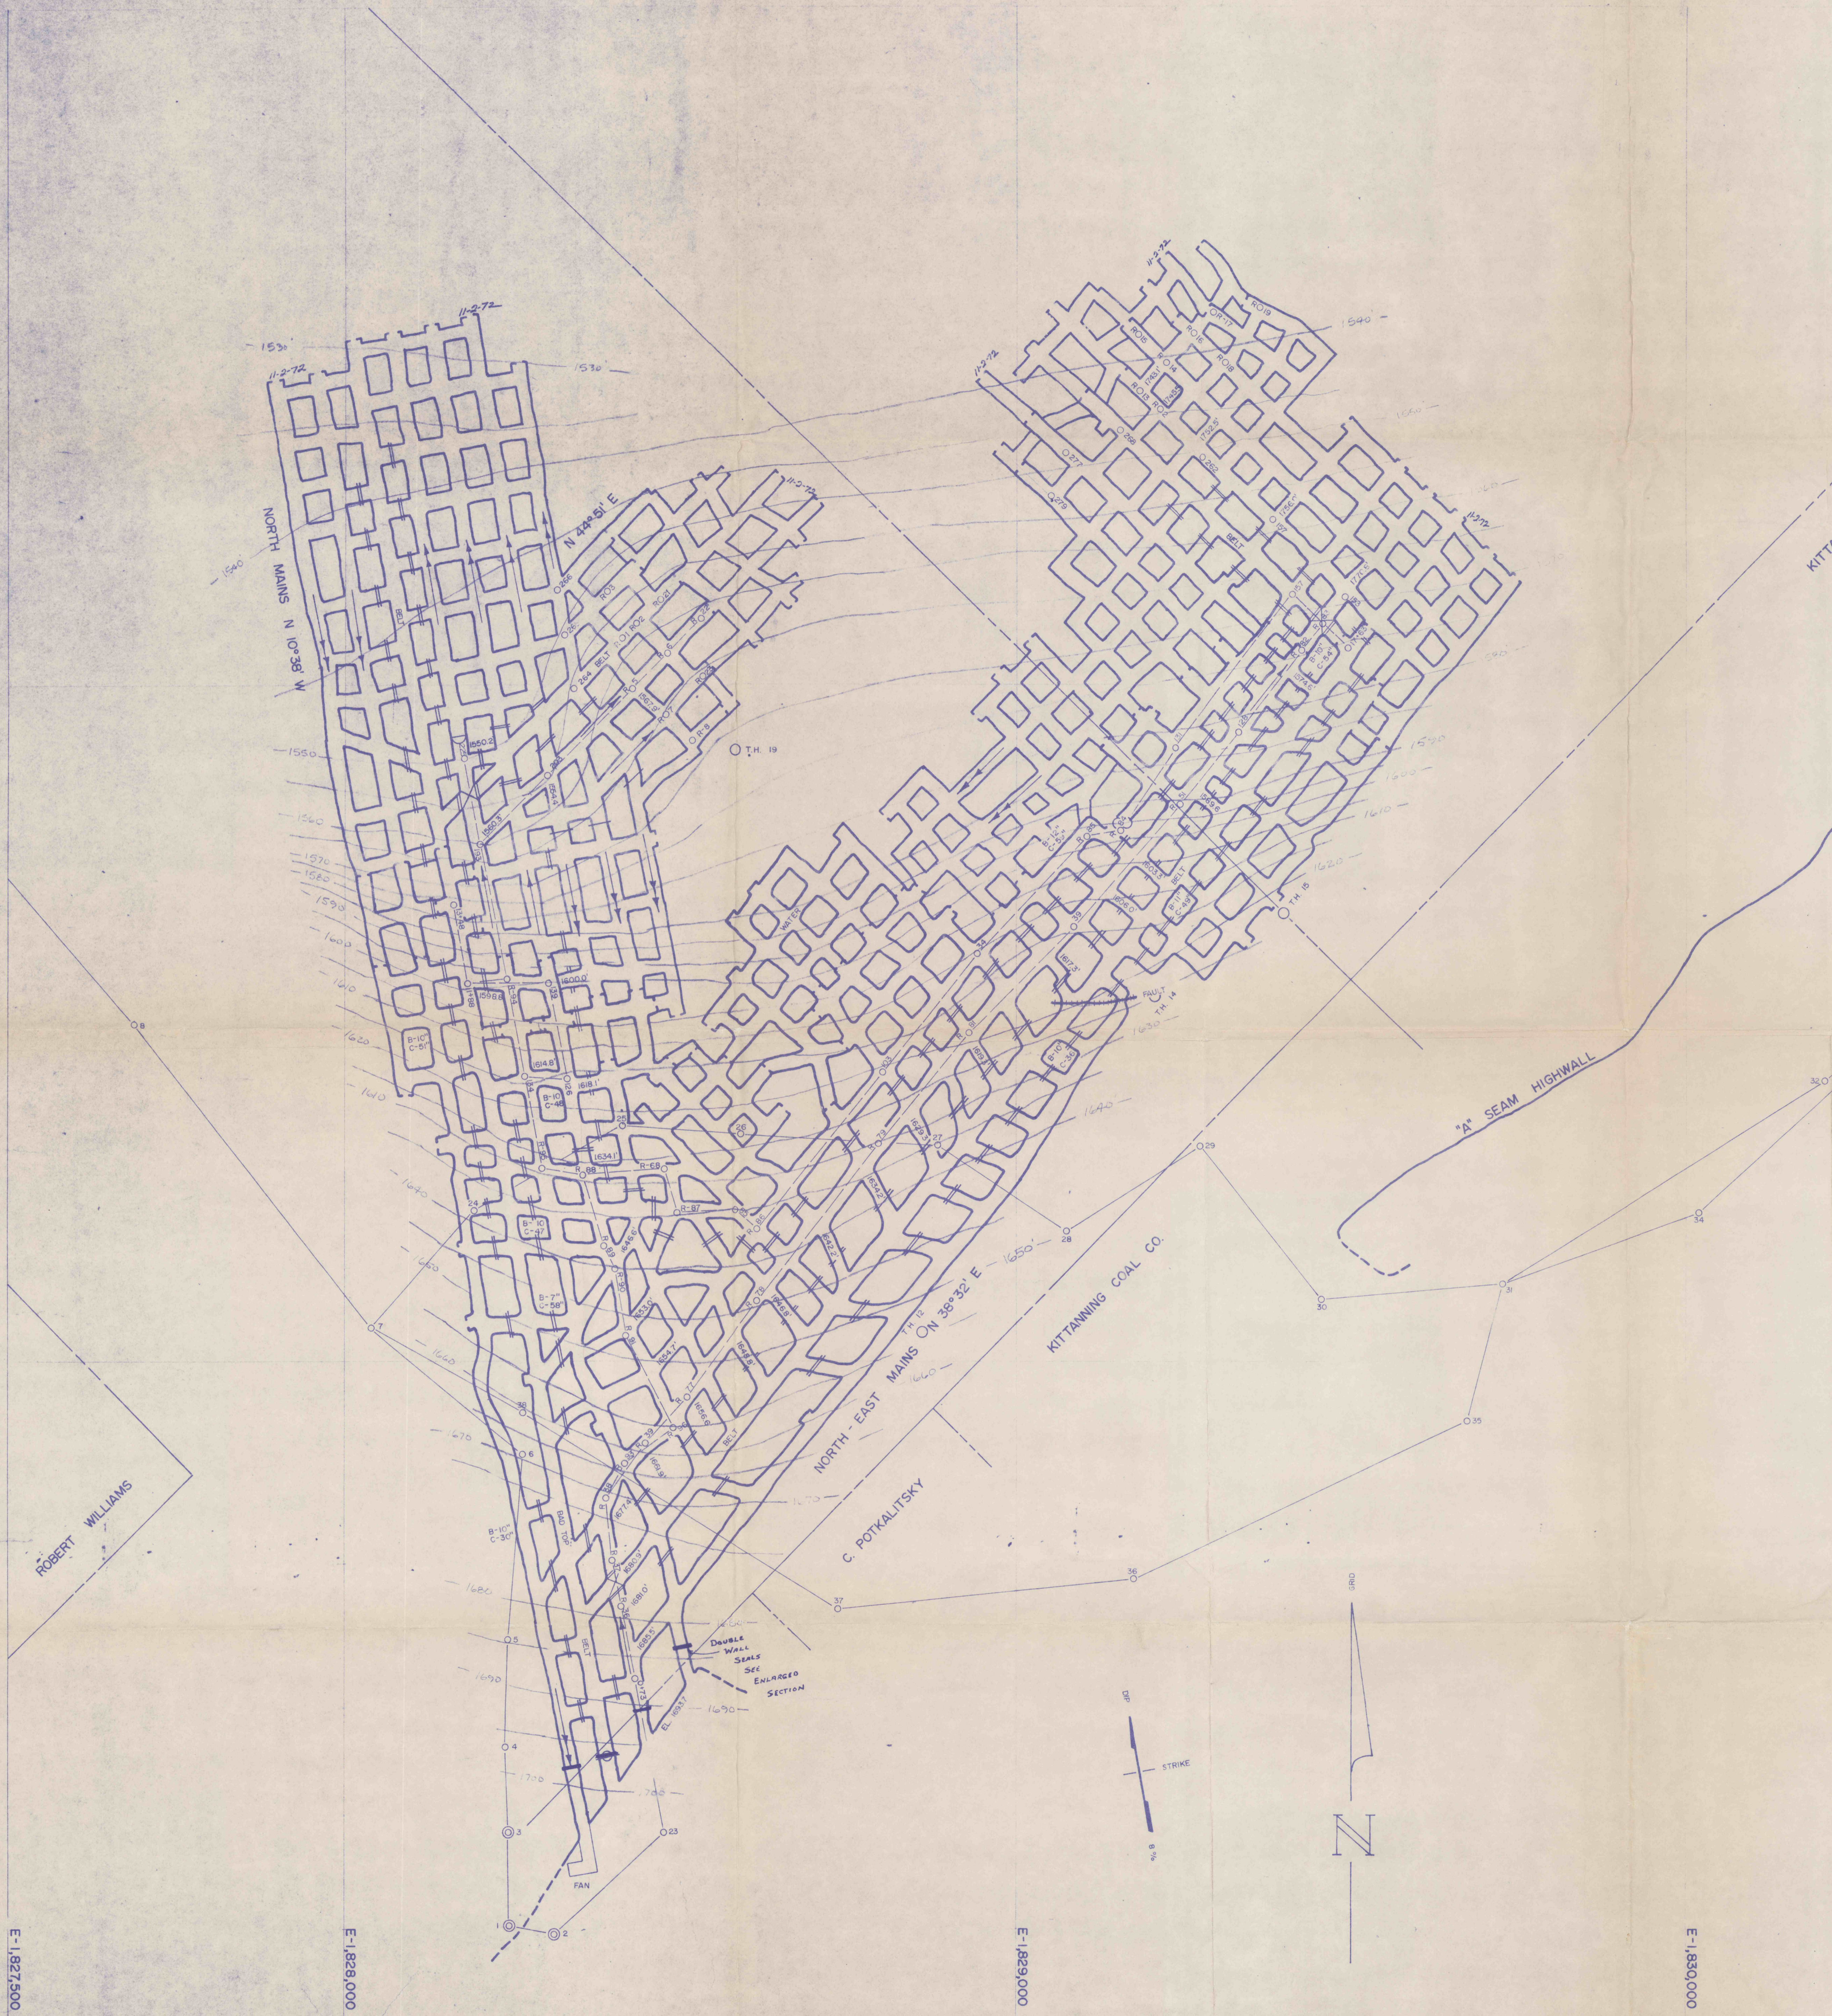

FINAL MAP 9-473 CLEARING A SEAM

**ELLIOT COAL MINING CO. INC.**  
 Osceola Mills, Pa.  
**ROSEMARY NO. 1 MINE**  
 near  
**Ginter, Clearfield Co., Pa.**  
 Scale 1" = 100' EXTENDED TO 11-2-72  
 Elevations taken from U.S.G.S., B.M.  
 U.S.B.M. ID. NO. 36-02389-0

APPROVED BY: *Michael Korman mine foreman*  
 APPROVED BY: *Jack L Marshall Gen Mgr*  
 APPROVED BY:

#2343  
1-6-2000  
C.C.