



MATCH LINE C-C

MATCH LINE C-C

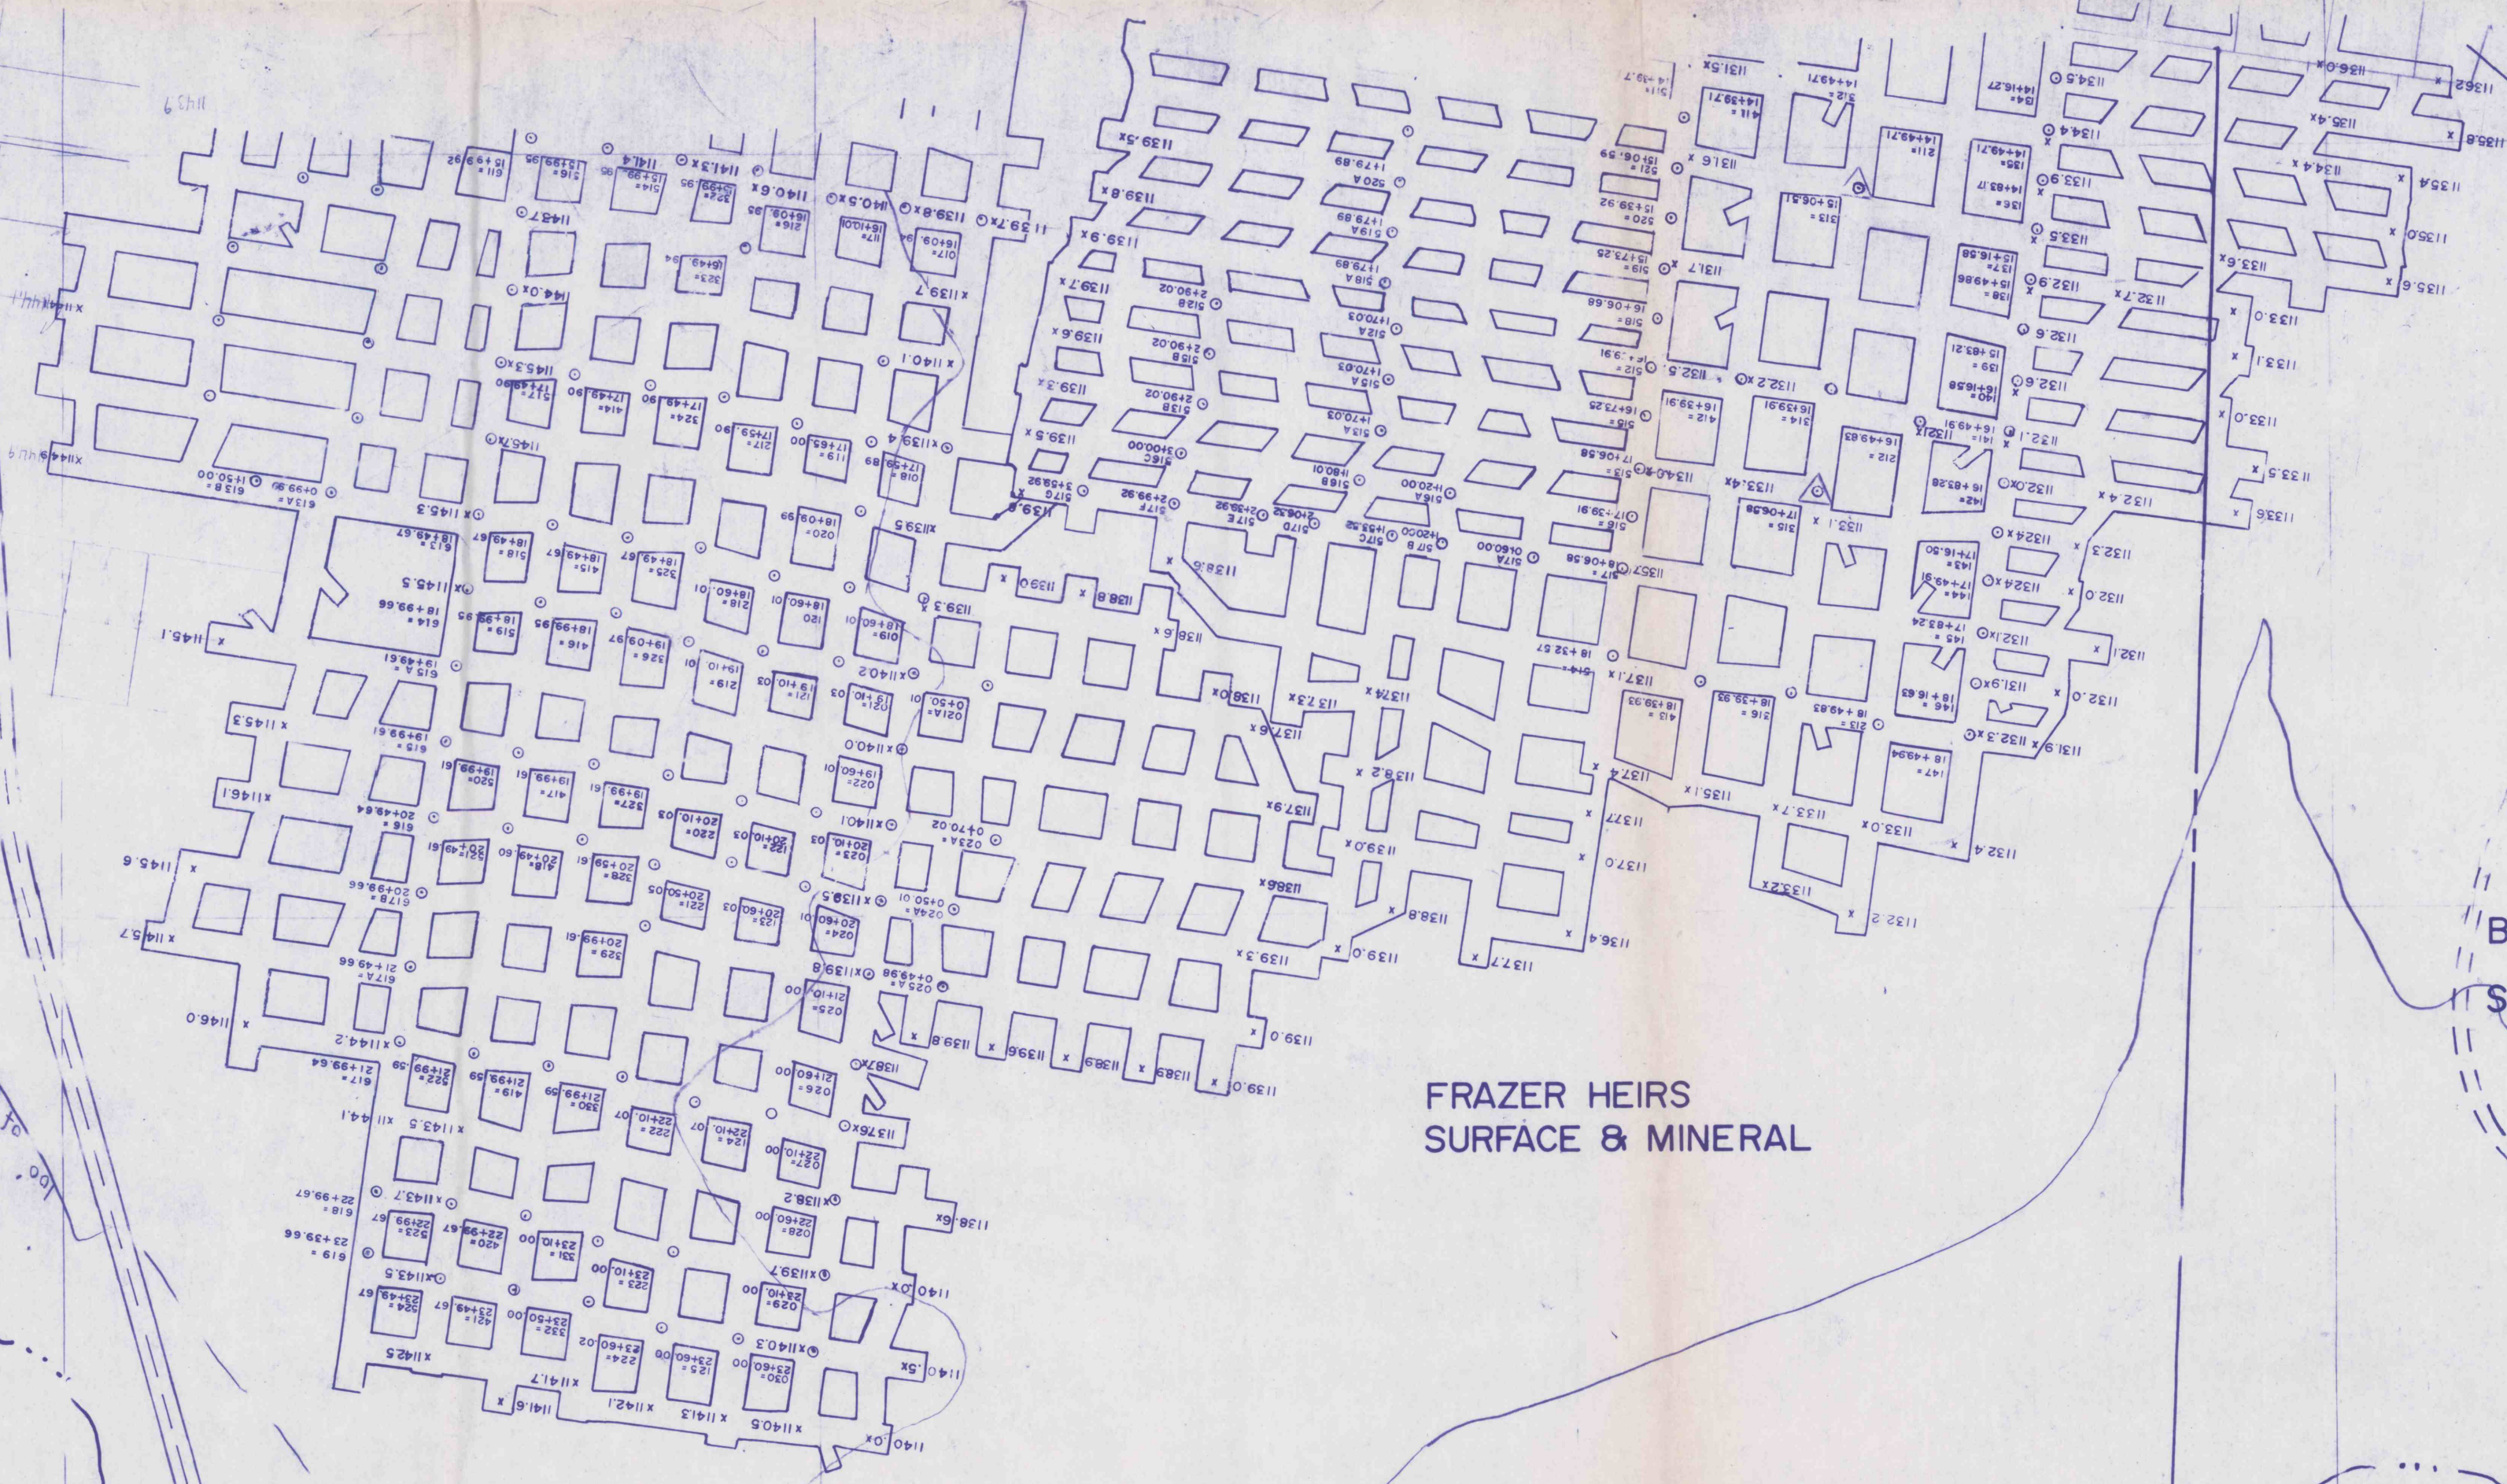

FRAZER HEIRS
SURFACE & MINERAL

BESSEMÉR & LAKE ERIE RAILROAD
SURFACE & MINERAL

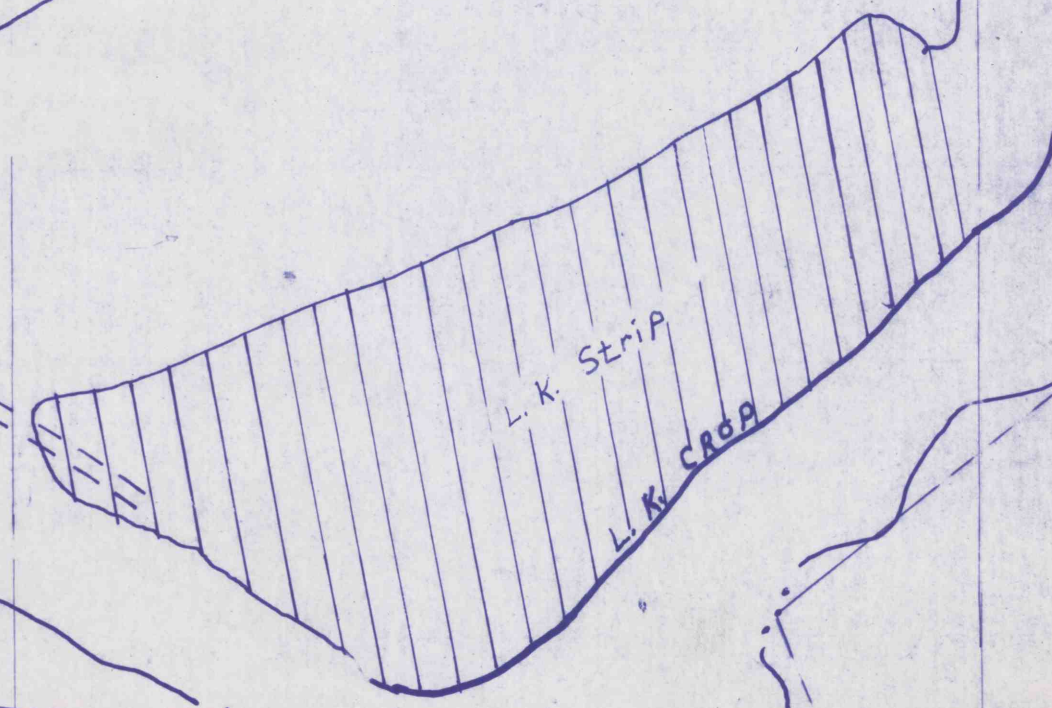

ROSEBUD MINING CO.
 ROSEBUD No. 1 MINE
 LOWER KITTANNING COAL SEAM
 PERRY TOWNSHIP ARMSTRONG COUNTY
 SCALE: 1" = 100'
 FINAL MAP as per survey of 4-28-87