




DANIEL EVANS

J. EDWARD WALLEY

DAVID W.  
EVANS HRS.

JOHN & BONNIE  
STANKOVICH

J. E. JONES

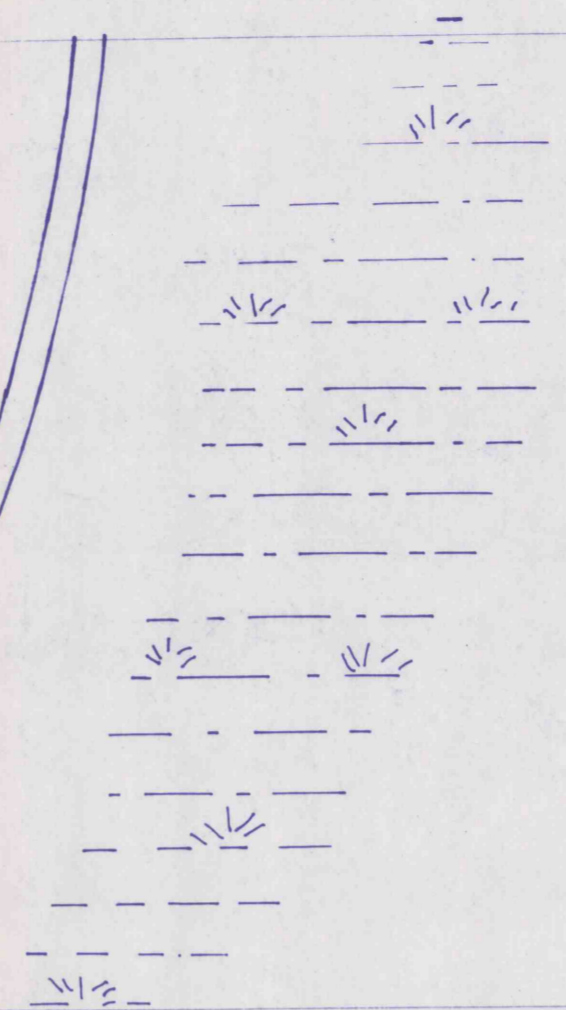

**ROSEBUD MINING CO.**  
ROSEBUD No. 1 MINE  
LOWER KITTANNING COAL SEAM  
PERRY TOWNSHIP ARMSTRONG COUNTY  
SCALE 1" = 100'  
FINAL MAP as per survey of 4-28-87

Dell Line Completed 9-16-83