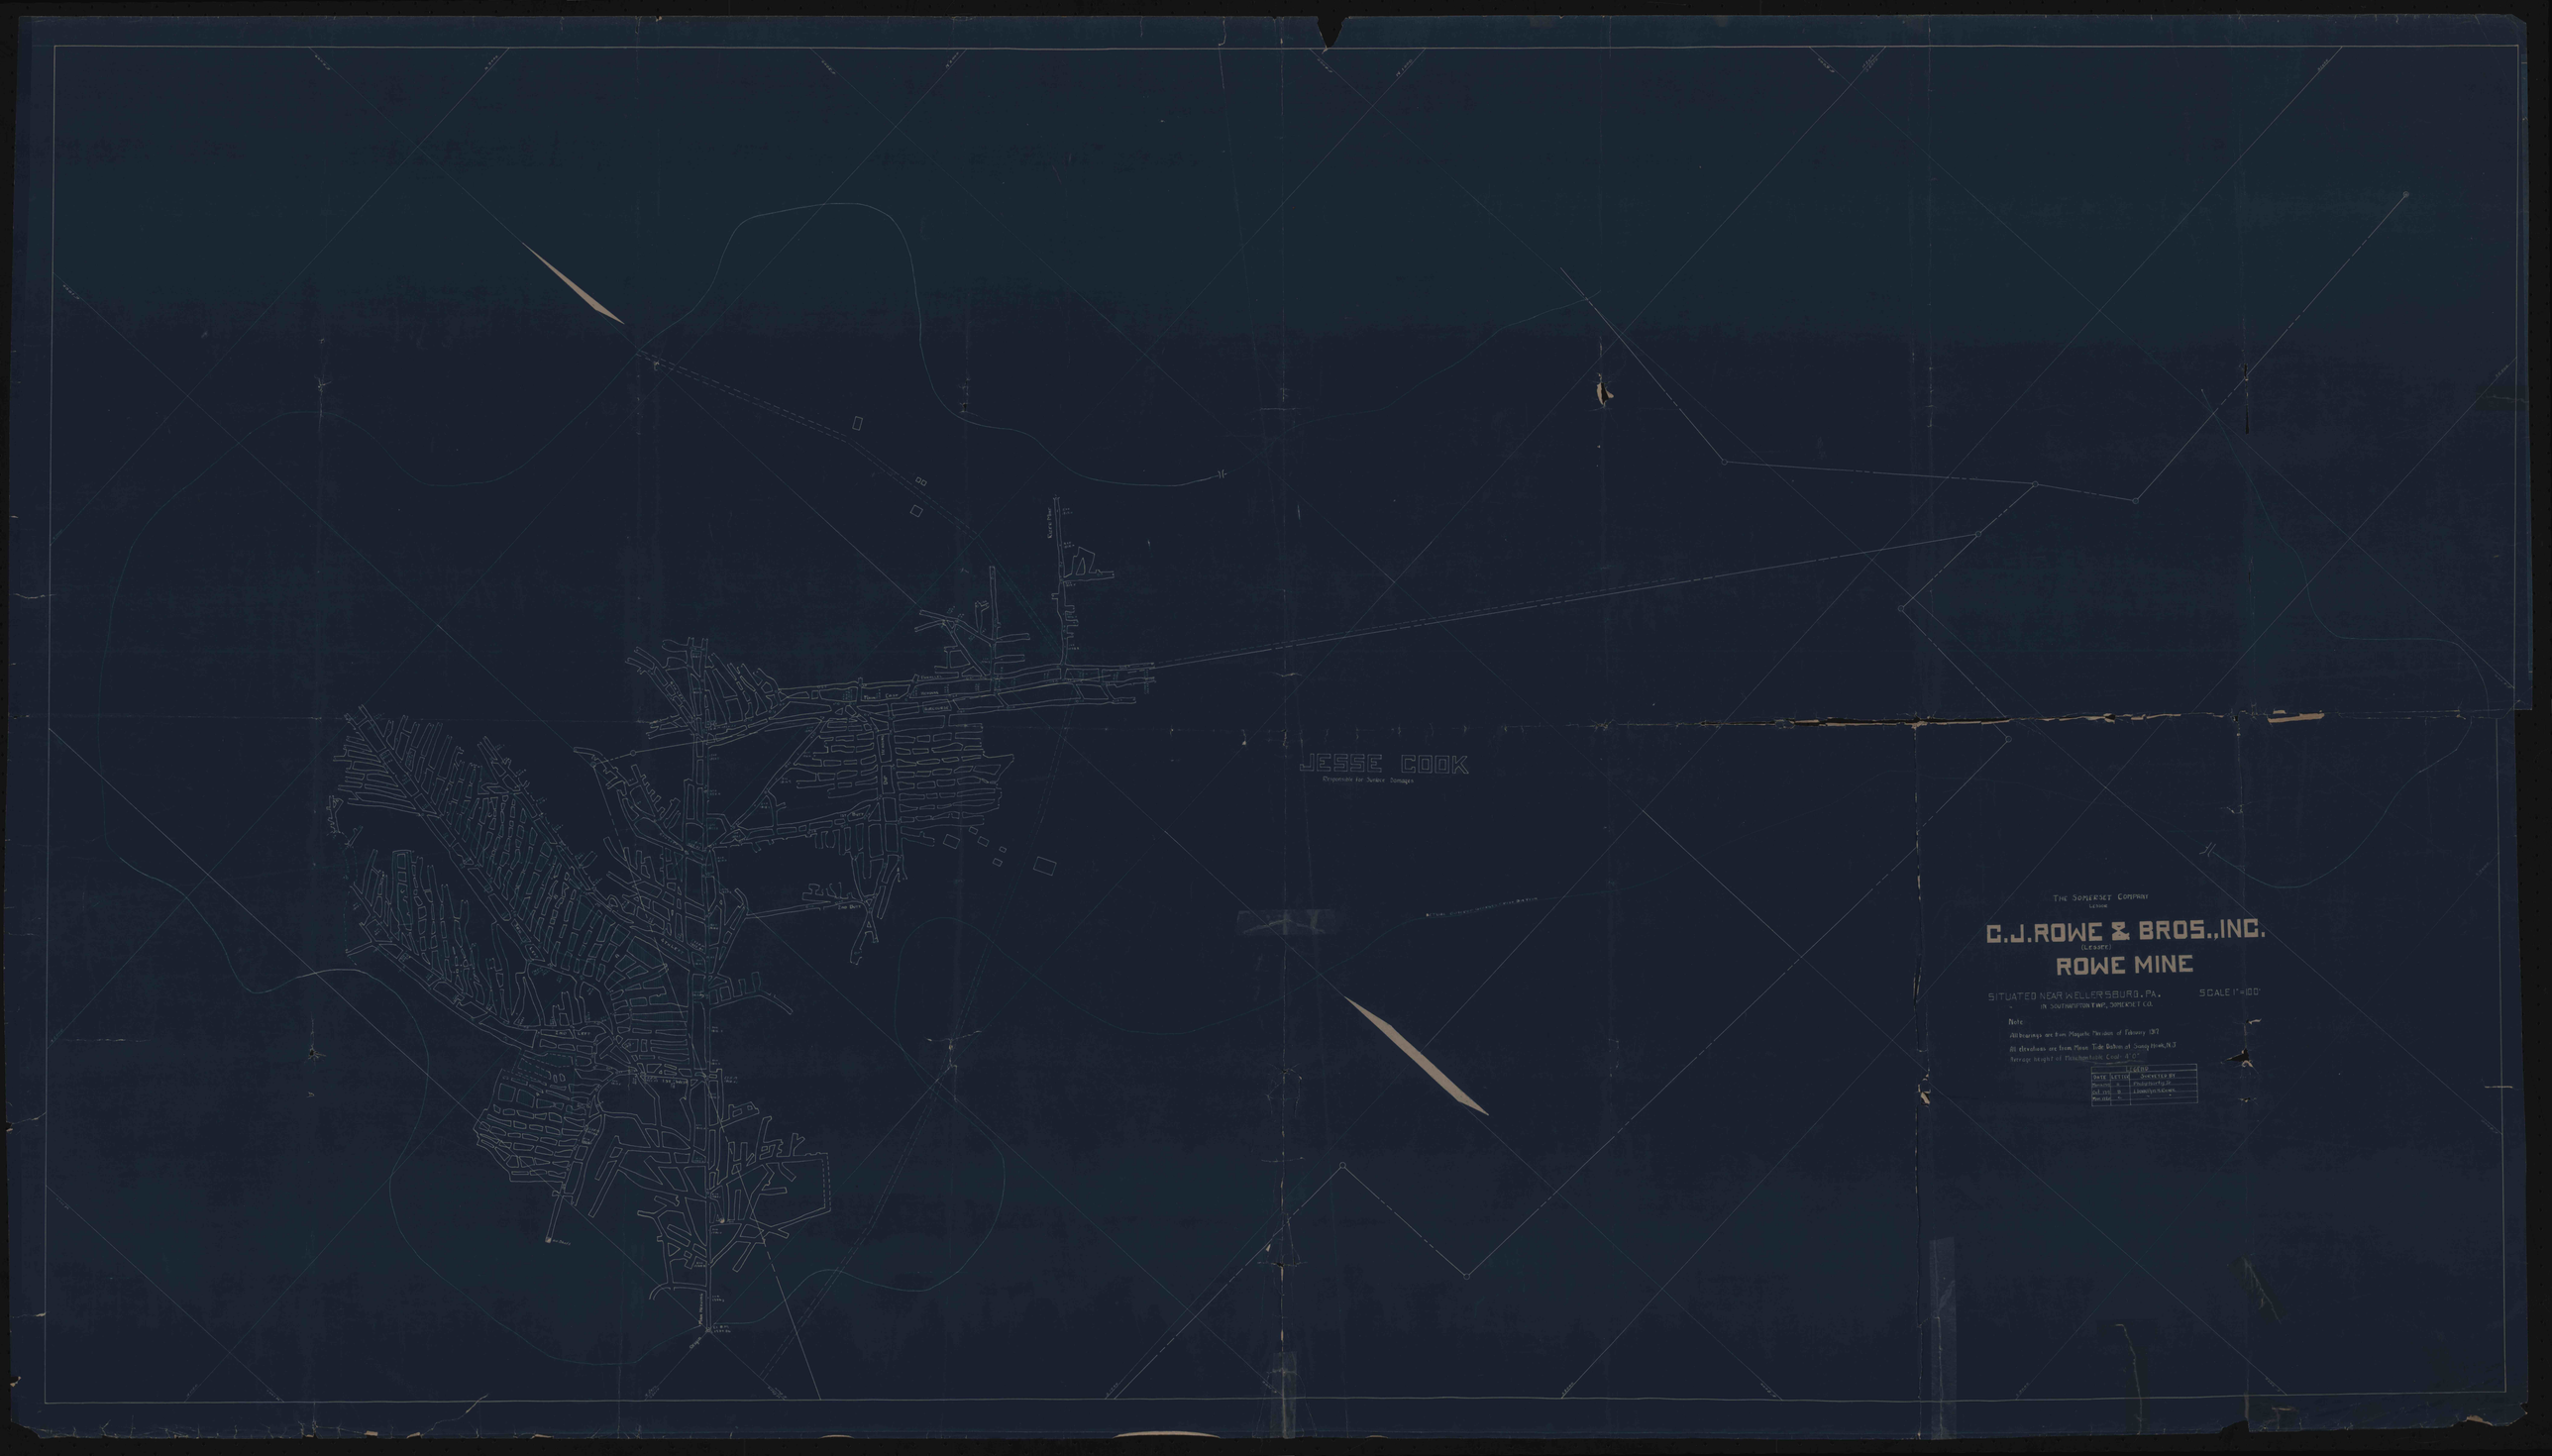
JESSE COOK
Responsible for Surface Damages
THE SOMERSET COMPANY
LESSEE
C.J.ROWE & BROS.,INC.
(LESSEE)
ROWE MINE
SITUATED NEAR WELLERSBURG, PA.
IN SOUTHAMPTON TWP., SOMERSET CO.
SCALE 1"=100'
Note
All bearings are from Magnetic Meridian of February 1917
All elevations are from Mean Tide Datum at Sandy Hook, N.J.
Average height of Meadowbrook Coal: 4'-0"
LEGEND
DATE LETTER SURVEYED BY
Surveyed A Photoplanetry Jr.
Oct. 1917 B Lowe/Van Kleeck
Mar. 1918 C