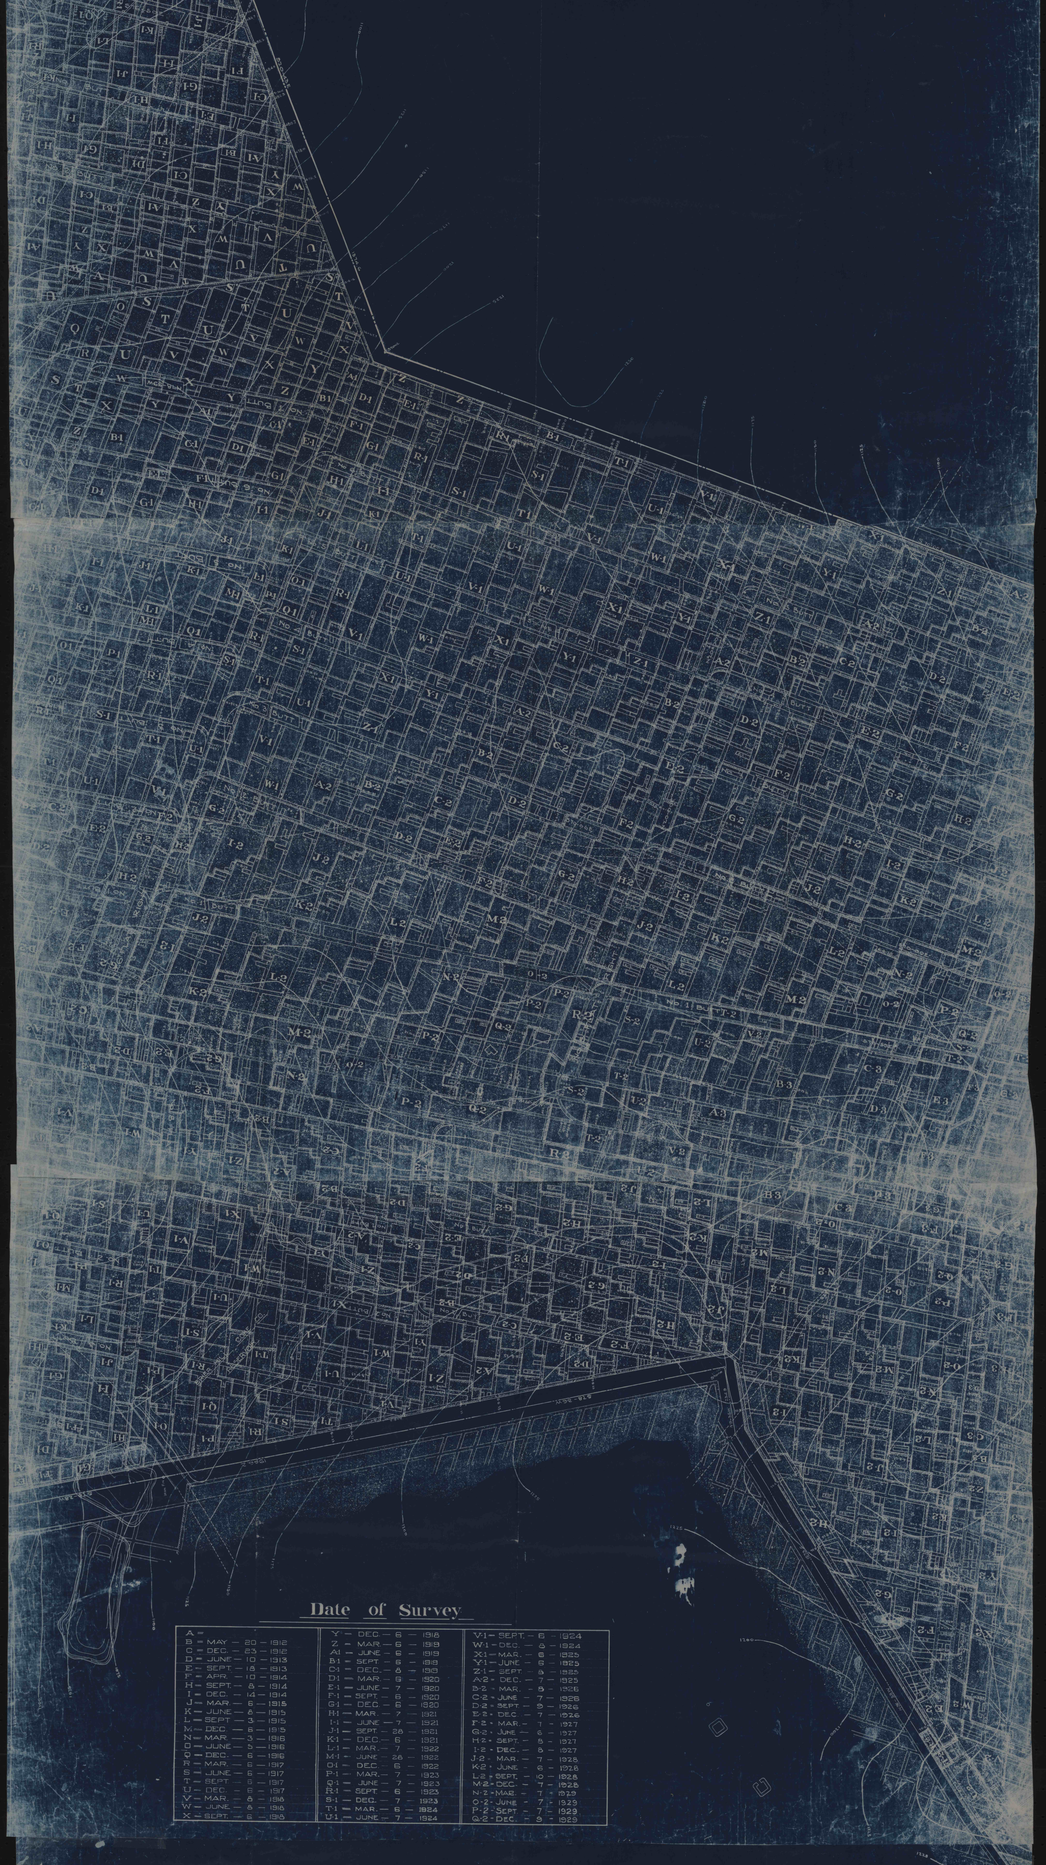

Date of Survey

A =	Y' — DEC. — 6 — 1918	V1 — SEPT. — 6 — 1924
B = MAY — 20 — 1912	Z — MAR. — 6 — 1918	W1 — DEC. — 5 — 1924
C = DEC. — 23 — 1912	A1 — JUNE — 6 — 1919	X1 — MAR. — 6 — 1925
D = JUNE — 10 — 1913	B1 — SEPT. — 8 — 1919	Y1 — JUNE — 5 — 1925
E — SEPT. — 18 — 1913	C1 — DEC. — 8 — 1919	Z1 — SEPT. — 5 — 1925
F = APR. — 10 — 1914	D1 — MAR. — 9 — 1920	A2 — DEC. — 7 — 1925
H = SEPT. — 8 — 1914	E1 — JUNE — 7 — 1920	B2 — MAR. — 5 — 1926
I = DEC. — 14 — 1914	F1 — SEPT. — 6 — 1920	C2 — JUNE — 7 — 1926
J = MAR — 6 — 1915	G1 — DEC. — 6 — 1920	D2 — SEPT. — 5 — 1926
K = JUNE — 6 — 1915	H1 — MAR. — 7 — 1921	E2 — DEC. — 7 — 1926
L = SEPT — 3 — 1915	I1 — JUNE — 7 — 1921	F2 — MAR. — 7 — 1927
M = DEC — 6 — 1915	J1 — SEPT — 26 — 1921	G2 — JUNE — 6 — 1927
N = MAR — 3 — 1916	K1 — DEC. — 6 — 1921	H2 — SEPT. — 5 — 1927
O = JUNE — 5 — 1916	L1 — MAR. — 7 — 1922	I2 — DEC. — 5 — 1927
Q = DEC. — 6 — 1916	M1 — JUNE — 26 — 1922	J2 — MAR. — 7 — 1928
N = MAR. — 5 — 1917	O1 — DEC. — 6 — 1922	K2 — JUNE — 6 — 1928
S = JUNE — 5 — 1917	P1 — MAR. — 7 — 1923	L2 — SEPT. — 0 — 1926
T — SEPT — 5 — 1917	Q1 — JUNE — 7 — 1923	M2 — DEC. — 7 — 1928
U — DEC. — 5 — 1917	R1 — SEPT — 6 — 1923	N2 — MAR. — 7 — 1929
V — MAR. — 5 — 1918	S1 — DEC. — 7 — 1923	O2 — JUNE — 7 — 1929
W — JUNE — 5 — 1918	T1 — MAR. — 6 — 1924	P2 — SEPT — 7 — 1929
X — SEPT — 5 — 1918	U1 — JUNE — 7 — 1924	Q2 — DEC. — 3 — 1929

MAP OF
ROYAL MINE
BELONGING TO
W. J. RAINEY
REDSTONE & MENALLEN TWPS.
FAYETTE CO., PA.

Scale — 1 in. = 100 ft.

1913

W. J. RAINEY, INC.
GRANT BUILDING
PITTSBURGH, PA.

In compliance with Section 4 of Article II of the Pennsylvania Bituminous Mining Law, I, R. L. Affolter, Vice President of the W. J. Rainey, Inc., of Pittsburgh, Penna., do hereby certify as follows:

1. Royal Mine of the above named Company, which is located in Luzerne Township, Fayette County, Penna., was permanently abandoned on September 27, 1941. The shafts and bore hole openings have been sealed and vented.

2. The 100' scale blue print of the Royal Mine map, to which this affidavit is attached and made a part thereof, is a true and correct copy of the original. Also map and shows the abandoned mine and the mine workings as of September 27, 1941.

W. J. RAINEY, INC.
By [signature]
Vice President

COMMONWEALTH OF PENNSYLVANIA
COUNTY OF ALLEGHENY

Sworn to and subscribed before me this 11th day of November, 1941.

[signature]
Notary Public

My Commission Expires
APRIL 24, 1945