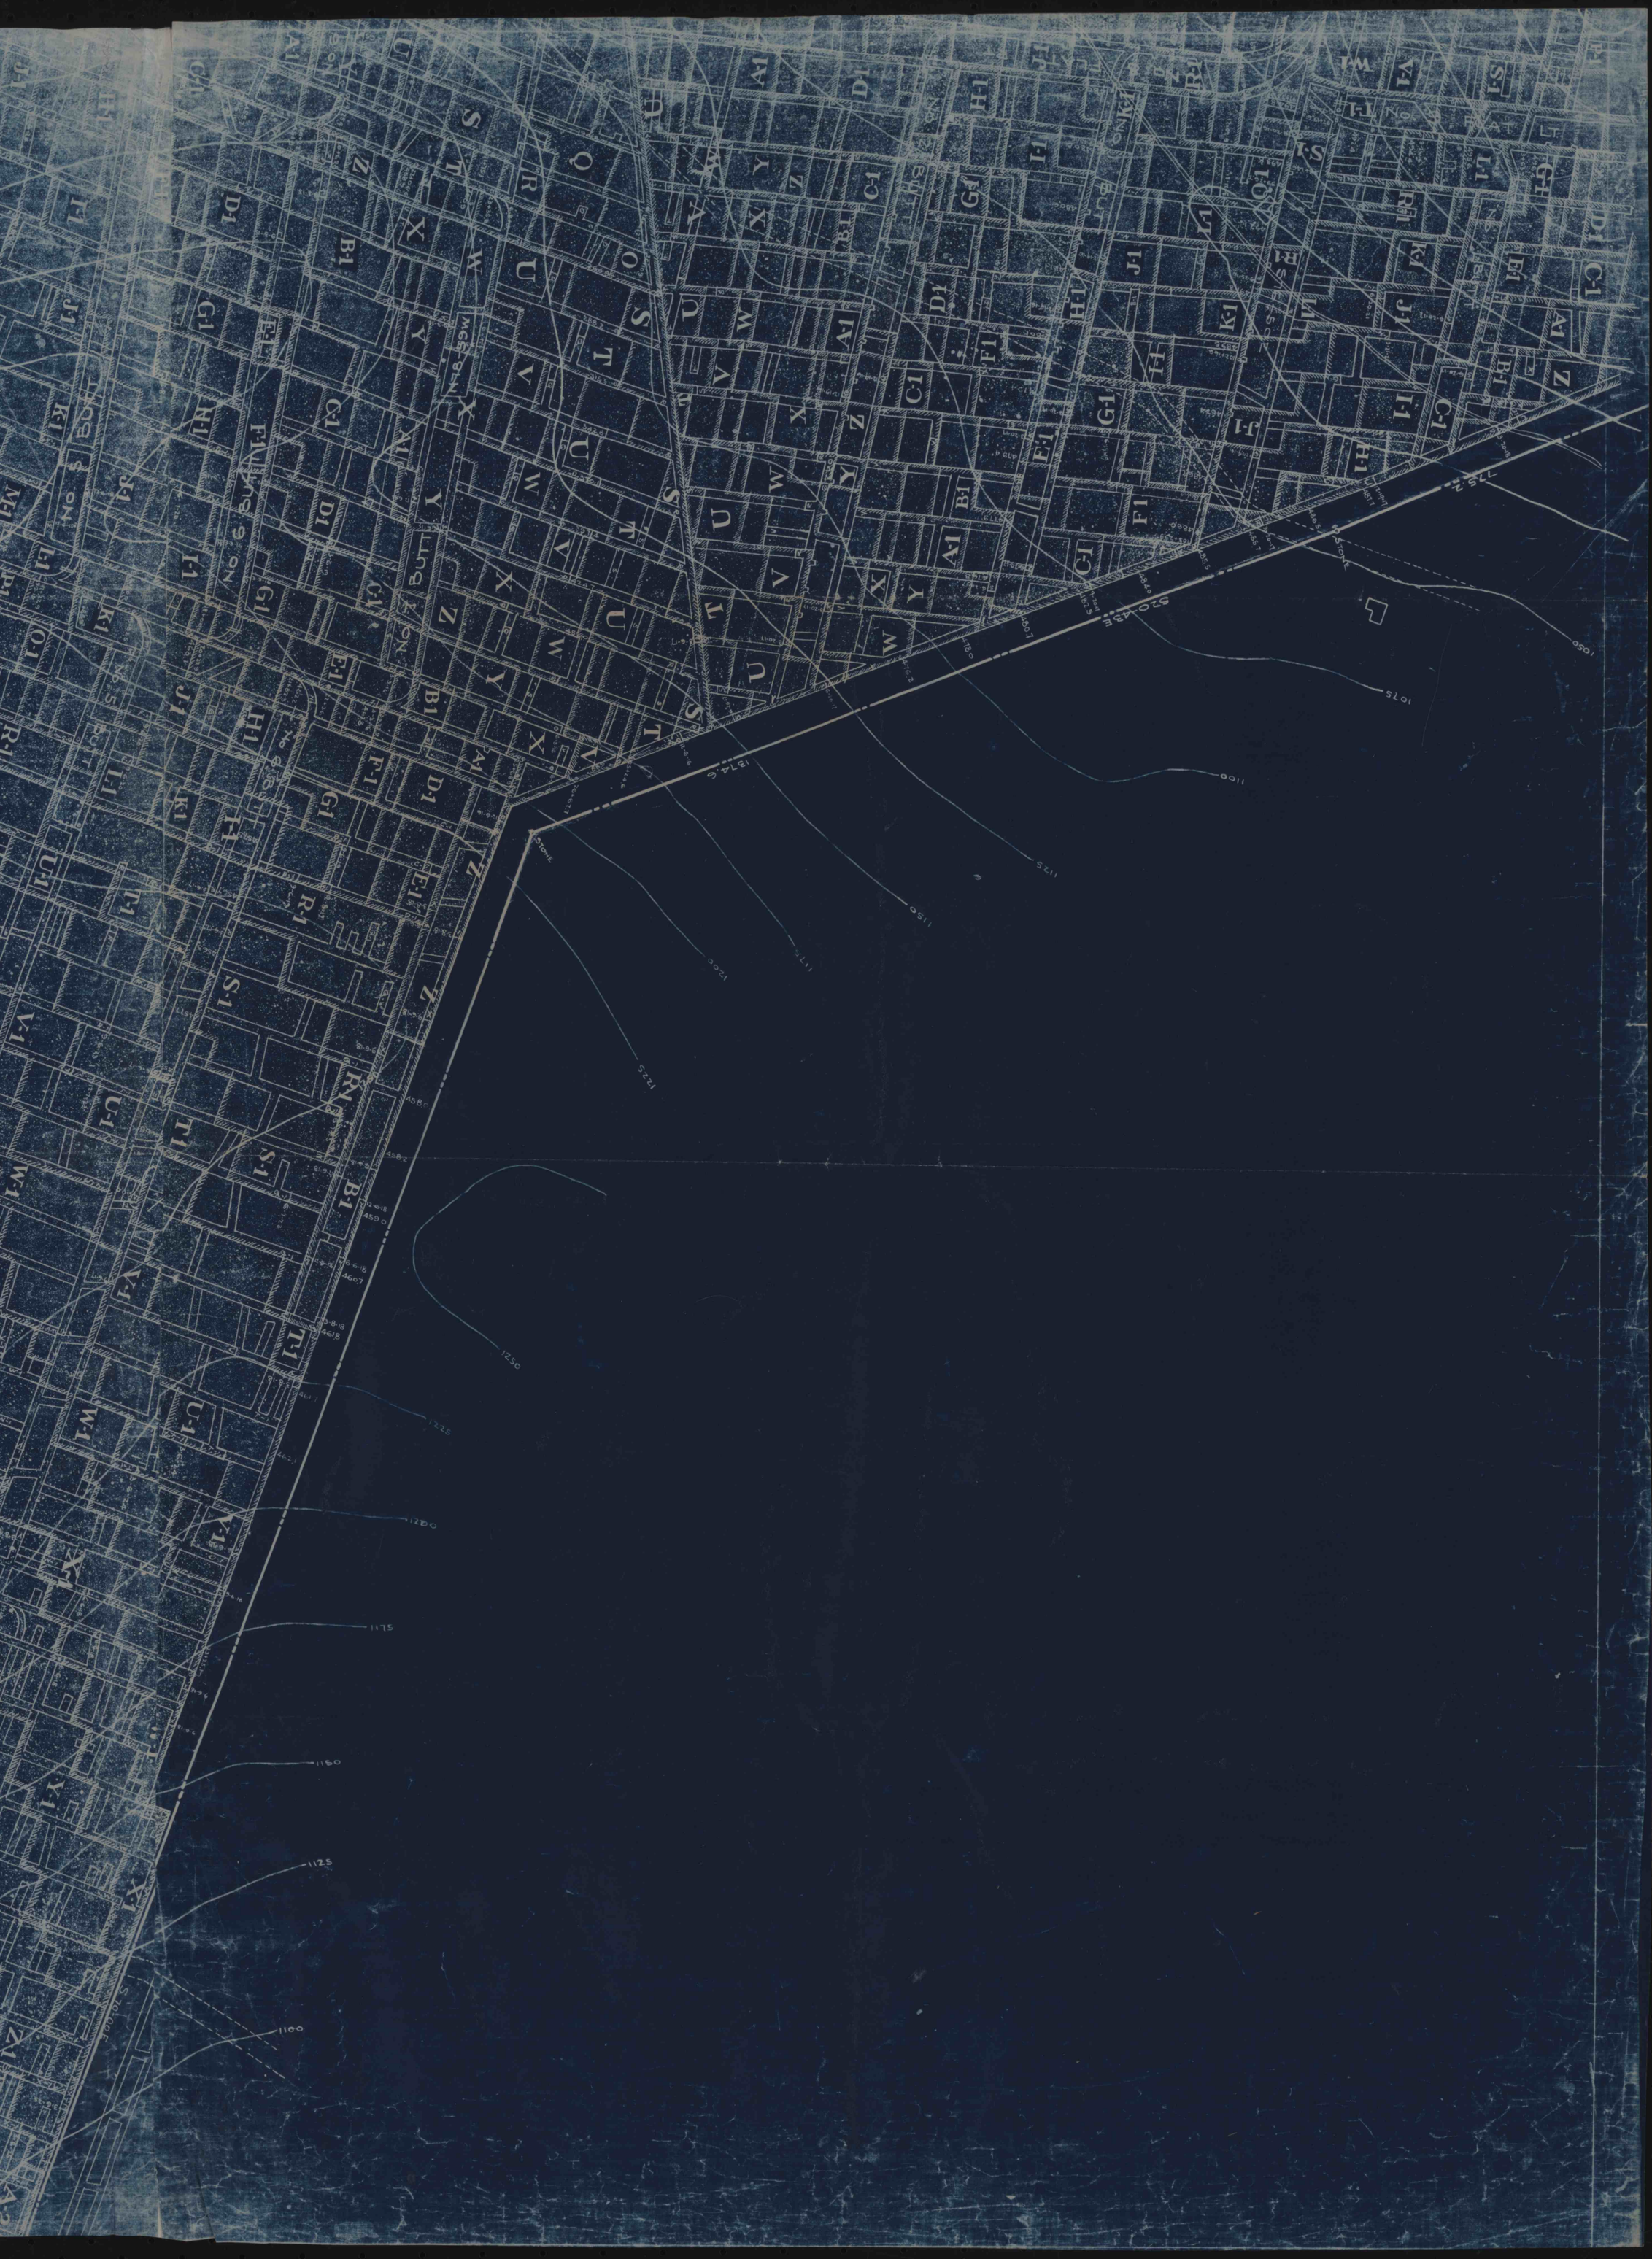
Z
Y
X
W
V
U
T
S
R
Q
O
A1
B1
C1
D1
E1
F1
G1
H1
J1
K1
L1
M1
R1
S1
T1
U1
V1
W1
X1
Y1
Z1
Z2
Butt
Pl
Stone
1374.6
1100
1075
1050
1025
1000
975
950
925
900
875
850
825
800
775
752
725
700
675
650
625
600
575
550
525
500
475
450
425
400
375
350
325
300
275
250
225
200
175
150
125
100
75
50
25
0