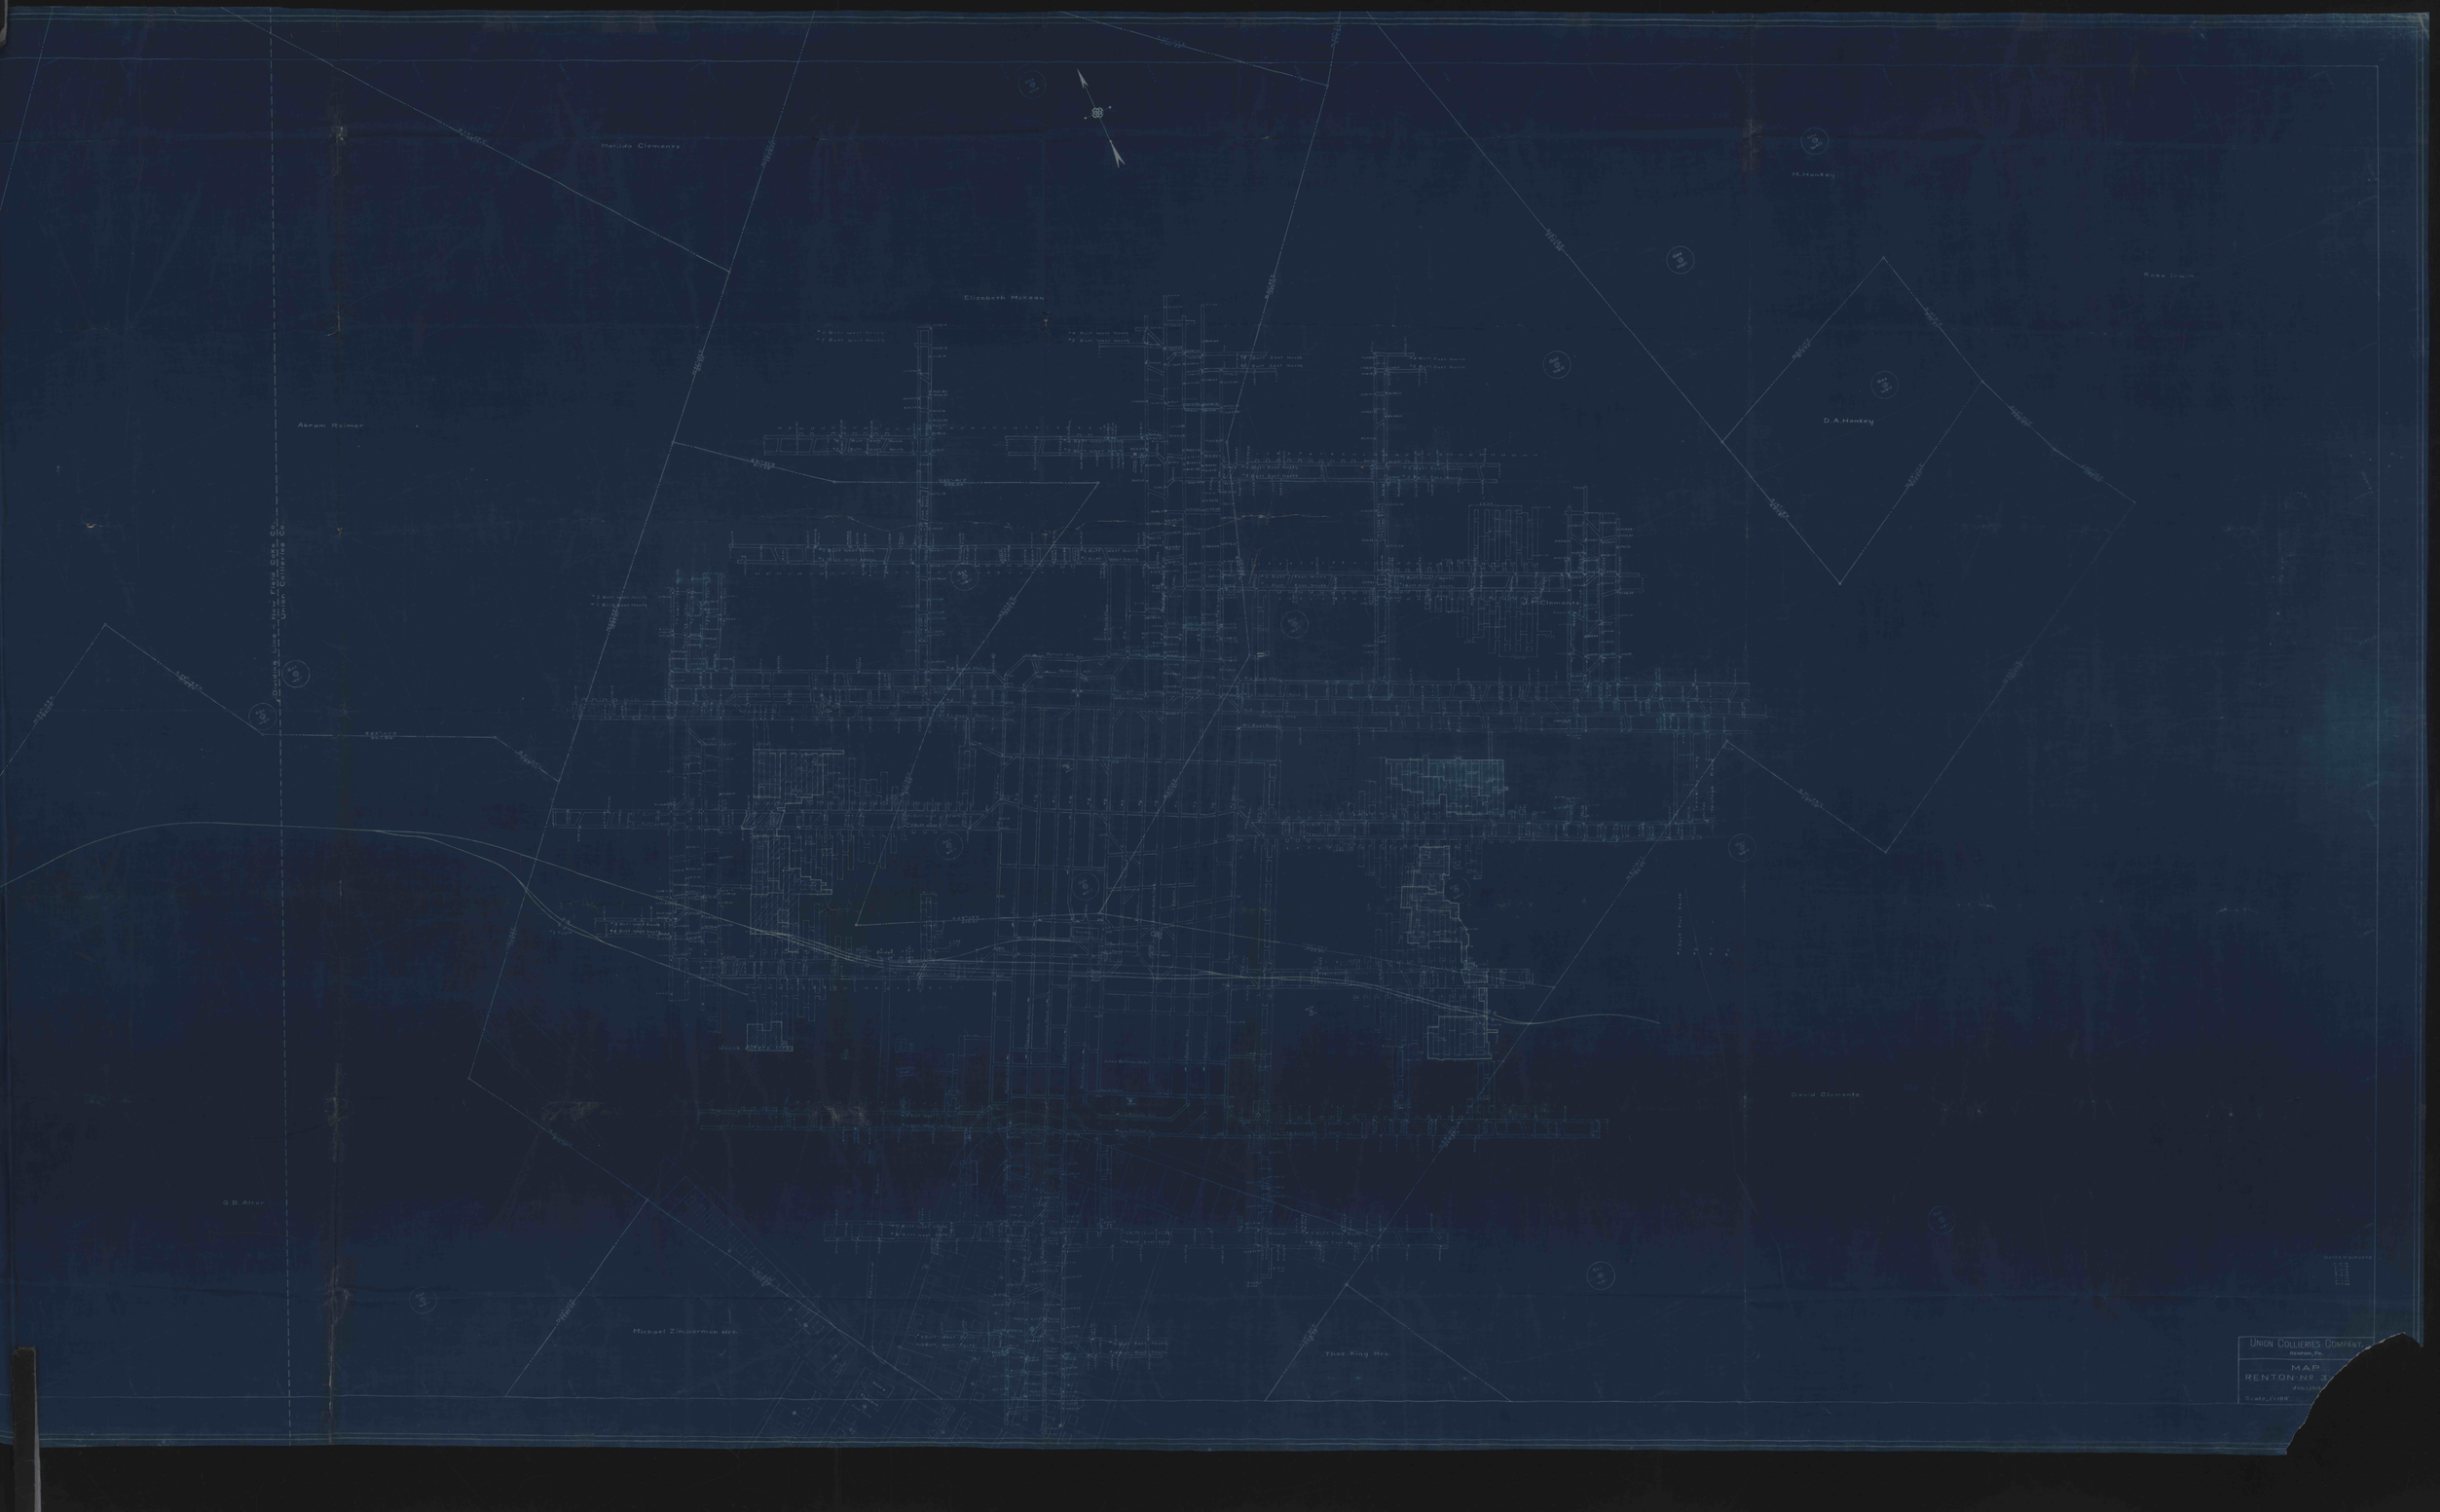
Matilda Clemants
Elizabeth Hobson
M. Hankey
D.A. Hankey
Abram Reimer
Douglas Add. - Now Free Gas Co.
Union Collieries Co.
G.B. Alter
Michael Zimmerman Hrs.
Thos King Hrs.
David Clements
UNION COLLIERIES COMPANY
MAP
RENTON-No 3