



COAL AREA 118,214 ACRES

COAL AREA 44,724

DATE OF SURVEY.
 Nov. 4, 1919 = A.
 APR. 30, 1920 = B.


SUMMARY

SURFACE AREA	495.1 A.
COAL AREA	118,214 A.
" "	44,724 A.
TOTAL COAL AREA	162,938 A.
COAL MINED TO NOV. 4, 1919	4,935 A.
NET COAL AREA NOV. 4, 1919	158,003 A.

PITTSBURGH VEIN OF COAL
 AVERAGE THICKNESS OF VEIN = 31 INCHES

PENNA-PITTSBURGH COAL & COKE CO.

— SITUATE IN —
 MONONGAHELA TOWNSHIP, GREENE CO., PA.
 SCALE: 1"=100' OCT. 18, 1912.

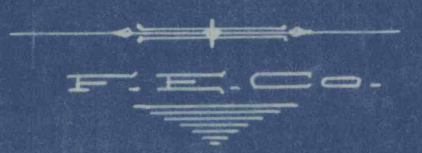

SEVENTH POOL COAL CO.

MONONGAHELA RIVER.

Rosemary Mine.

TENEMENT HOUSES.

PUBLIC ROAD.

PROPERTY LINE

N