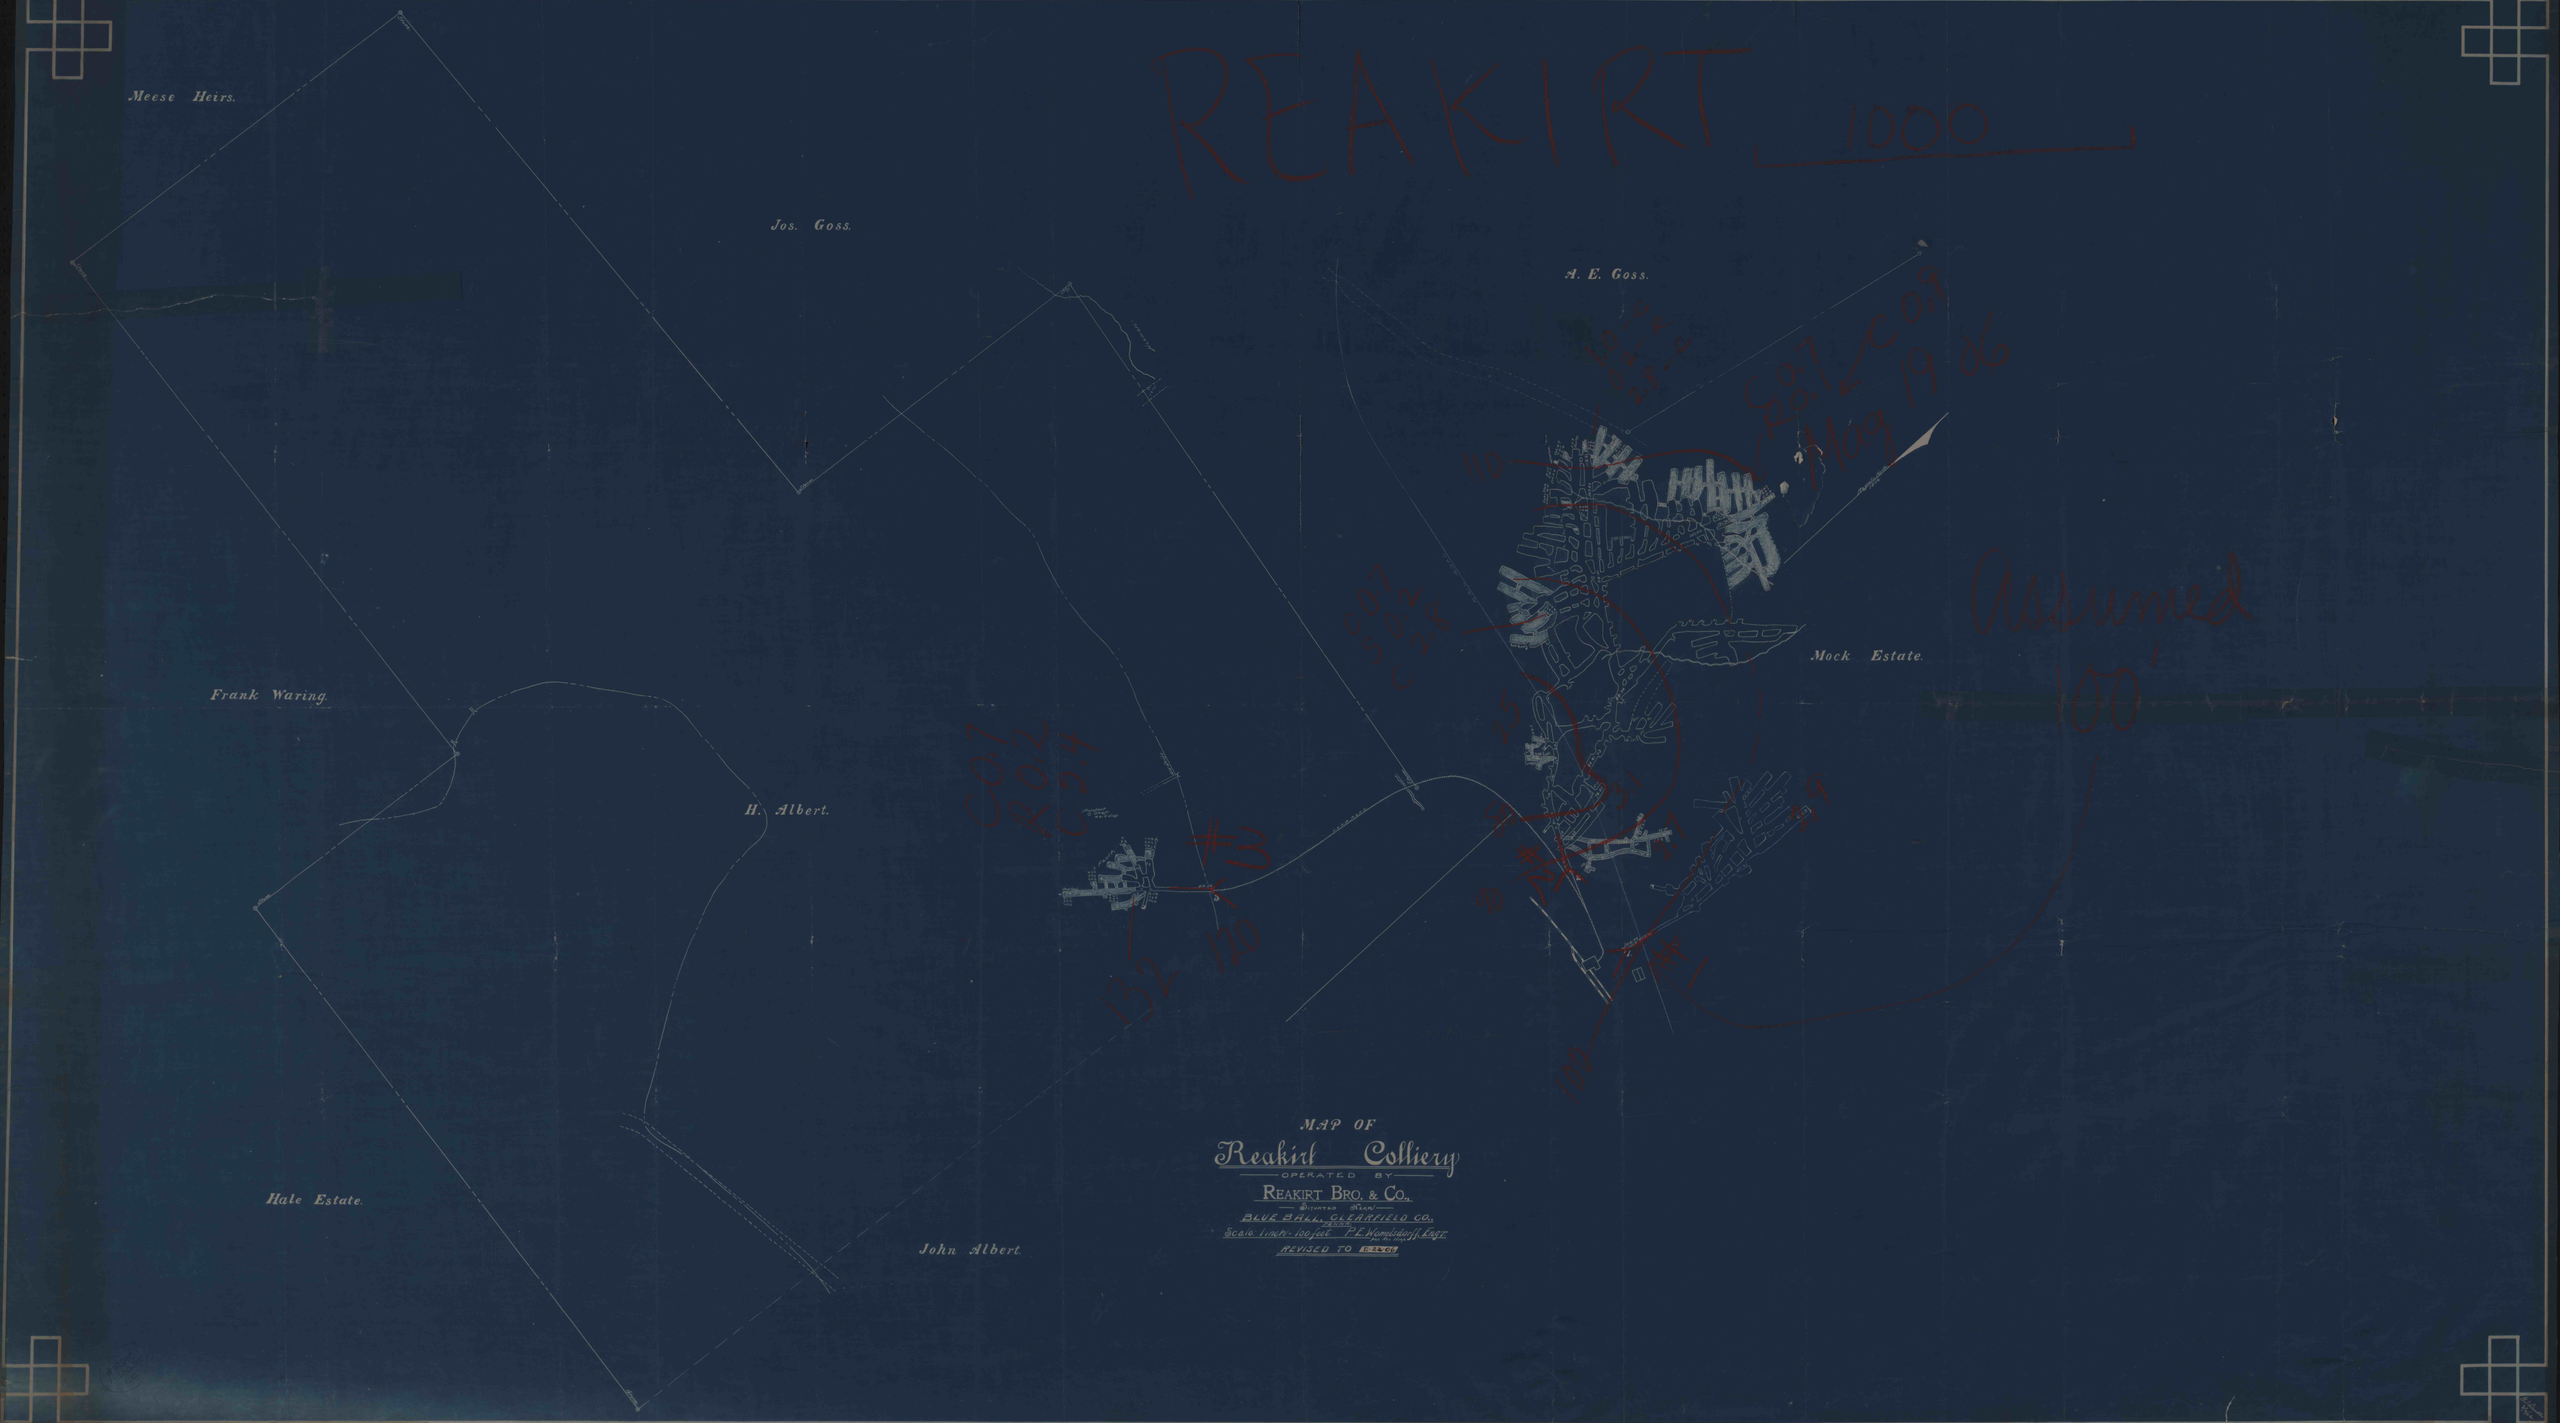
REAKIRT 1000
Meese Heirs.
Jos. Goss.
A. E. Goss.
Frank Waring.
H. Albert.
Mock Estate.
Hale Estate.
John Albert.
Assumed 100'
#3
MAP OF
Reakirt Colliery
OPERATED BY
REAKIRT BRO. & CO.,
SITUATED NEAR
BLUE BALL, CLEARFIELD CO.,
PENNA.
Scale: 1 inch = 100 feet P.E. Womelsdorff, Engr.
REVISED TO