


SURVEY NOTES 2-10-1967

STA. 2-3	N 23° 45' W
" 3-4	N 30° 16' W
" 4-5	N 60° 47' W
" 5-6	N 73° 05' W
" 6-8	N 58° 42' W
" 8-9	S 74° 30' W
" 9-10	S 51° 30' W
" 12-13	N 29° 38' E

- LEGEND**
- 28A PROPERTY OUTLINE
 - 12A LIMIT OF COAL TO BE MINED
 - PROPOSED 6 MONTHS PROJECTIONS 3-28-1969 TO 9-4-1969
 - WORKED OUT 9-4-68-3-28-69 1ST. 6 Mo. REPORT

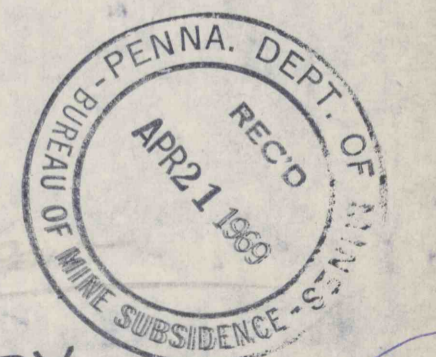

FIELD COPY
 PROPERTY MAP
 S. & R. COAL COMPANY No. 3 MINE
 FORMERLY
 FRENCO COAL COMPANY, No. 3 MINE
 UPPER FREEPORT (E) COAL SEAM
 MONTGOMERY TWP, INDIANA COUNTY, PA.
 SURVEY & MAP T. HOWARTH 2-10-1967
 SCALE: 1"=100' DIRECTED BY A. K. BLOOM, P.E.
 REVISED: 8-10-67-9-4-68, 3-28-69

#2402
 1-12-2000
 C.C.

SEAL