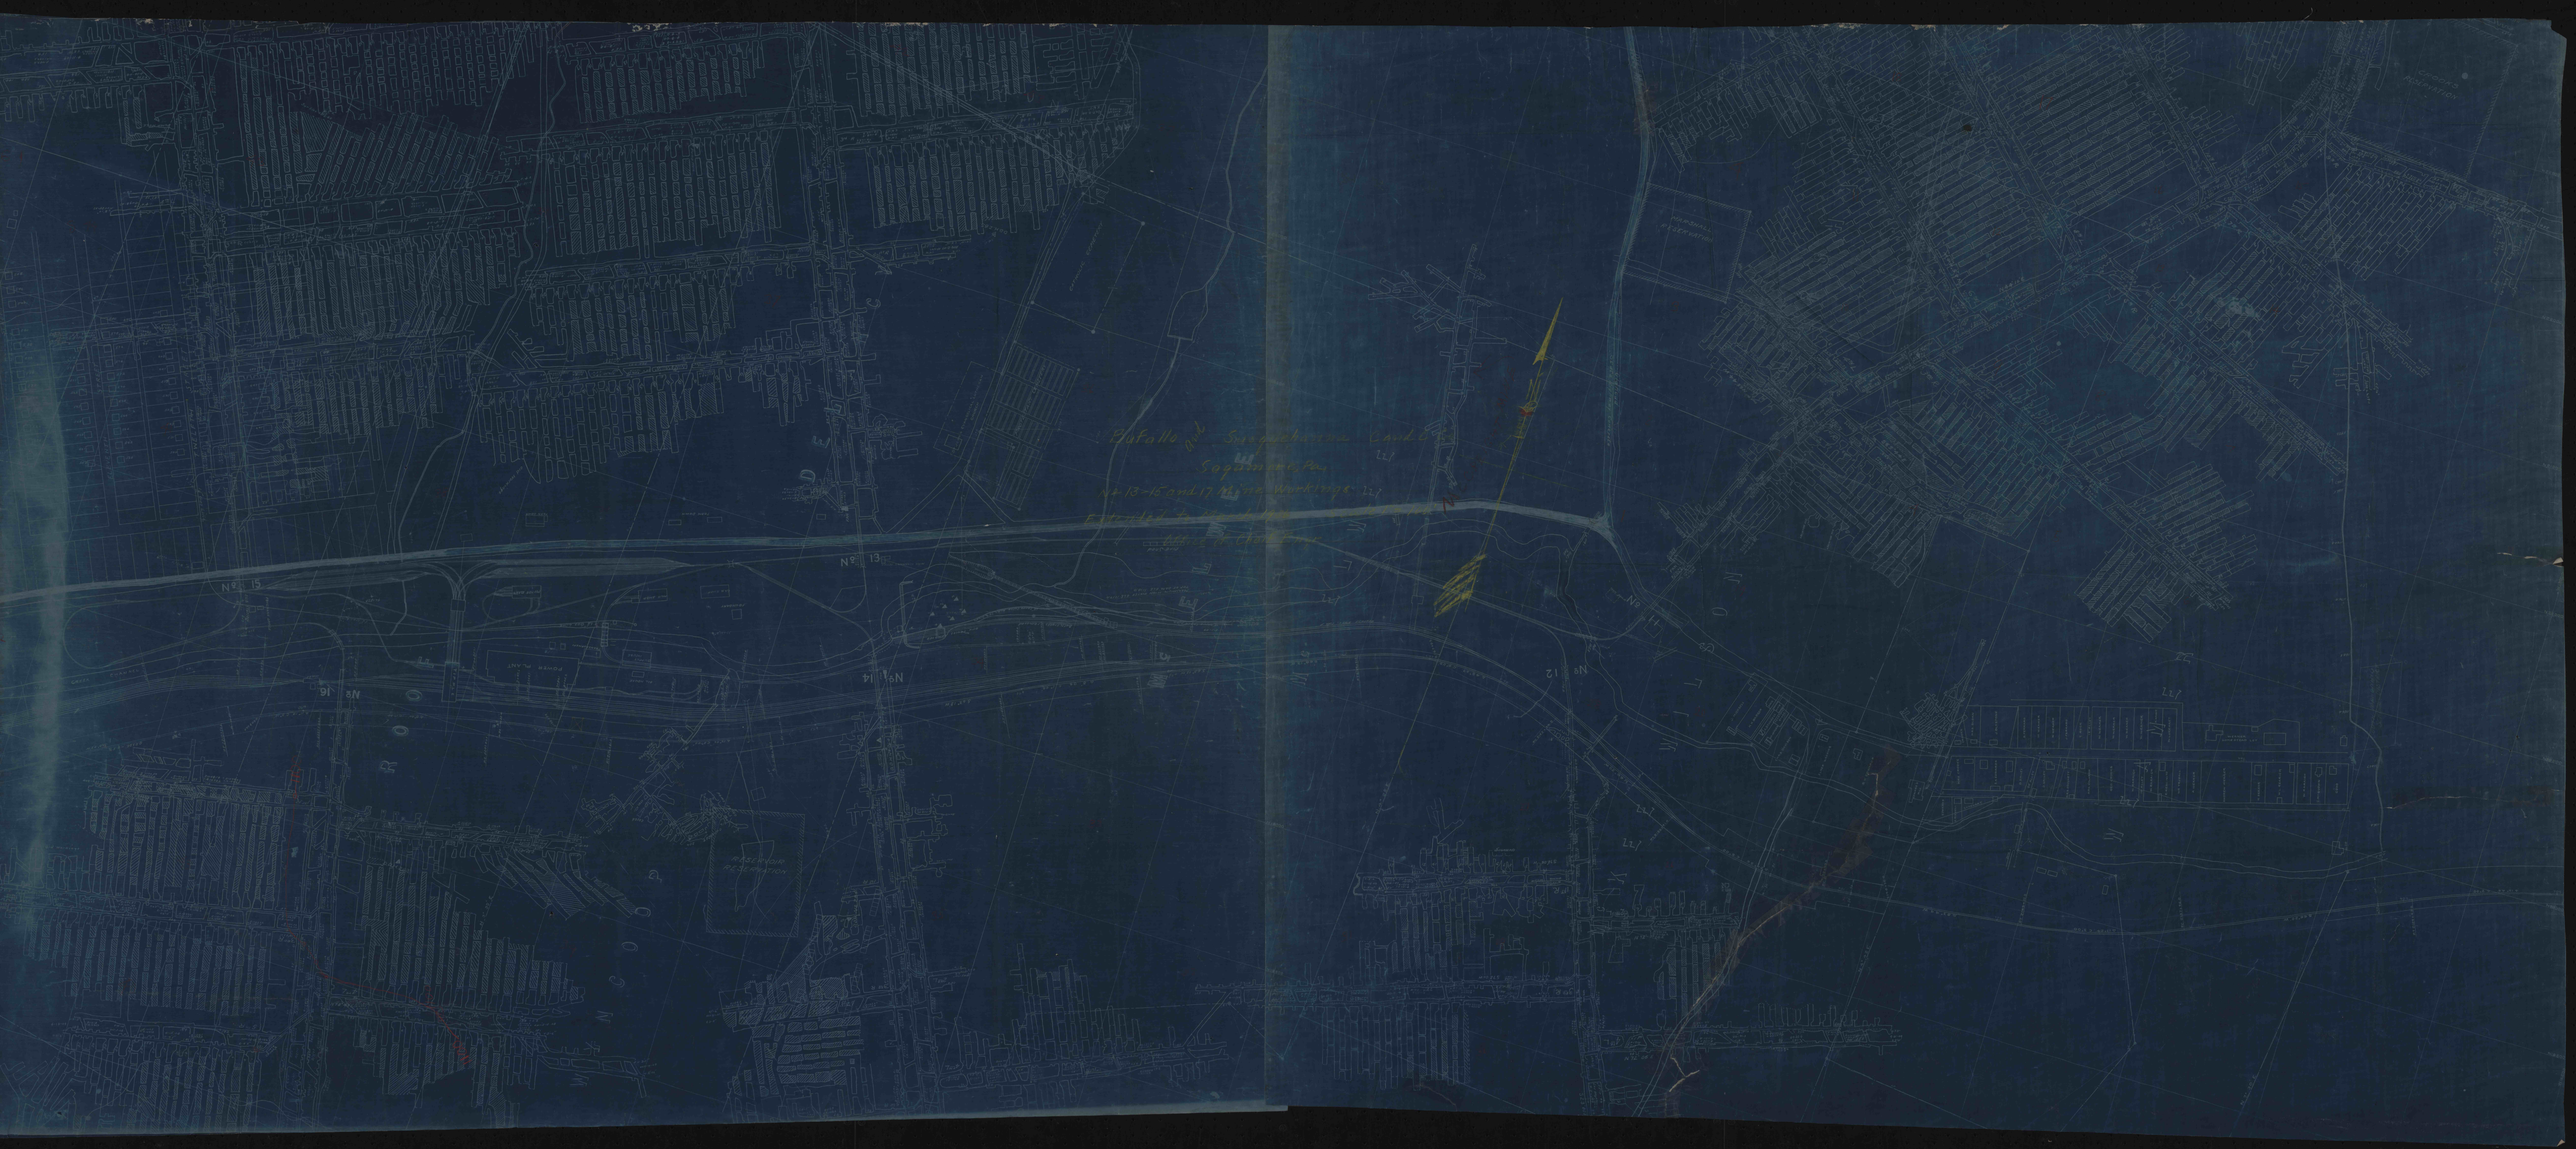
No. 15
No. 13
No. 14
No. 16
No. 12
No. 11
No. 17
POWER PLANT
PASSENGER STATION