

R.L. NAIL  
50 ac.  
1872


*James Young*  
12/18/66

GEO. & DALE YOUNG  
50 ac.

J.P. BLAUSER HRS

J. MARSHALL  
100 ac.

G. YOUNG

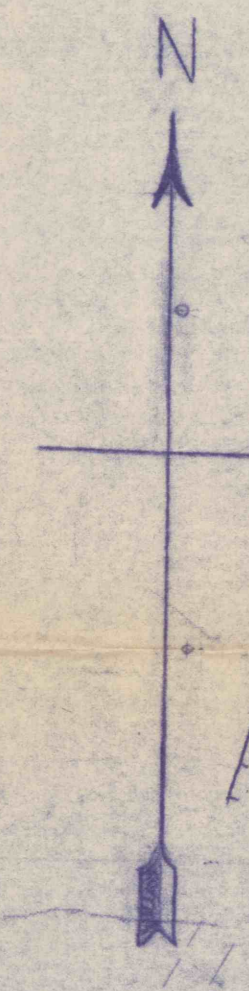

LEGEND

E. J. WEIBEL	11/10/57
A. J. LUCAS	5/10/58
A. J. LUCAS	7/10/61
W. J. LUCAS	11/10/63
D.H. WILSON	1/10/64
D.H. WILSON	12/10/64


SCALE 1 INCH = 100 FEET

(Brookville Seam) Salt City  
To Freedom To Mahan

**SALT CITY MINING CO., INC.**  
**NO. 1 - MINE**  
**ALLEGHENY TWP. BUTLER CO. PA**

DATE May 10, 1966  
DATE Dec 10, 1966

SIX MONTHS PROJECTION  
JAN. 1 - THRU JUNE 30, 1966

 - MINING AFTER APRIL 27, 1966 TO DEC. 10, 1966

