
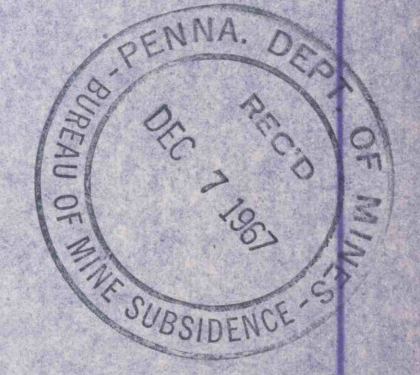


MINING COMPLETED


6 MOS PROTECTED


 LEASE LINE
 MINING COMPLETED
 6 MOS. PROTECTION
 11-29-67 to 5-29-68



C. Vance Dei Cas

DRAWN	RBM	11/29/66
CHECKED		
APPROVED		
REVISIONS		

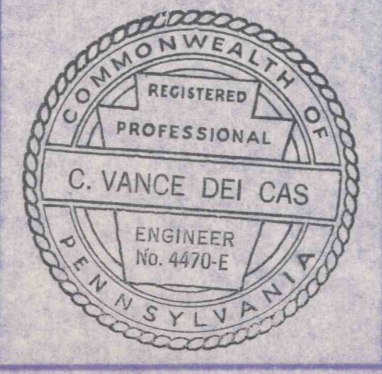

SANA MINE

MCDONALD ASSOCIATES ENGINEERING
CHARLEROI, PA.

SCALE 1" = 100'
JOB 1532
SHEET No. 1

F
NB
T-30

#0416
1-12-2000
C.C.