








- LEGEND**
-  "E" MIN. BOUNDARY
 -  LIMIT OF MINE
 -  MINING COMPLETE
 -  AREA 6 MOS. MINING 10-20-72 to 4-20-73



TRACED FROM MAP BY ELY & FRENCH (PREVIOUS SUBMISSION)
 REVISED & CORRECTED LIMIT OF MINE & MINED OUT AREAS
 SCALE 1" = 200' 9-26-66

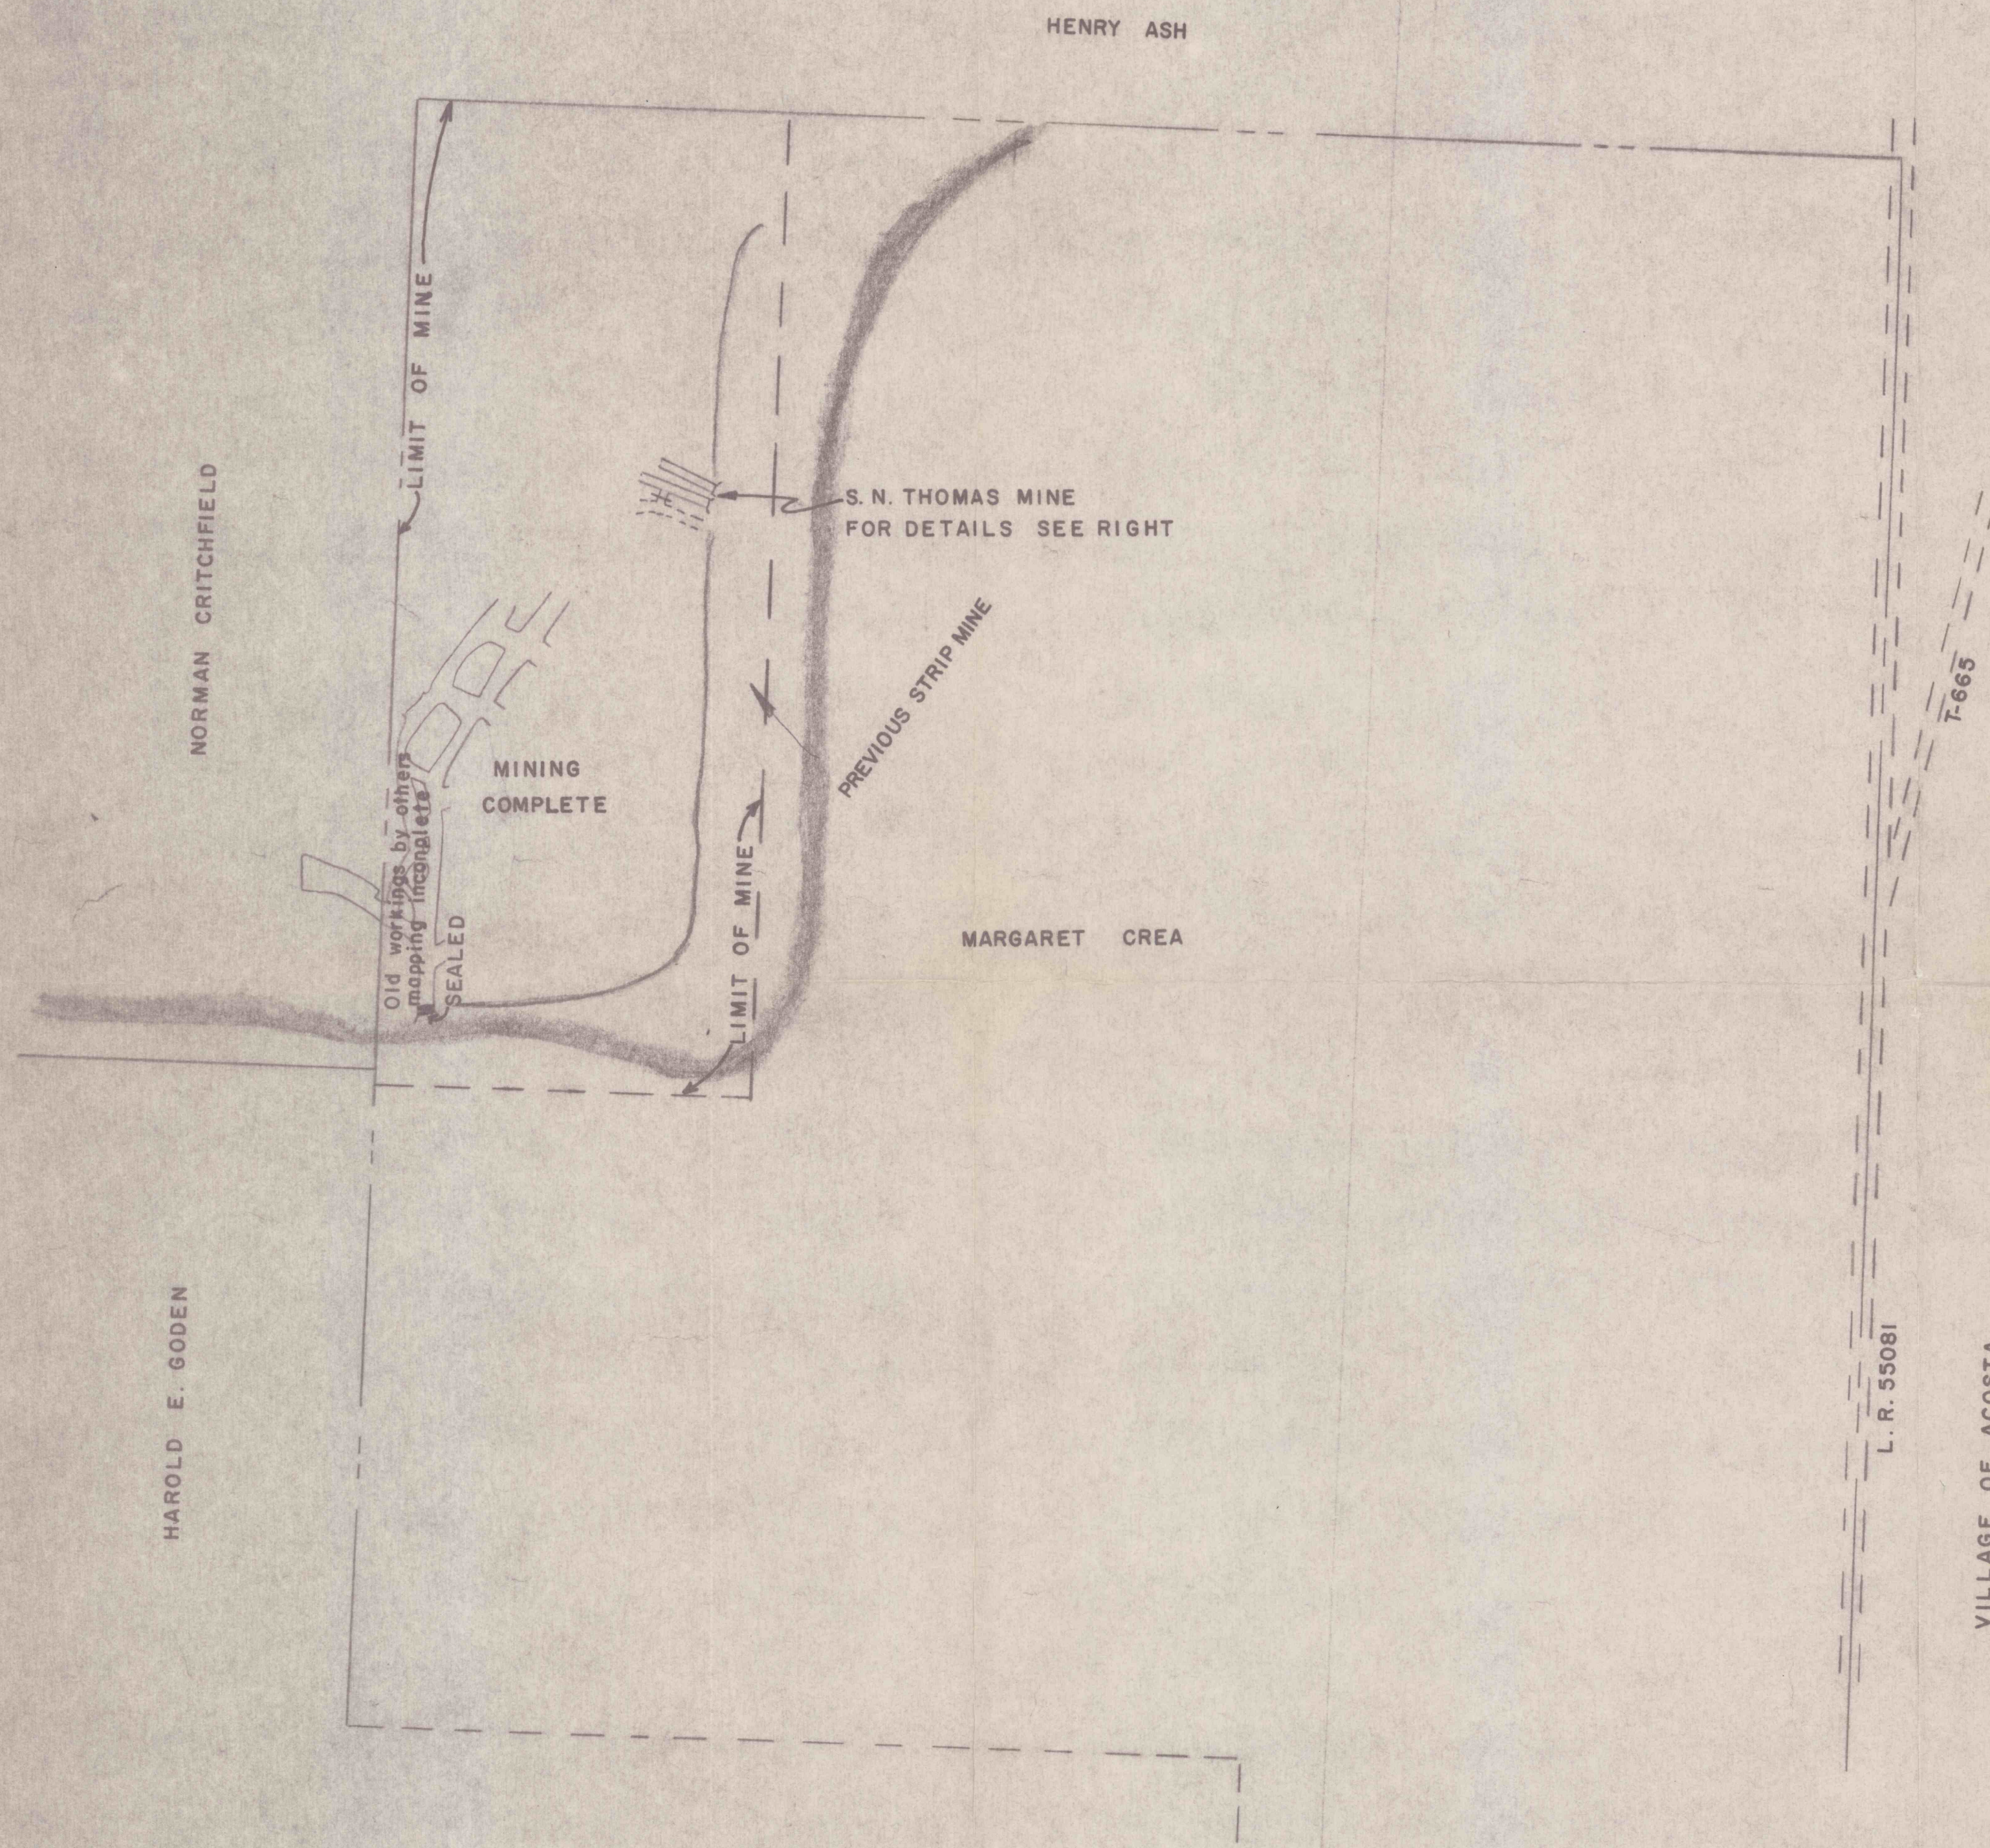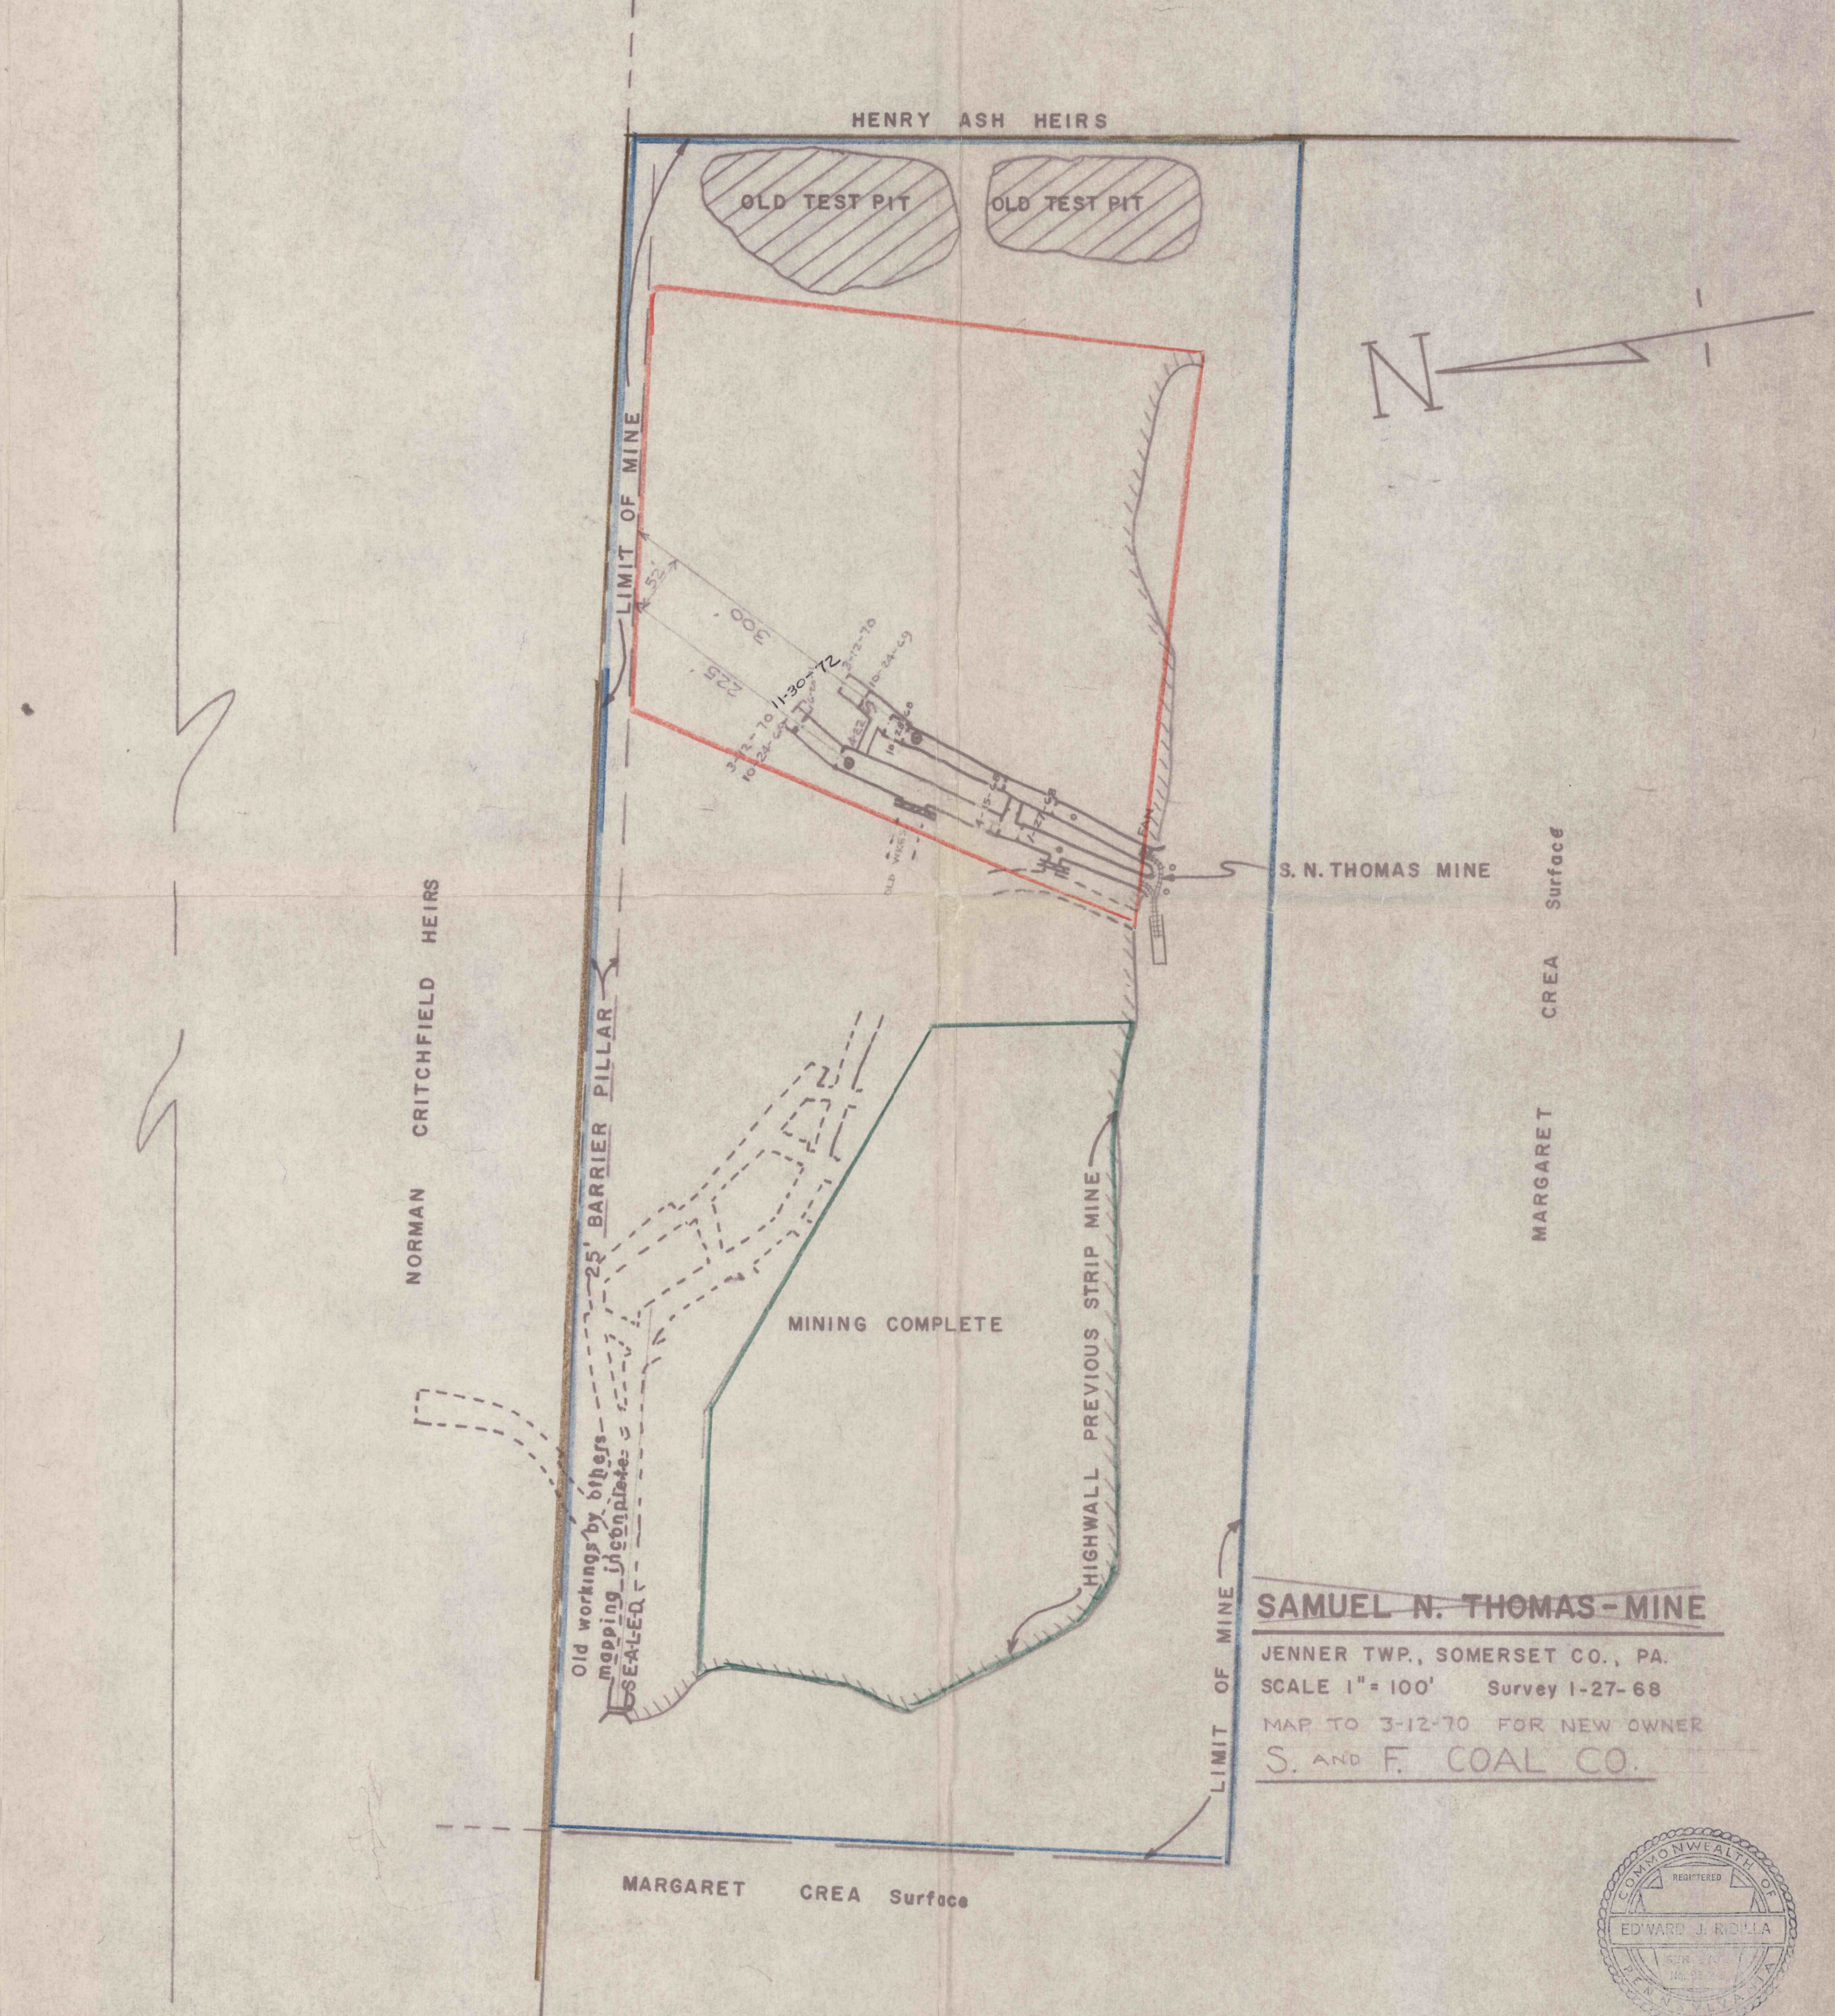

SAMUEL N. THOMAS MINE
 JENNER TWP., SOMERSET CO., PA.
 SCALE 1" = 100' Survey 1-27-68
 MAP TO 3-12-70 FOR NEW OWNER
 S. AND F. COAL CO.

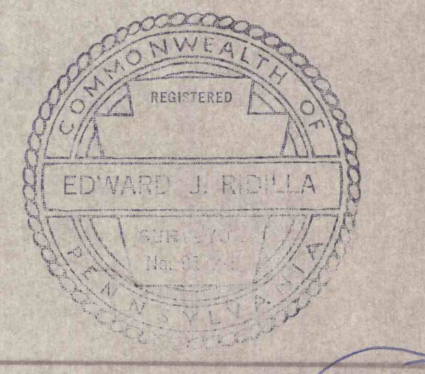

#2419
 1-12-2000
 C.C.