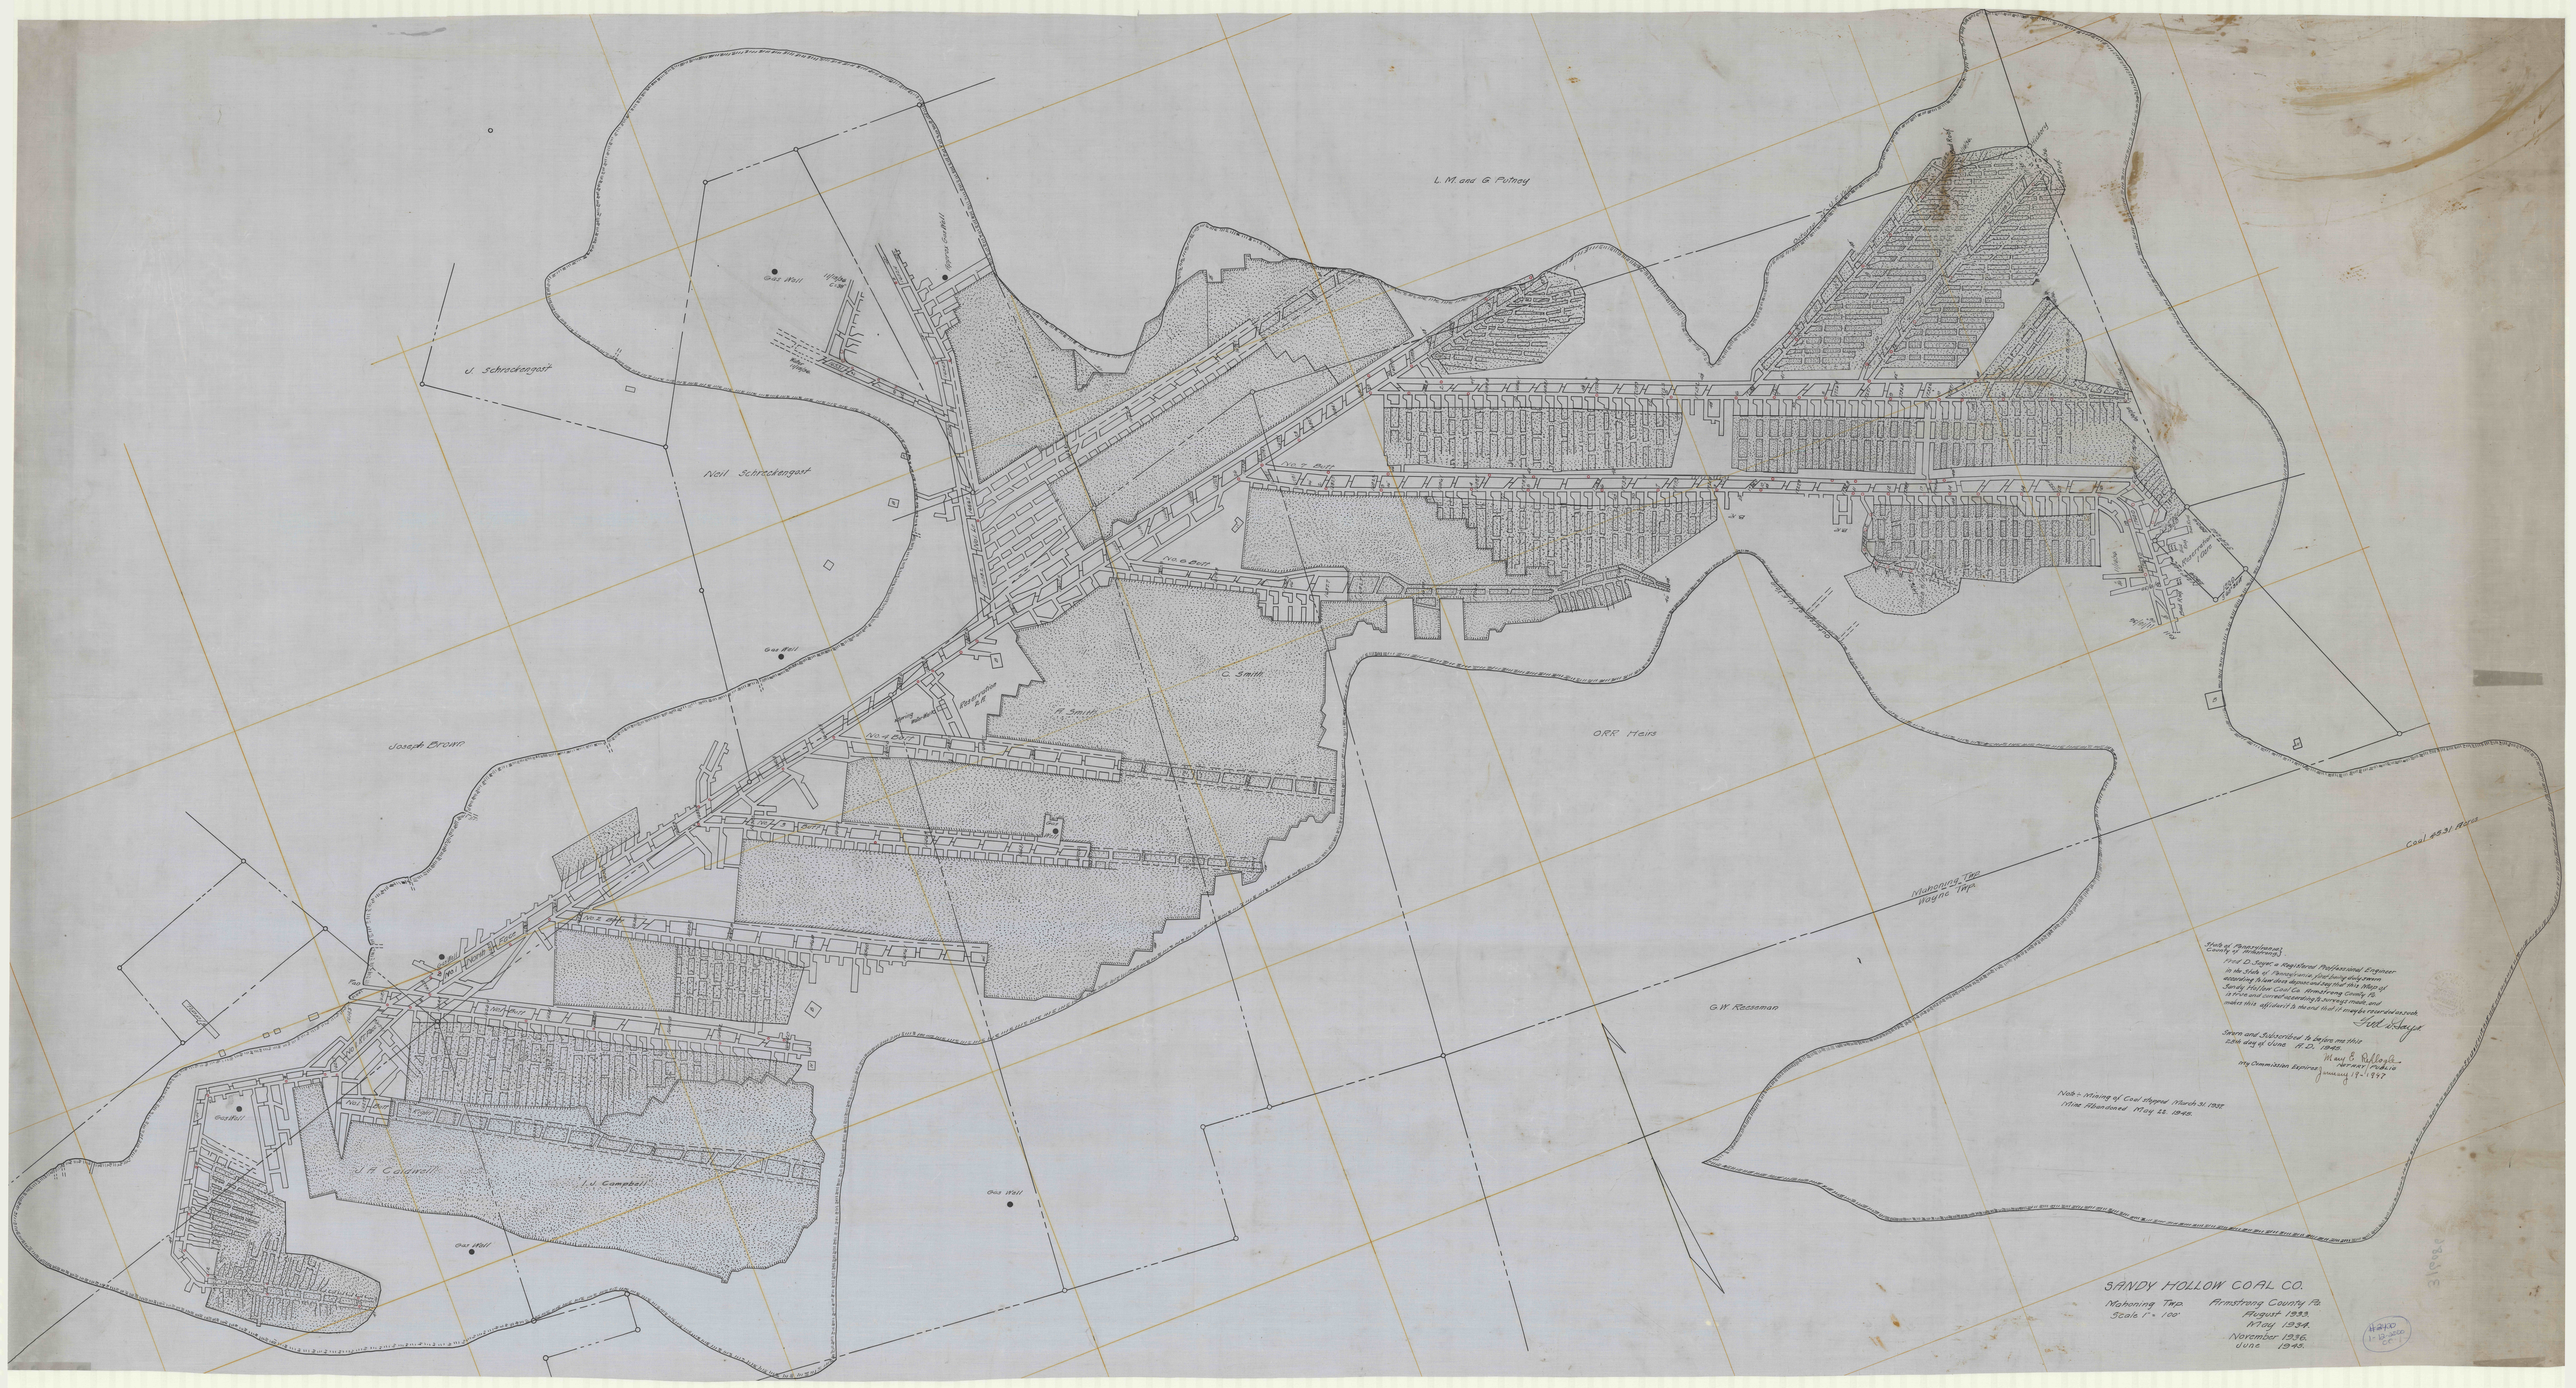

L. M. and G. Putney
J. Schreckengost
Neil Schreckengost
Gas Well
11/13/36 C-38"
Approx. Gas Well
Water 11/13/36
Gas Well
Joseph Brown
C. Smith
A. Smith
Reservation R.R.
x Spring Water Well
No. 7 Butt
No. 6 Butt
No. 4 Butt
No. 3 Butt
No. 2 Butt
No. 1 Butt
No. 1 Butt Right
No. 1 North Face
No. 1 Rt. Face
Fan
Gas Well
Gas Well
Gas Well
Gas Well
J. A. Caldwell
I. J. Campbell
ORR Heirs
G. W. Reeseman
Mahoning Twp.
Wayne Twp.
Coal 45.31 Acres
Outcrop of U. F. Vein
Outcrop of U. F. Vein
Hickory
Bad Roof
Bad Roof
Bad Roof
B.R.
B.R.
Reservation 1 Acre
Roll
B

State of Pennsylvania }
County of Armstrong }

Fred D. Sayer, a Registered Professional Engineer in the State of Pennsylvania, first being duly sworn according to law does depose and say that this Map of Sandy Hollow Coal Co. Armstrong County Pa. is true and correct according to surveys made, and makes this affidavit to the end that it may be recorded as such.

Fred D. Sayer

Sworn and Subscribed to before me this 28th day of June A.D. 1945.

Mary E. Replogle
Notary Public

My Commission Expires January 19 - 1947

Note :- Mining of Coal stopped March 31. 1937.
Mine Abandoned May 22. 1945.

SANDY HOLLOW COAL CO.

Mahoning Twp.
Scale 1" = 100'

Armstrong County Pa.
August 1933.
May 1934.
November 1936.
June 1945.

#2400
1-12-2000
CC-1

319082