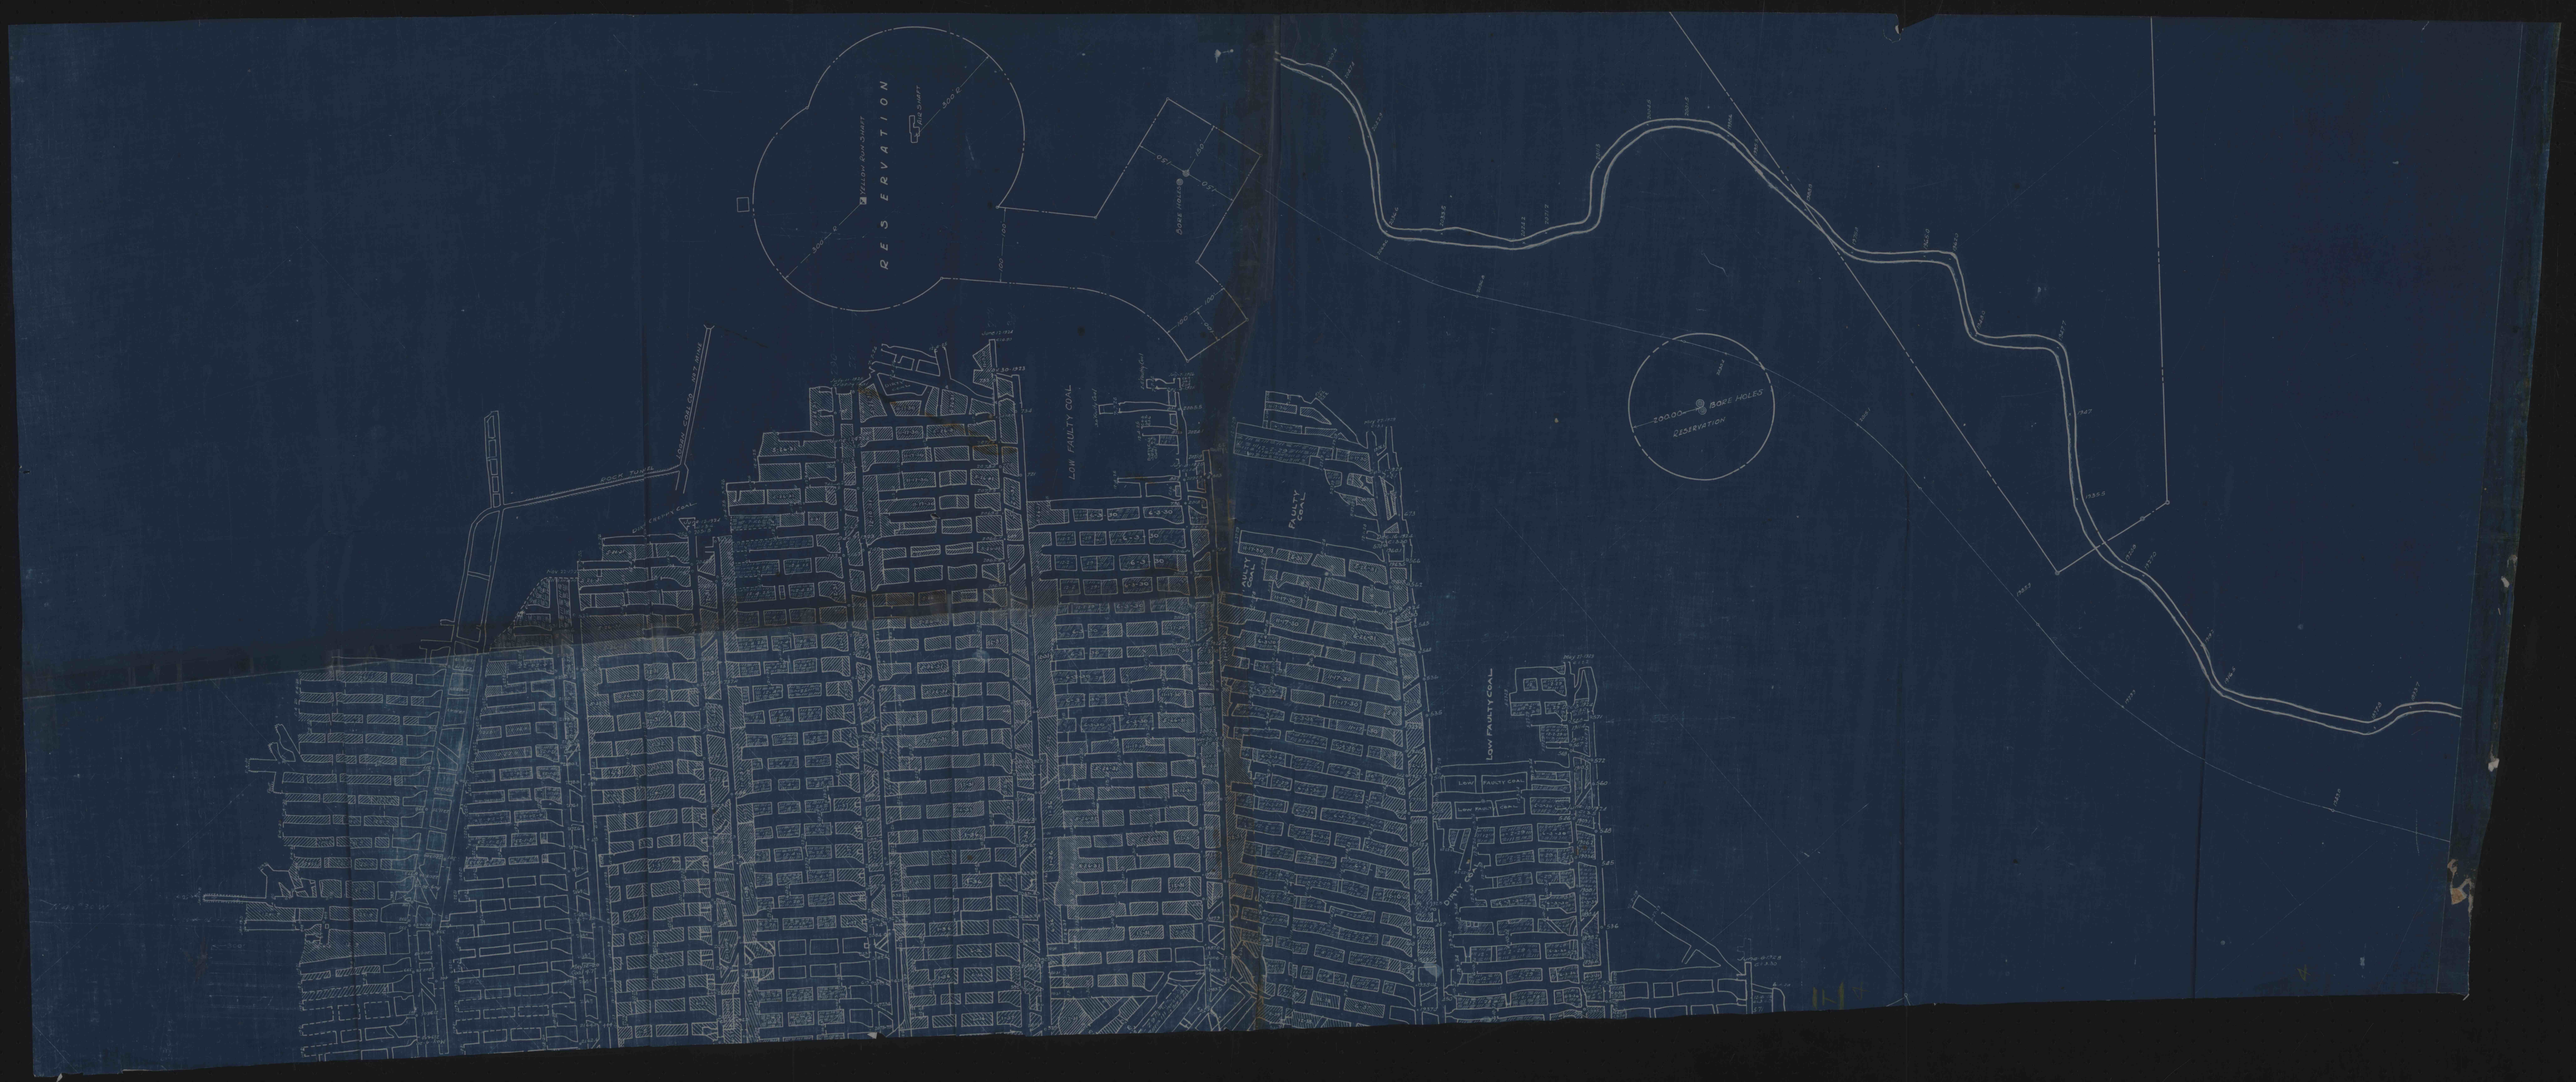
RESERVATION
YELLOW RUN SHAFT
BORE HOLES
LOW FAULTY COAL
FAULTY COAL
20000 BORE HOLES
RESERVATION