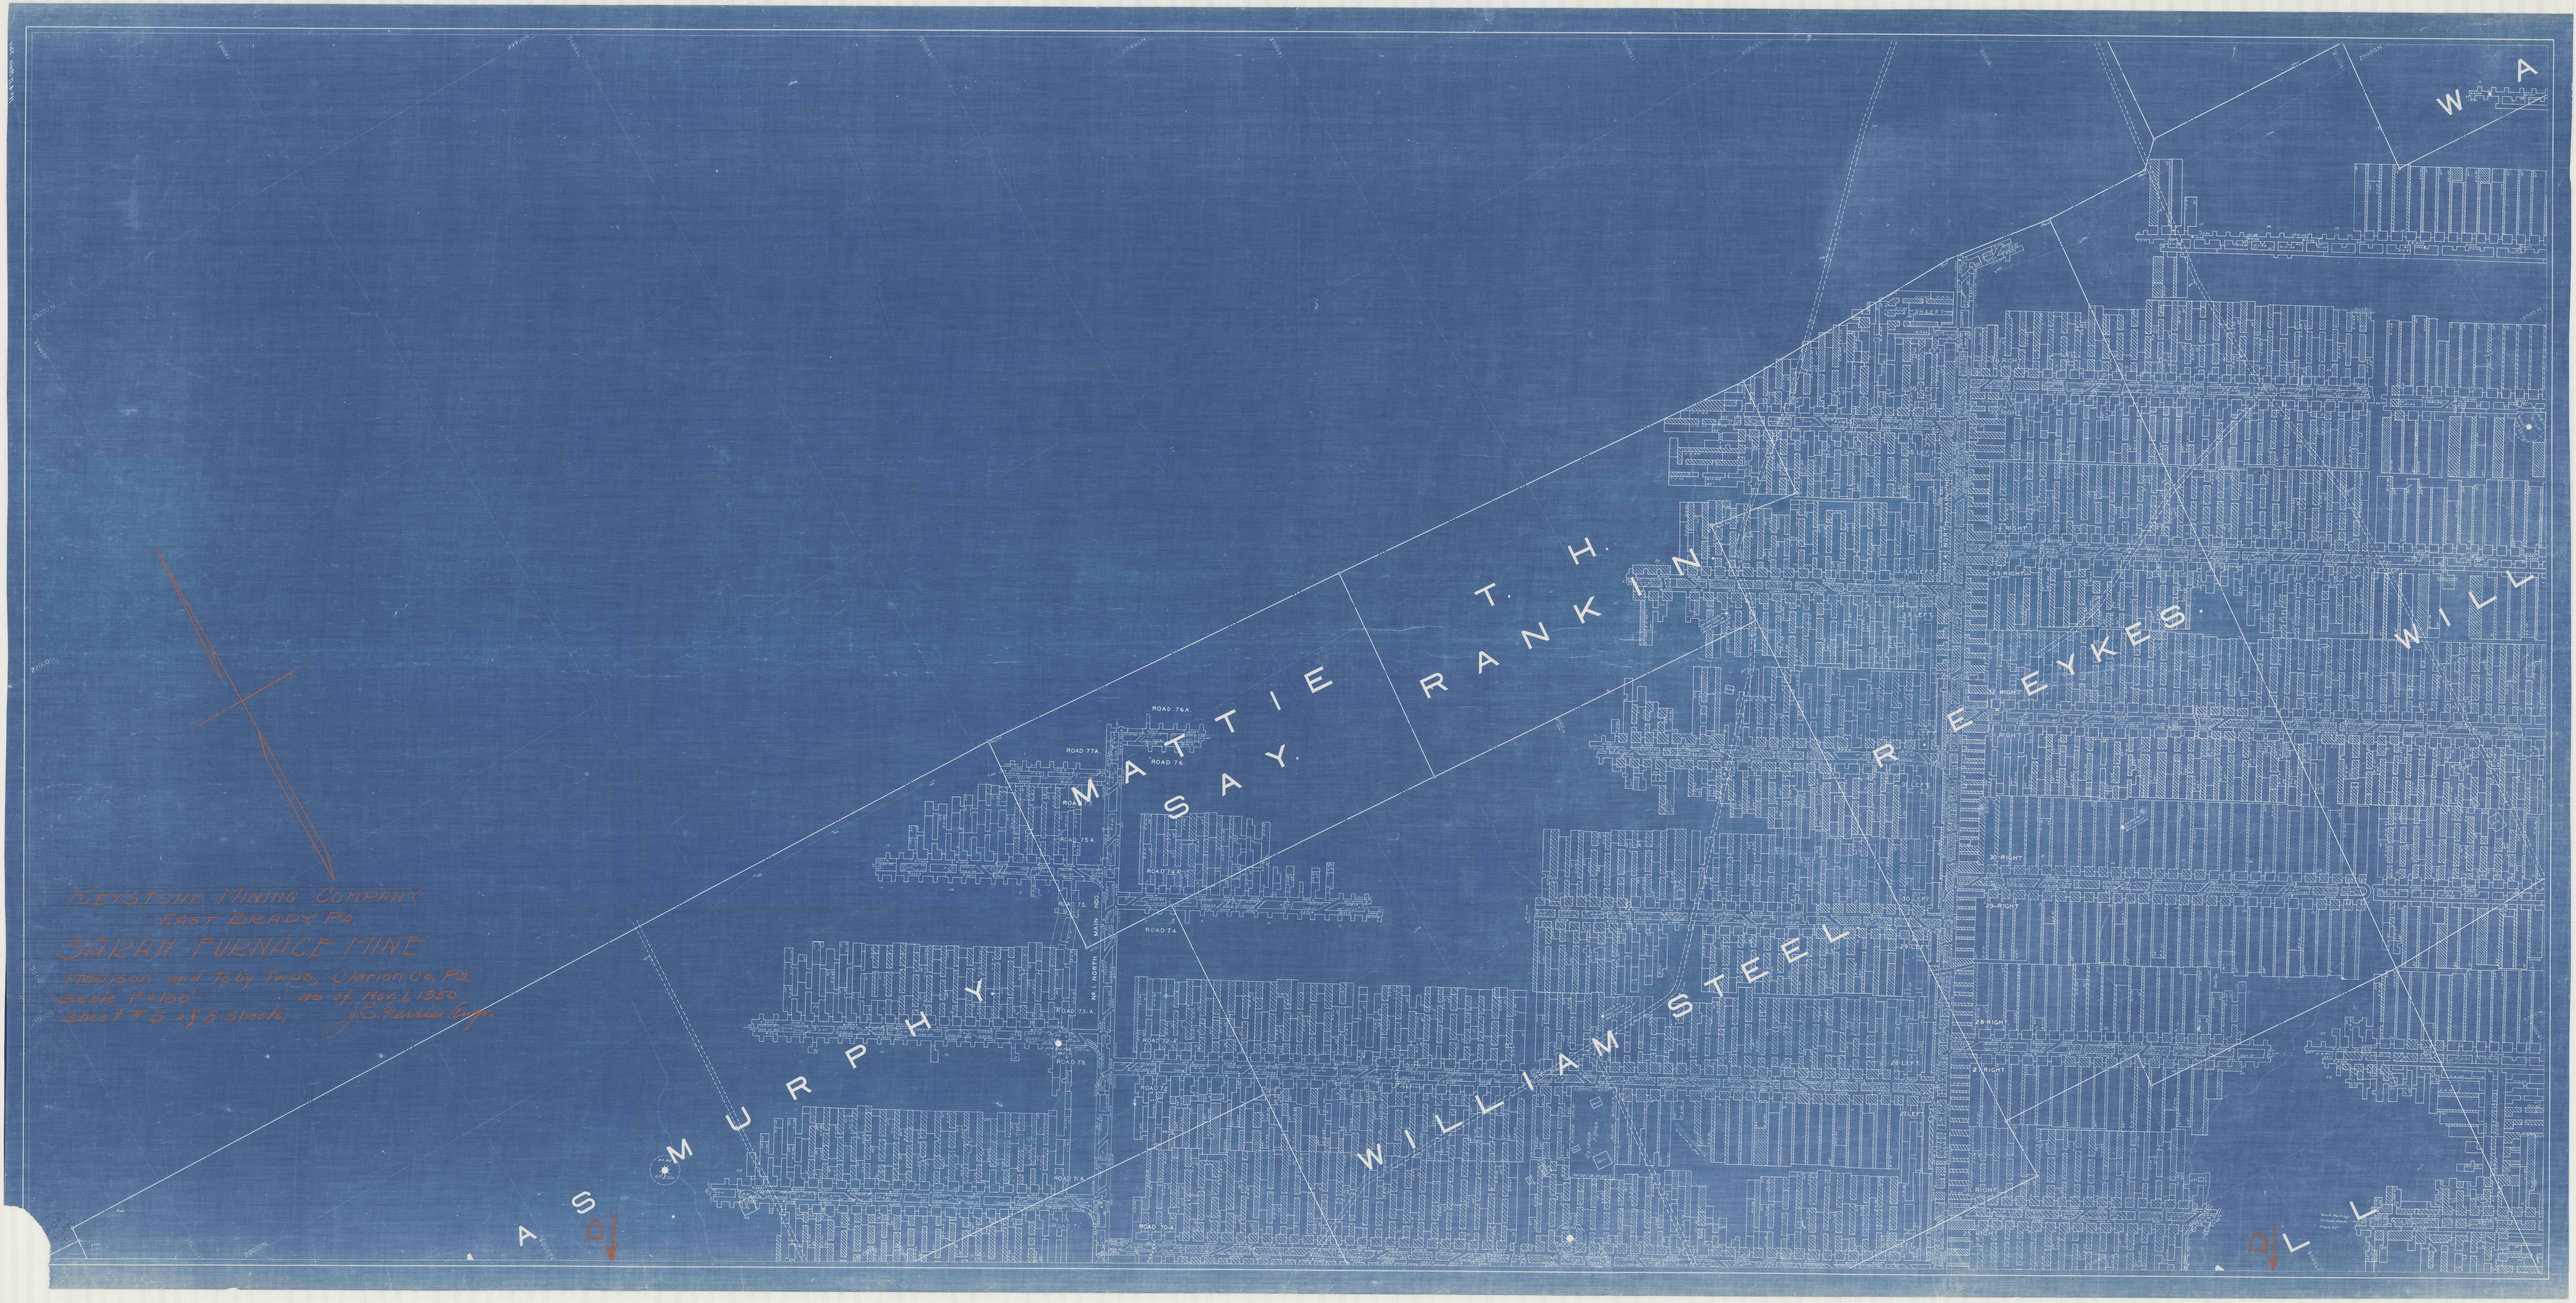

KEYSTONE MINING COMPANY
EAST BRADY PA.
SARAH FURNACE MINE
Madison and Toby Twps, Clarion Co. Pa
Scale 1"=100'
Sheet # 3 of 3 Sheets
MATTIE
SAY.
T. H.
RANKIN
EYKES.
WILLIAM
STEEL
MURPHY
ROAD 76A
ROAD 77A
ROAD 76
ROAD 75A
ROAD 74A
ROAD 75
ROAD 74
ROAD 73A
ROAD 73
ROAD 70A
MAIN RD.
N. & S. NORTH