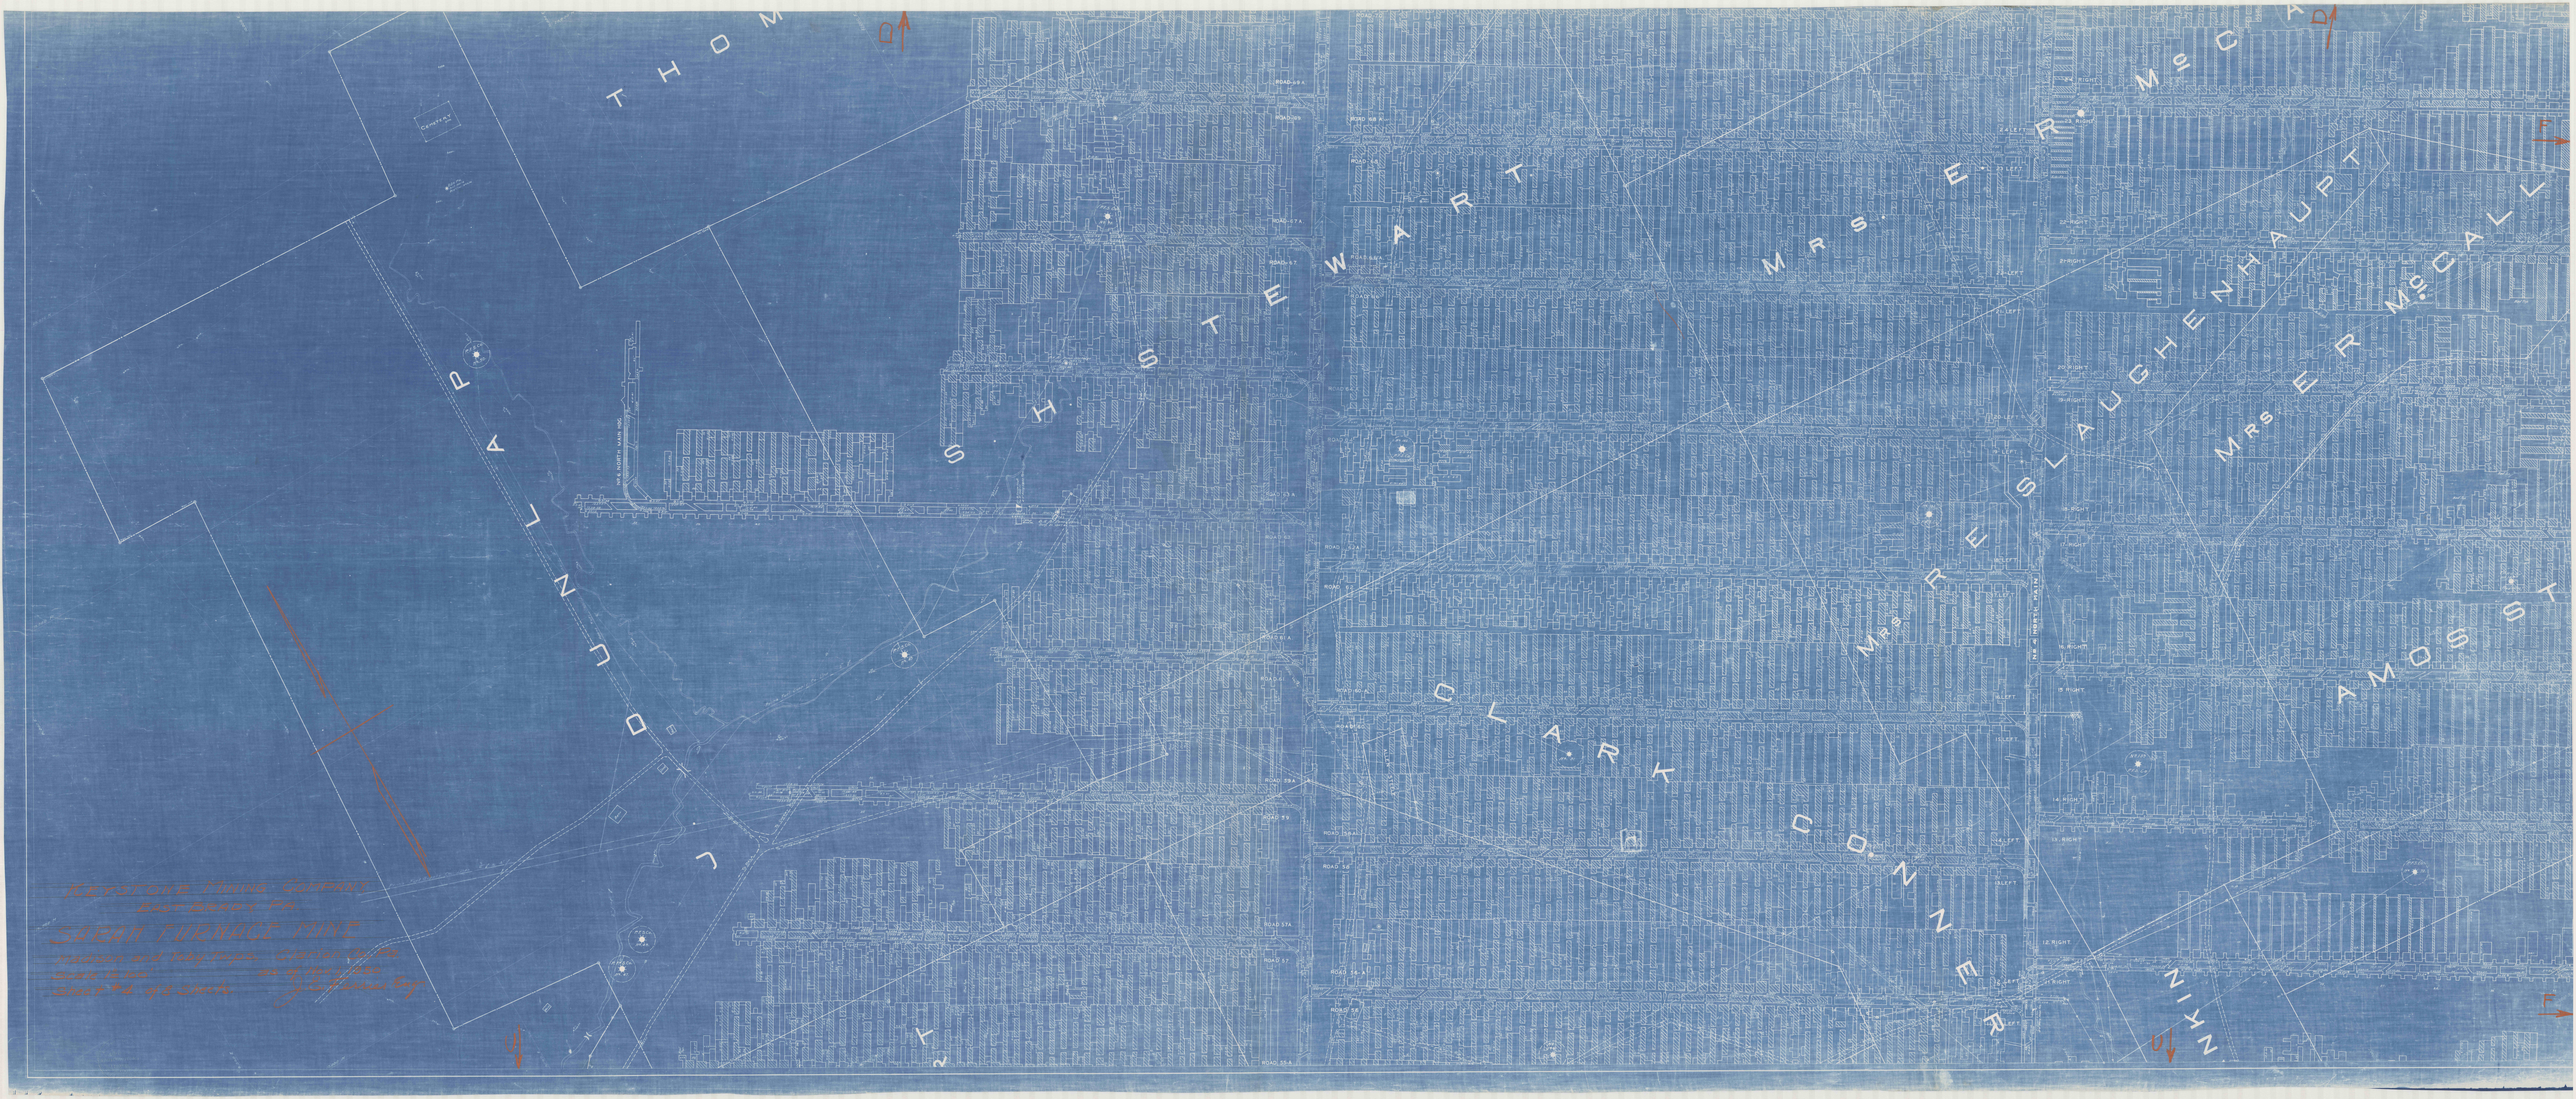
THOMAS
SHOEMAKER
LAPLAND
MRS. E. R. McCAULEY
MRS. E. R. McCAULEY
SLAUGHENHAUPT
MRS. E. R. McCAULEY
CLARK CONNER
AMOSS
KEYSTONE MINING COMPANY
EAST GRADY PA.
SARAH FURNACE MINE
MAGNETIC AND HEMATITE IRON ORE
SCALE 1 INCH = 400 FEET
DATE MAY 15 1944
SURVEYED BY J. C. DAVIS CO.