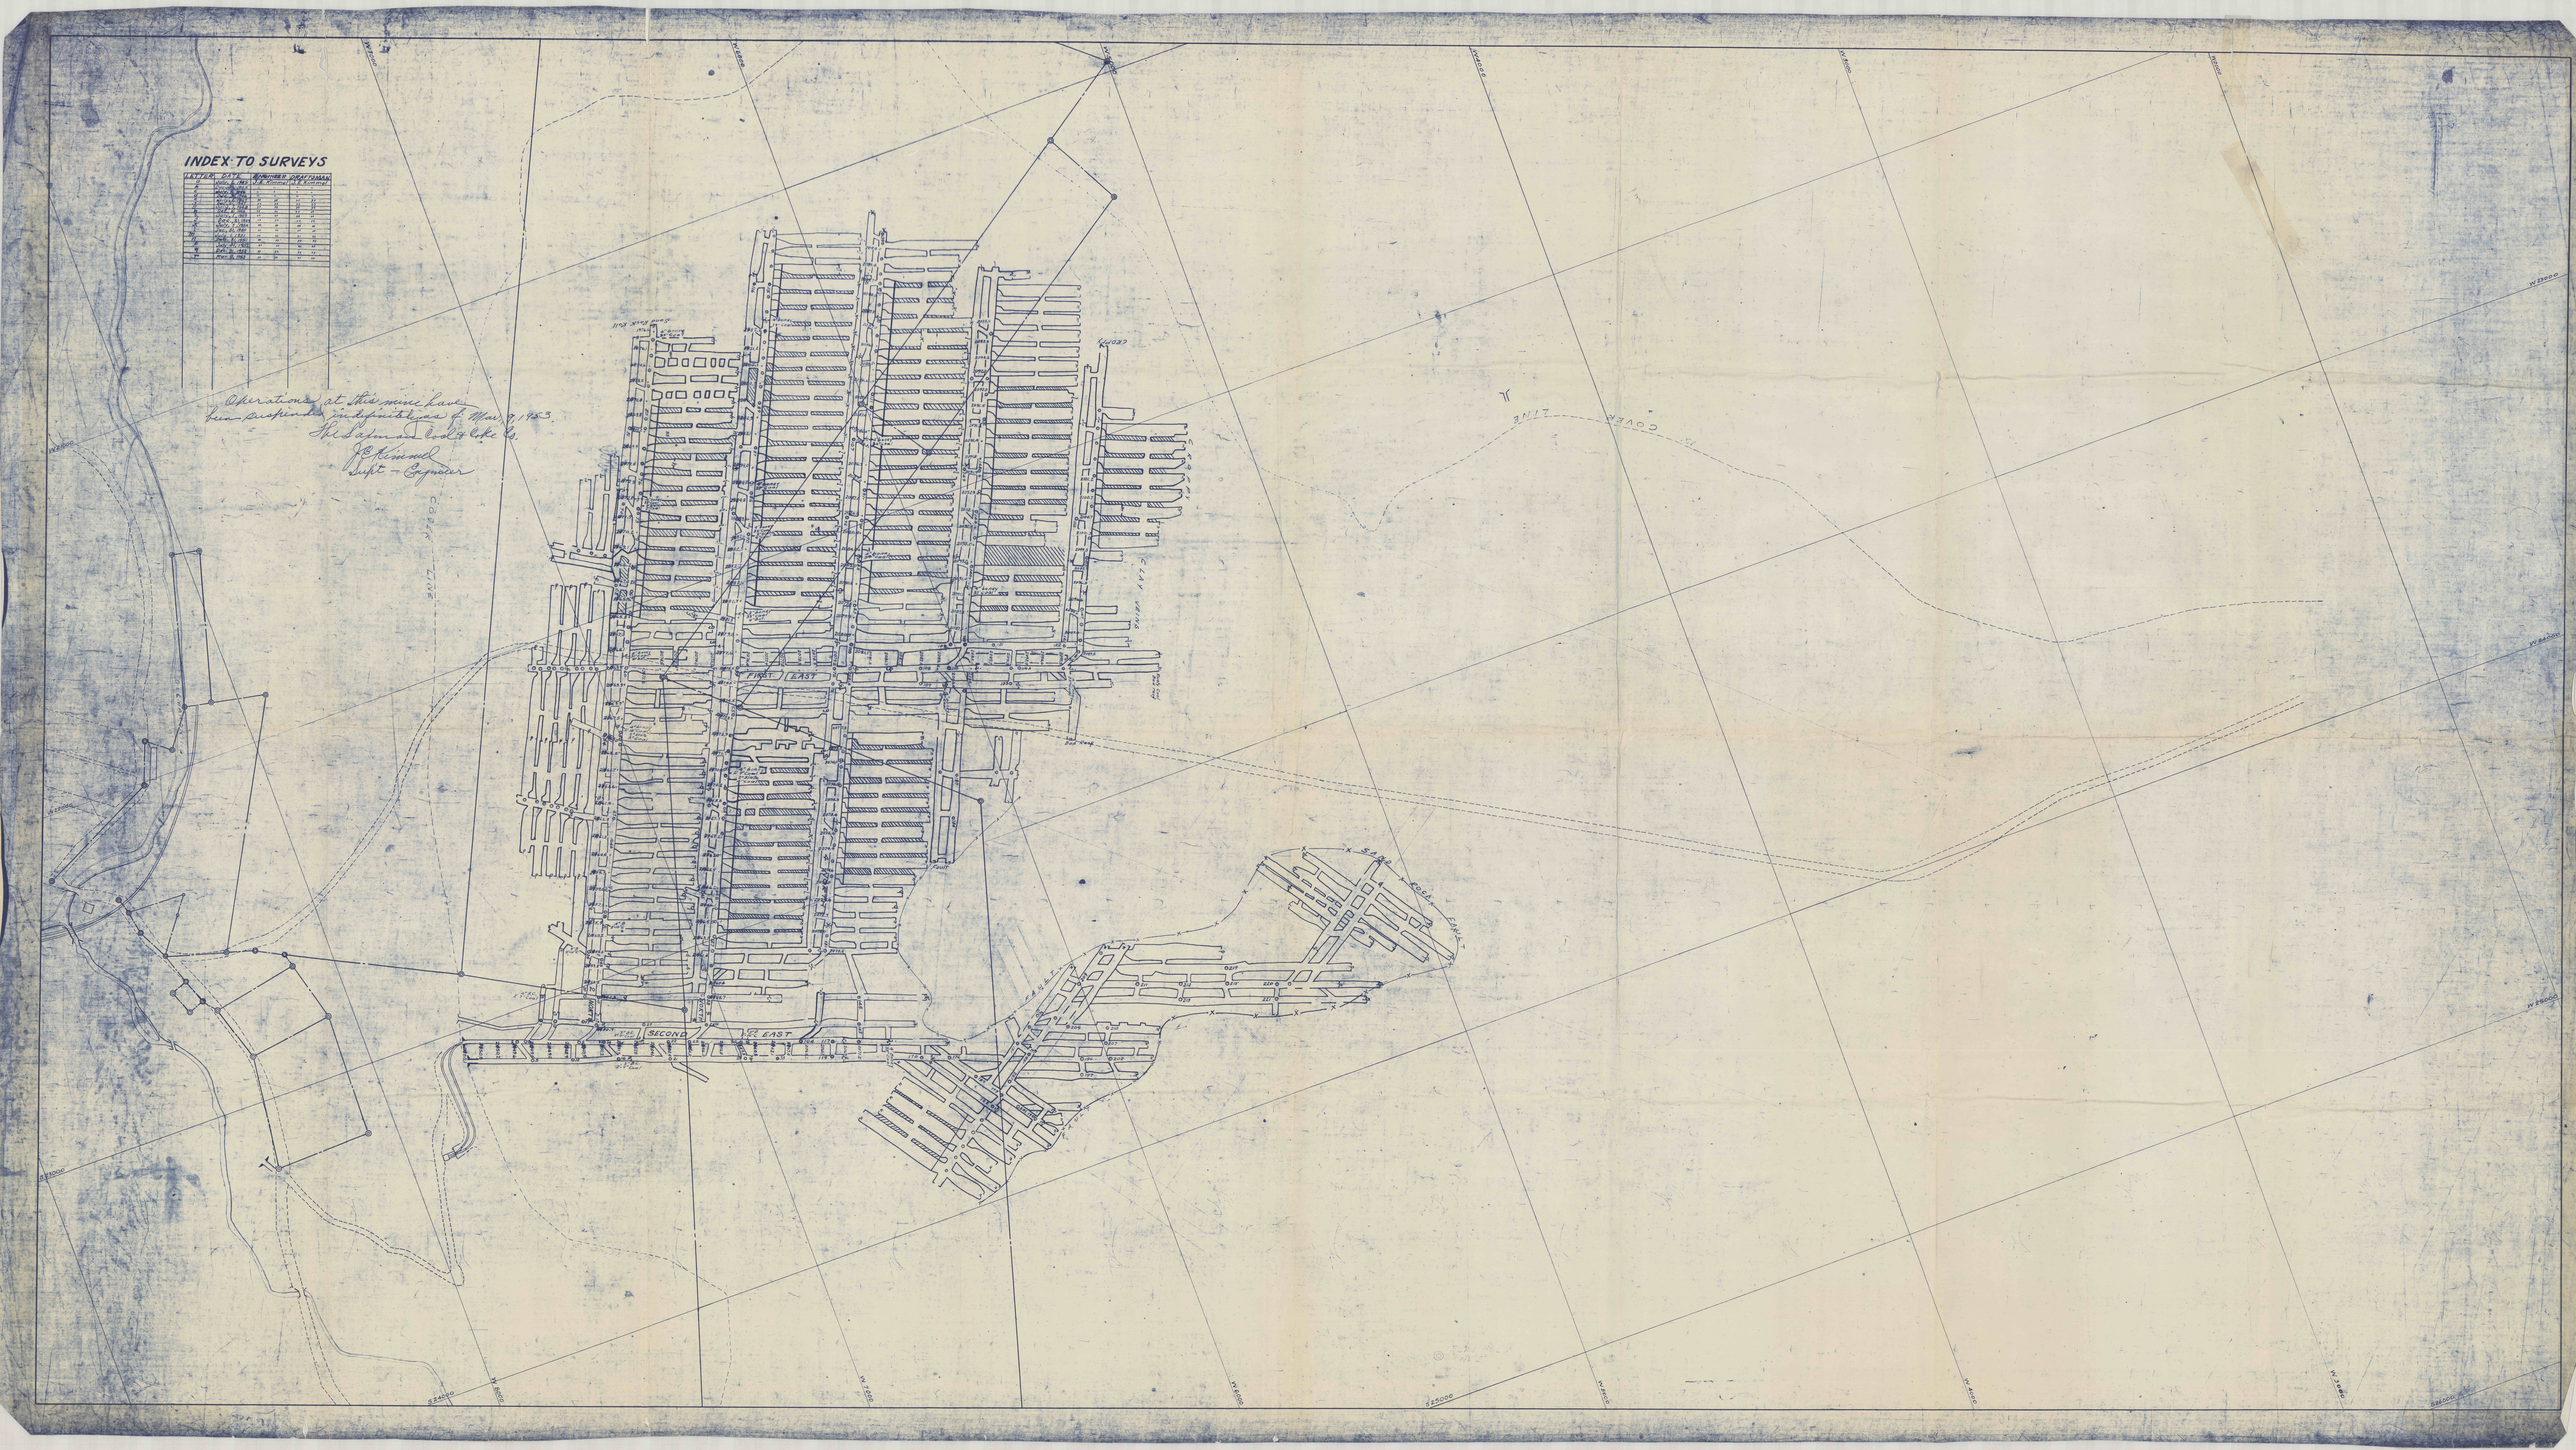
INDEX TO SURVEYS
LETTER DATE
NUMBER DRAFTSMAN
Operations at this mine have been suspended indefinitely as of Mar. 7, 1953.
The Salmon Coal & Coke Co.
J. E. Kimmel
Supt - Engineer
FIRST EAST
SECOND EAST
CLAY VEINS
COVER LINE