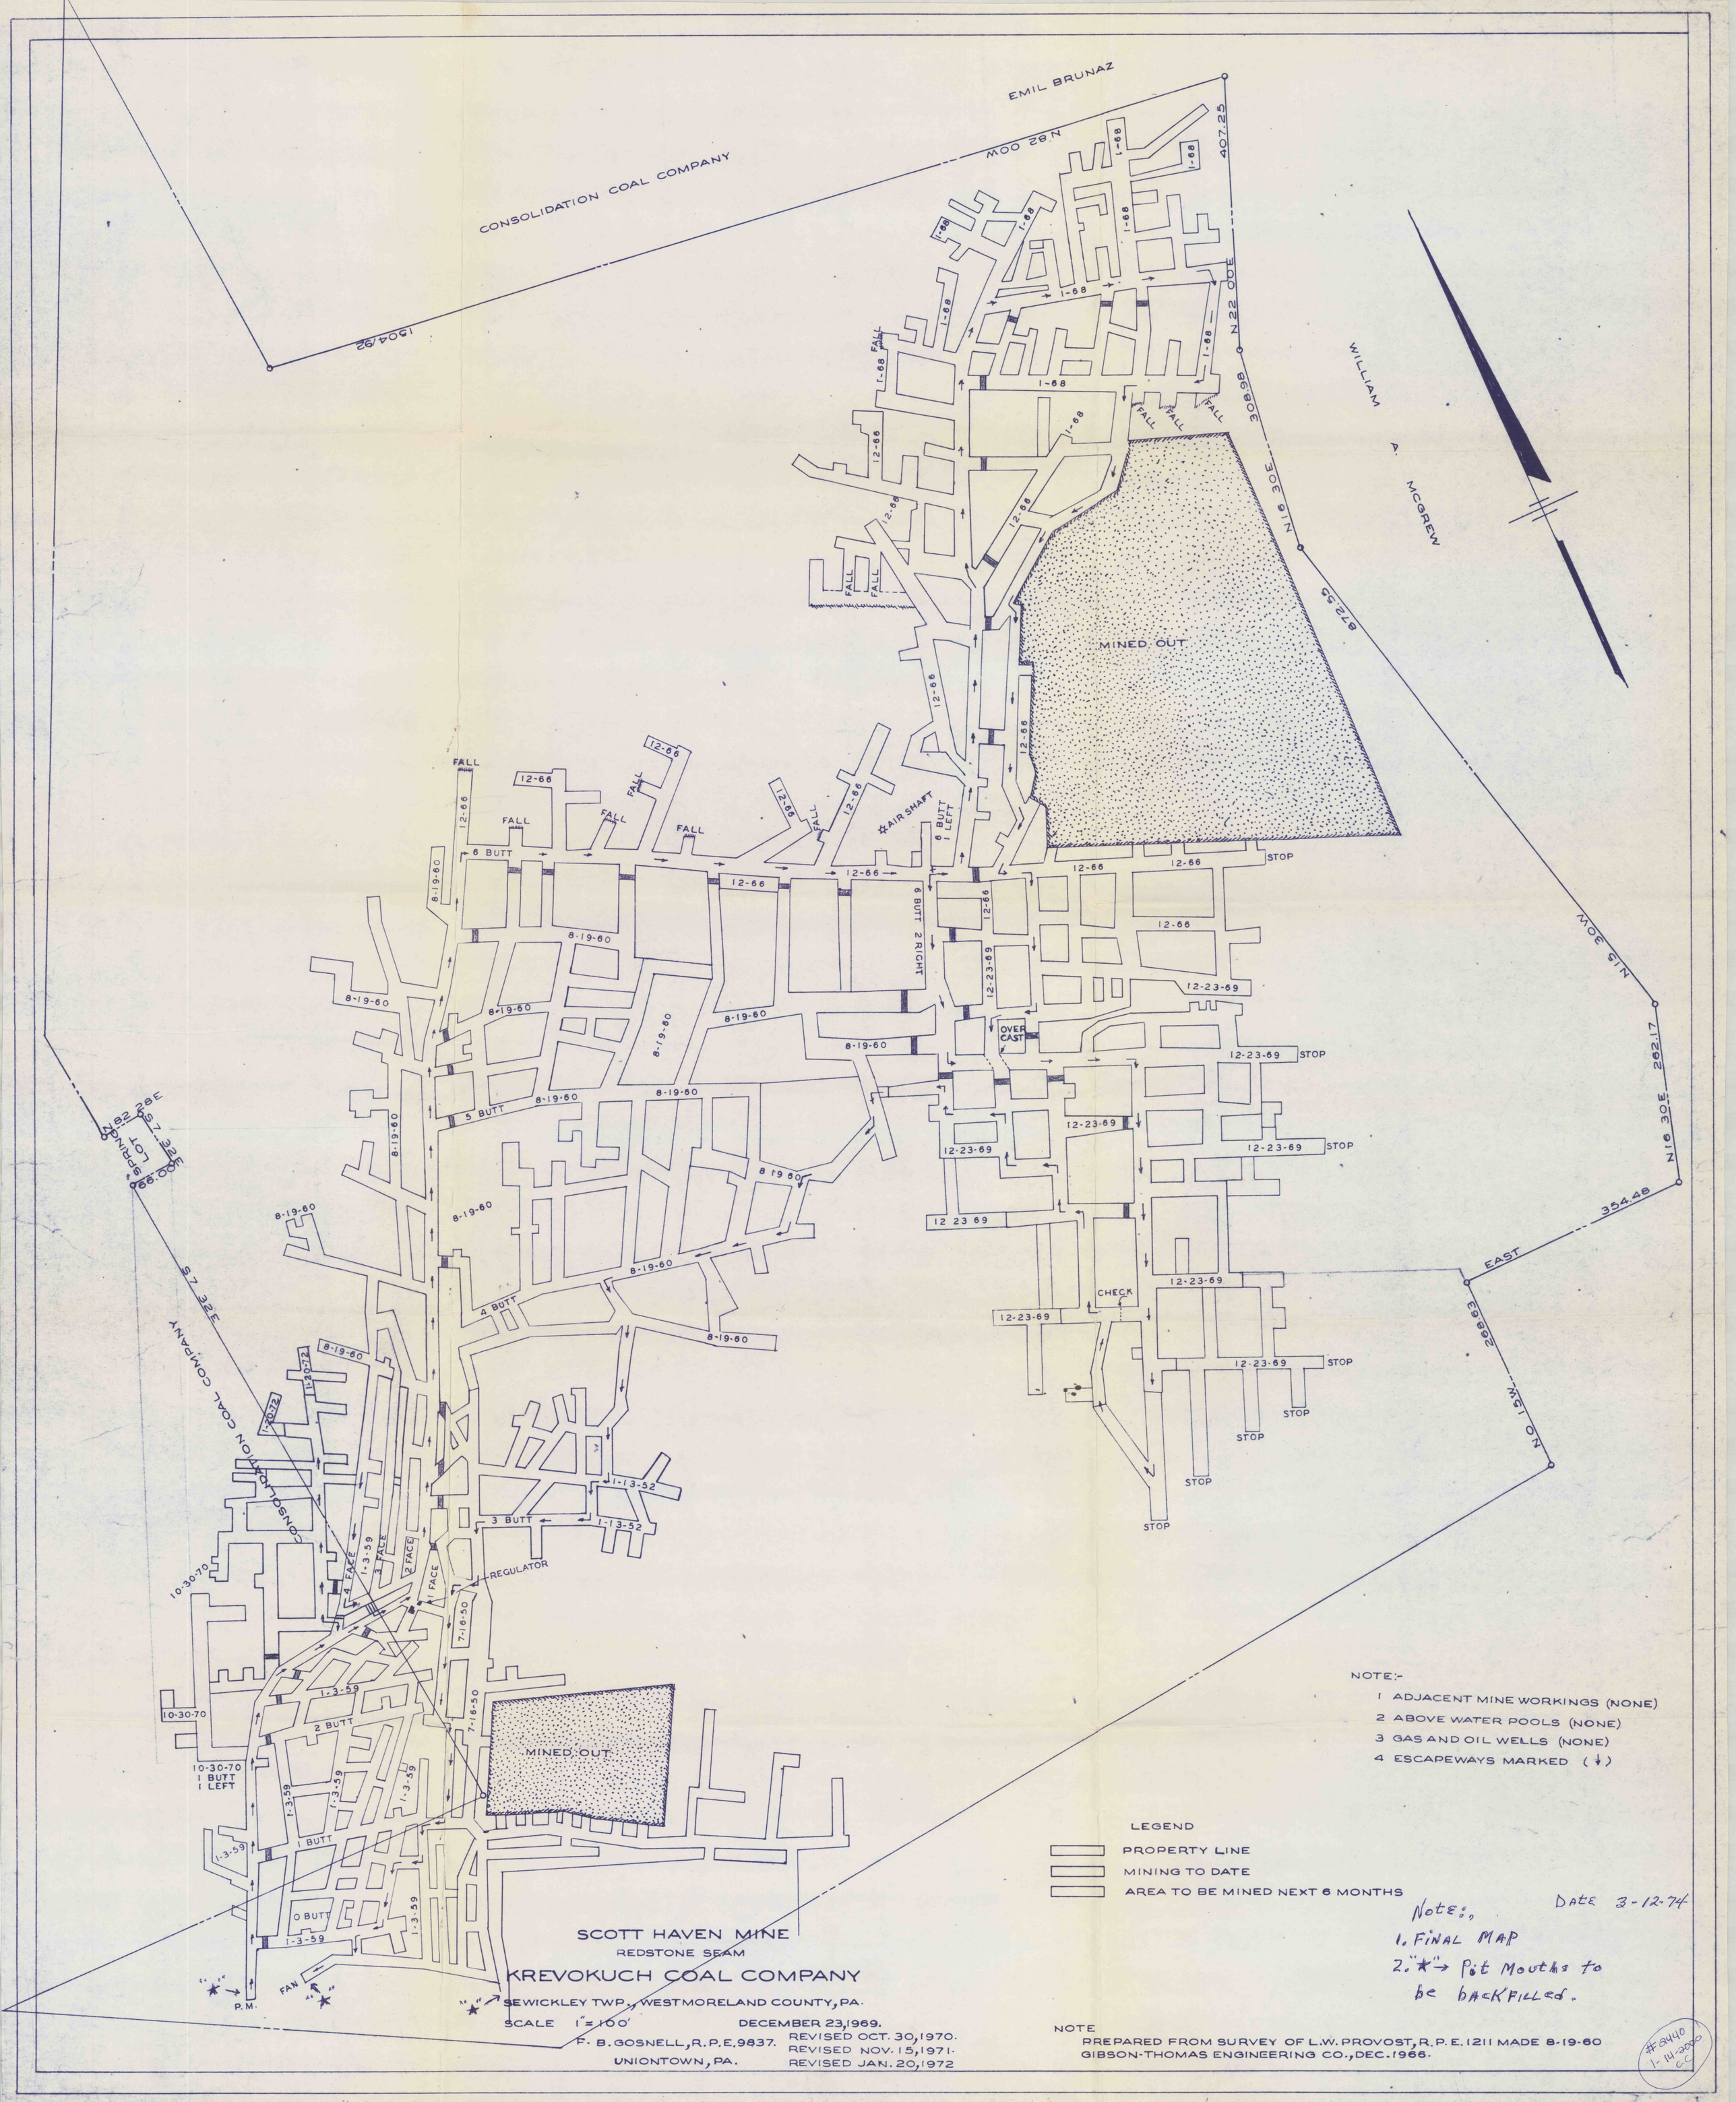

NOTE:-

1 ADJACENT MINE WORKINGS (NONE)
2 ABOVE WATER POOLS (NONE)
3 GAS AND OIL WELLS (NONE)
4 ESCAPEWAYS MARKED (↓)

LEGEND

PROPERTY LINE
MINING TO DATE
AREA TO BE MINED NEXT 6 MONTHS

Note:,
1. FINAL MAP
2. "★" → Pit Mouths to be backfilled.

DATE 3-12-74

SCOTT HAVEN MINE
REDSTONE SEAM
KREVOKUCH COAL COMPANY
SEWICKLEY TWP., WESTMORELAND COUNTY, PA.
SCALE 1" = 100'
DECEMBER 23, 1969.
F. B. GOSNELL, R.P.E. 9837.
UNIONTOWN, PA.
REVISED OCT. 30, 1970.
REVISED NOV. 15, 1971.
REVISED JAN. 20, 1972

NOTE
PREPARED FROM SURVEY OF L.W. PROVOST, R.P.E. 1211 MADE 8-19-60
GIBSON-THOMAS ENGINEERING CO., DEC. 1966.

#8440
1-14-2000
CC