


SAMUEL WEAVER

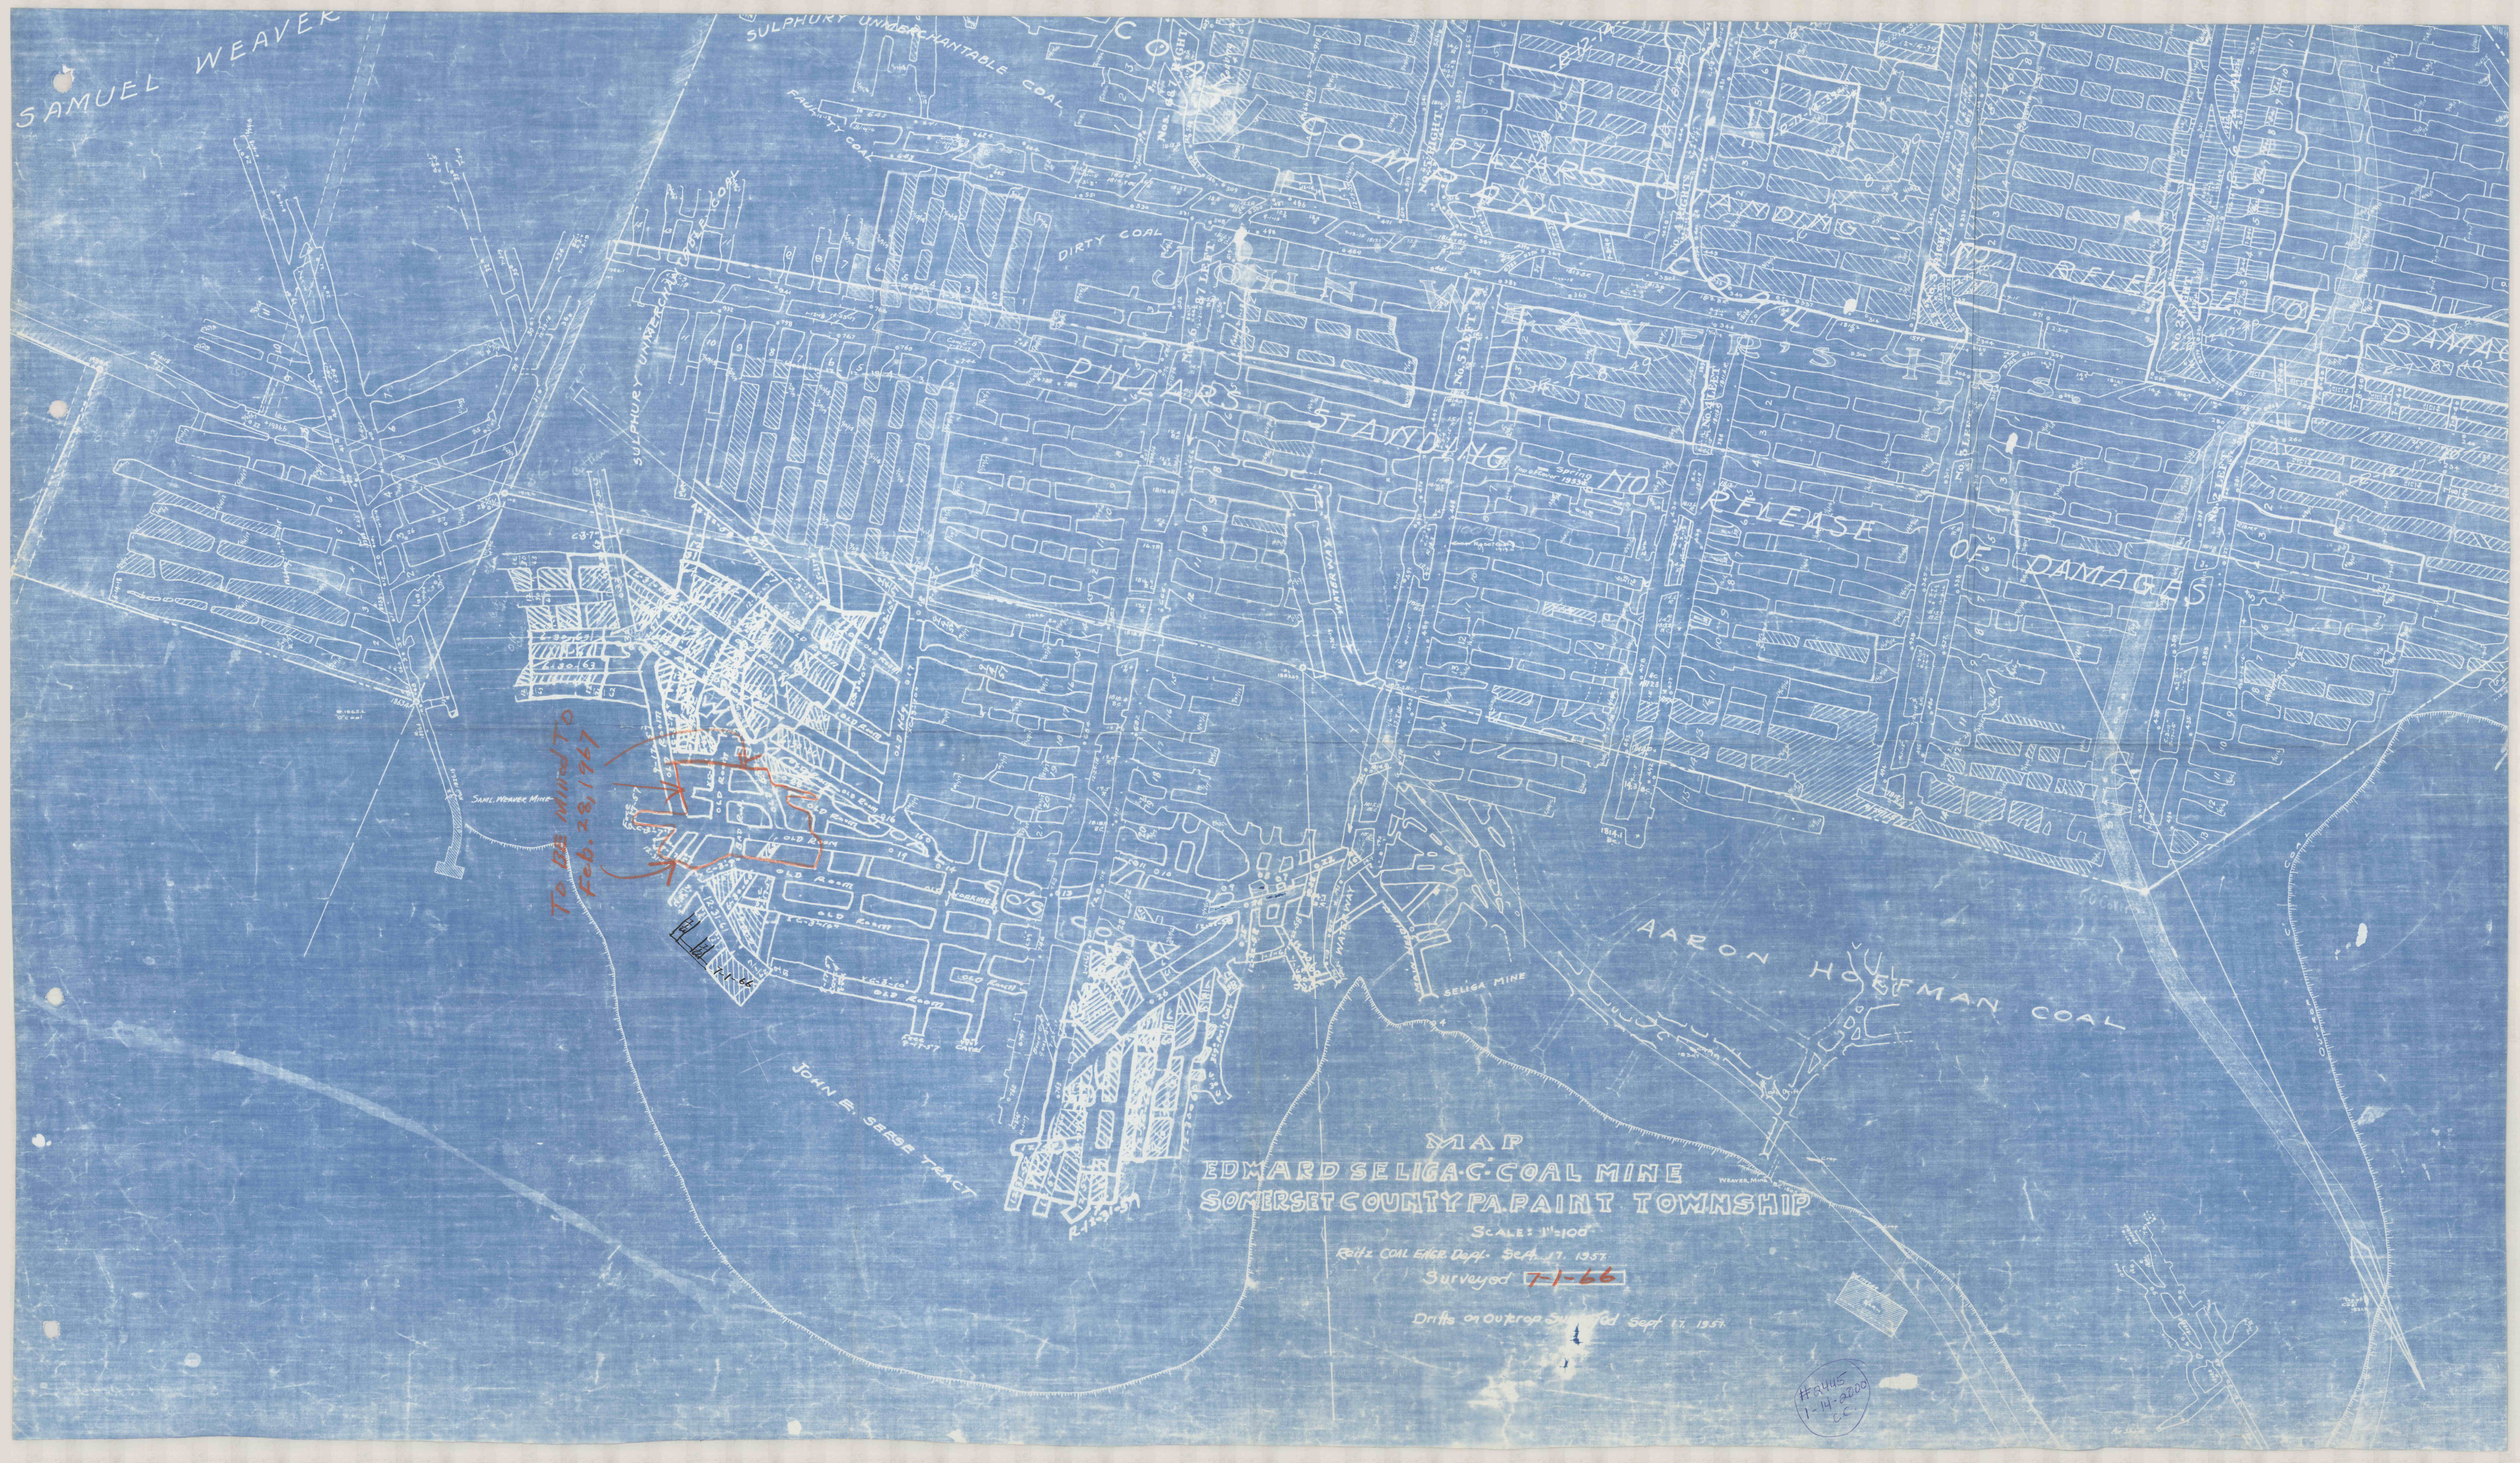

TO BE MINED TO
Feb. 28, 1967

MAP
EDWARD SELIGAC COAL MINE
SOMERSET COUNTY PA. PAINT TOWNSHIP

SCALE: 1"=100'
 Reitz Coal Edge Dept. Sept. 17, 1957.
 Surveyed 7-1-66
 Drifts on Outcrop Surveyed Sept. 17, 1957.

#4445
 1-14-2000
 CC