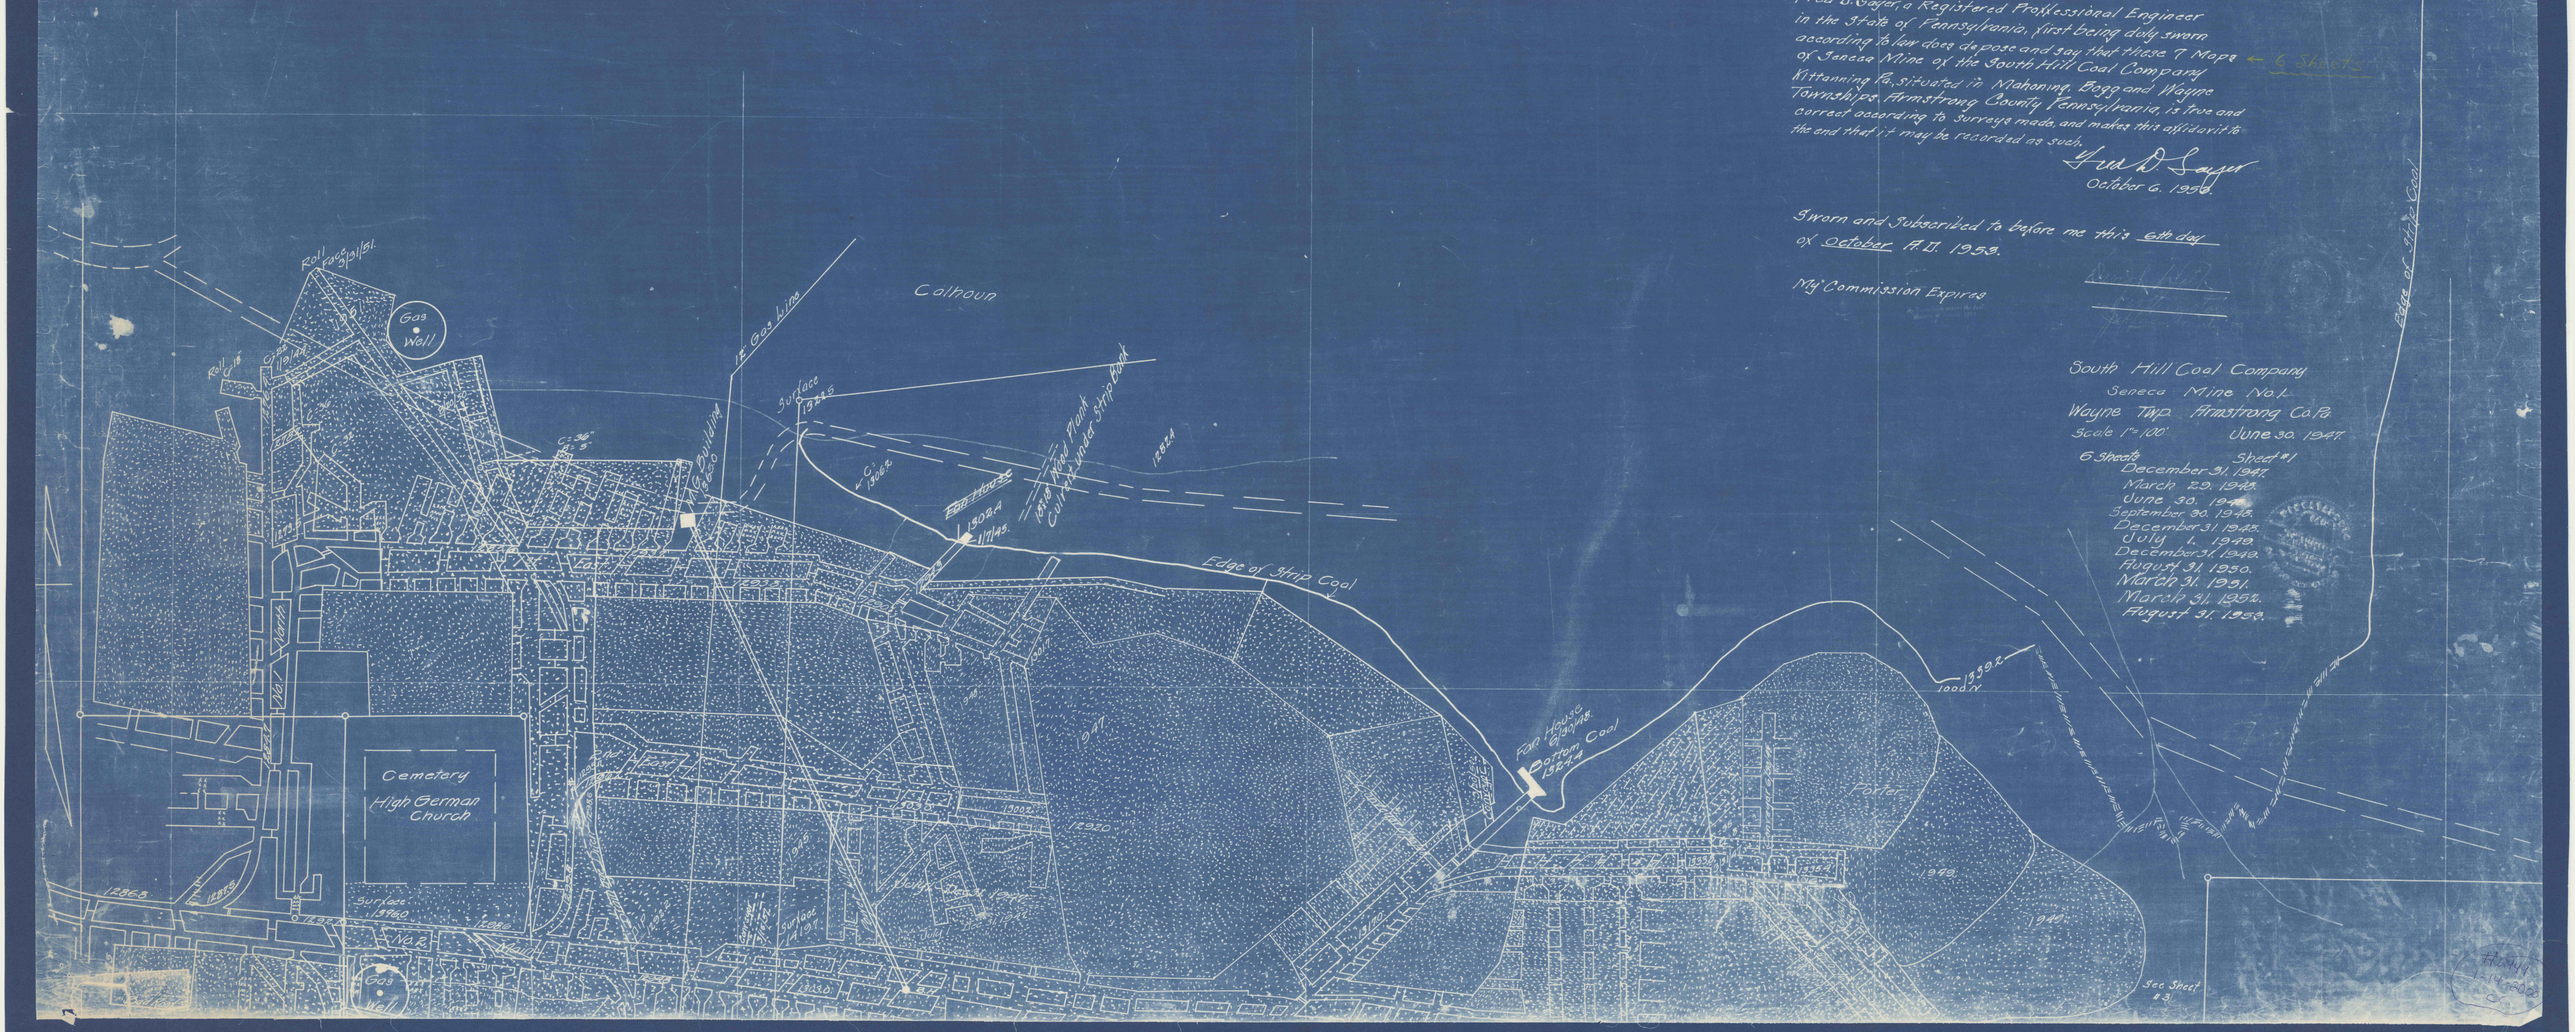

State of Pennsylvania
County of Jefferson
Fred D. Sayer, a Registered Professional Engineer in the State of Pennsylvania, first being duly sworn according to law does depose and say that these 7 Maps of Seneca Mine of the South Hill Coal Company Kittanning Pa., situated in Mahoning, Bogg and Wayne Townships, Armstrong County Pennsylvania, is true and correct according to surveys made, and makes this affidavit to the end that it may be recorded as such. ← 6 Sheets

Fred D. Sayer
October 6. 1953.

Sworn and Subscribed to before me this 6th day of October A.D. 1953.

My Commission Expires

South Hill Coal Company
Seneca Mine No. 1
Wayne Twp. Armstrong Co. Pa.
Scale 1" = 100' June 30. 1947.
6 Sheets Sheet #1
December 31. 1947.
March 29. 1948.
June 30. 1948.
September 30. 1948.
December 31. 1948.
July 1. 1949.
December 31. 1949.
August 31. 1950.
March 31. 1951.
March 31. 1952.
August 31. 1953.

Sheet 1 of 6