

South Hill Coal Company
 Mines No. 2 and 3
 Doggs Township Firming Co. B.
 Scale 1" = 100'
 Sheet # 4
 6 Sheets
 December 1948
 April 1, 1949
 July 1, 1949
 December 31, 1949
 August 31, 1950
 March 31, 1951
 August 31, 1952
 August 31, 1953



U. Braschius
 The action Mine Workings
 Prior to 1948
 Main Hall
 Coal #1
 Coal #2
 Coal #3

Gas
 Well

Main Heading Mine #1
 March 1948

Stocked Mill

Bad Rock

1951

1950


1949

1948

March 1948

Ruins

Face of Old Workings

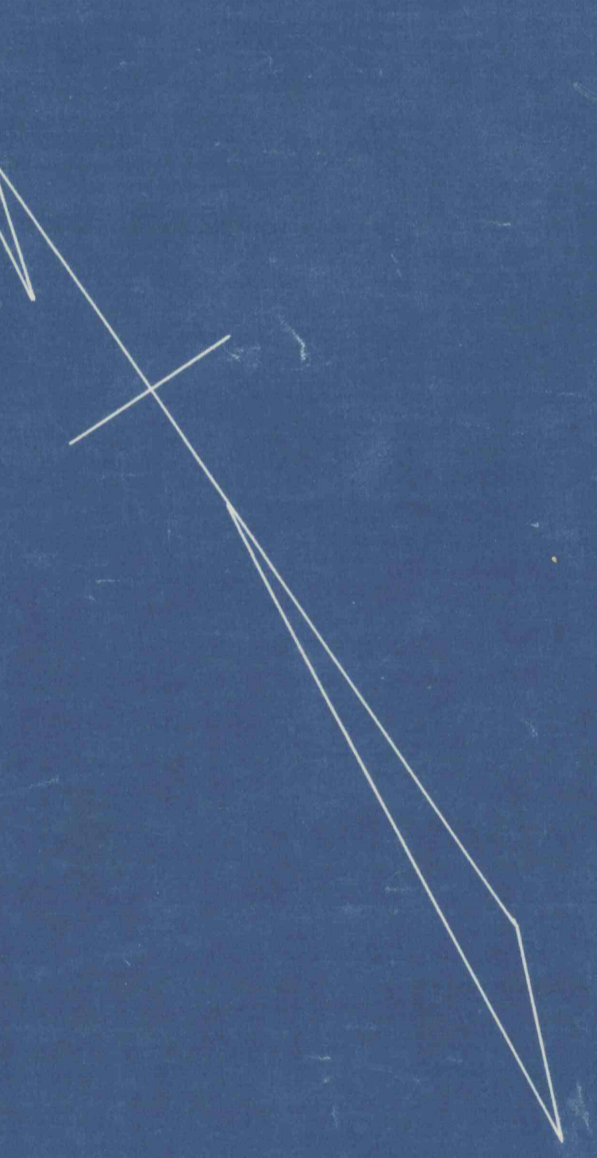

Face of Old Workings
 1948