
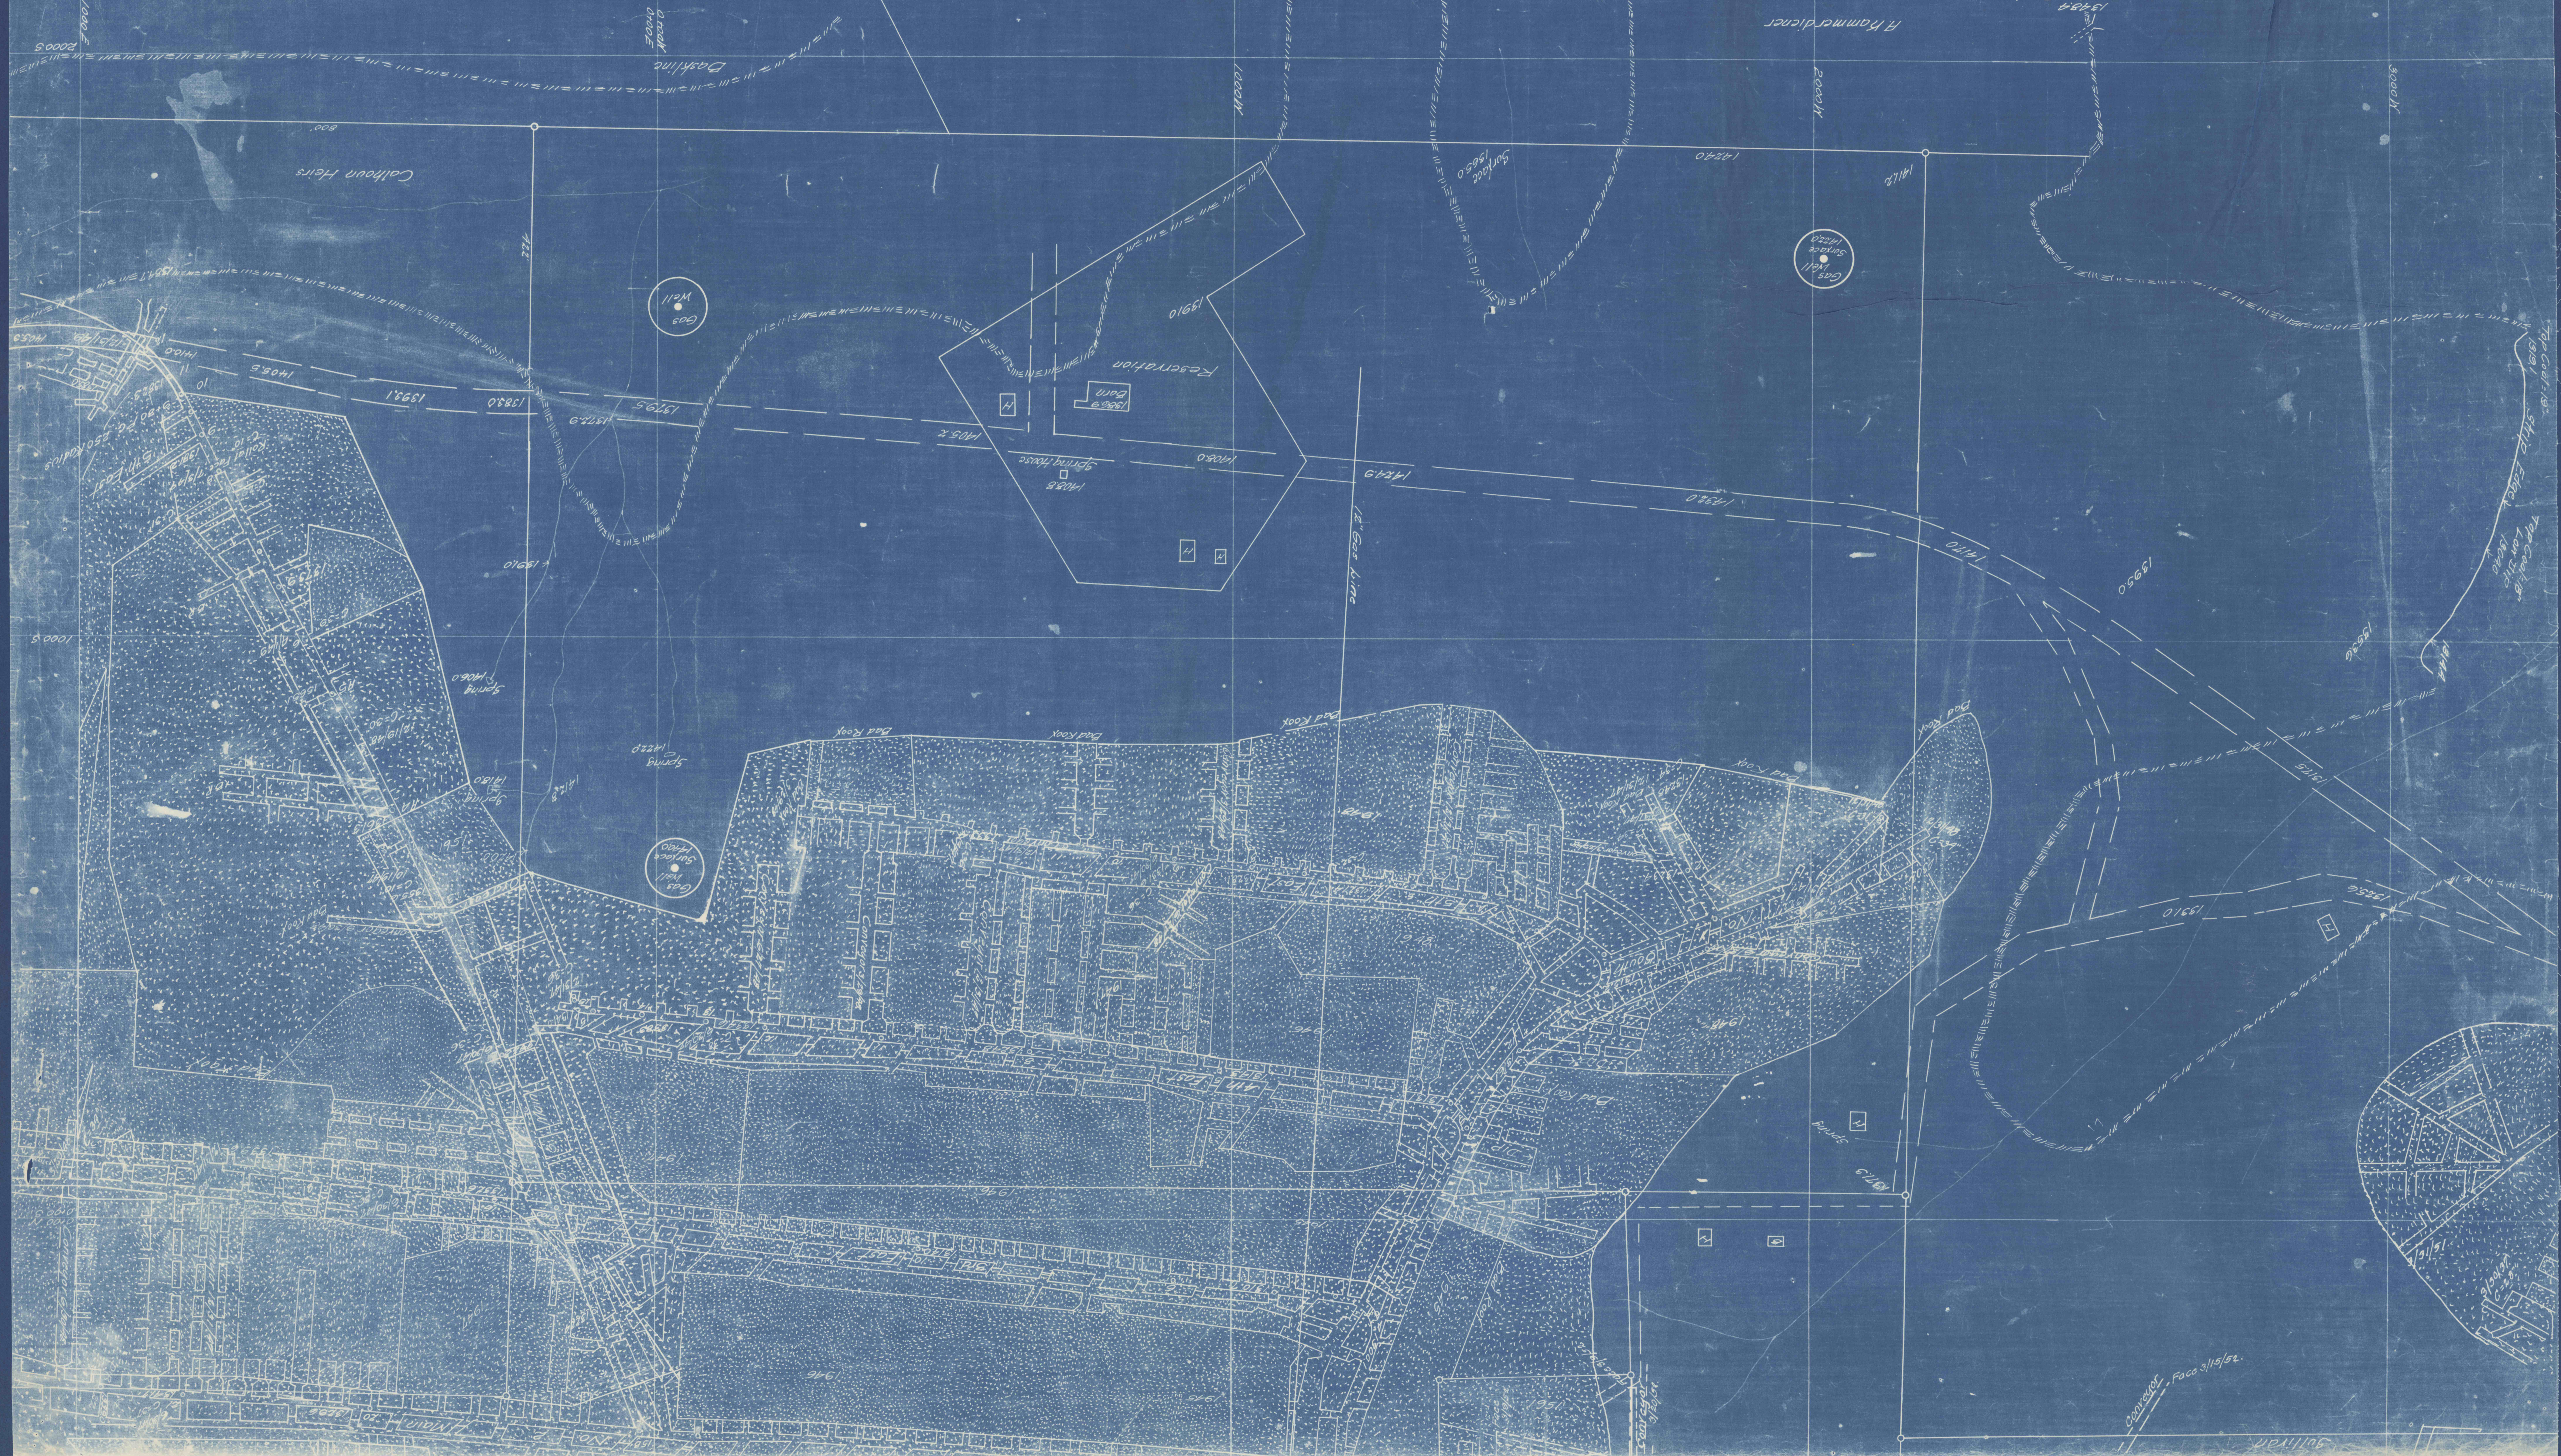


South Hill Coal Company
 Geneco Mine No. 1
 Wayne Twp. Armstrong Co. Pa. March 31, 1938.
 Scale 1"=100'
 6 Sheets
 Sheet No. 1
 June 30, 1947
 December 31, 1948
 March 31, 1949
 July 1, 1949
 June 30, 1949
 September 30, 1949
 December 31, 1949
 August 31, 1950
 March 31, 1951
 December 31, 1951

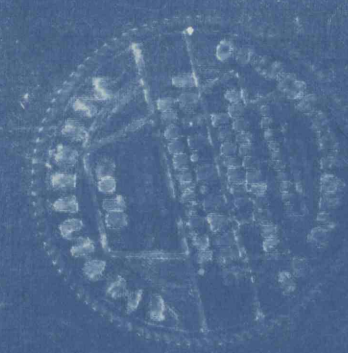

