

MANGES HEIRS

WEYANT EST.

NOAH BLOUGH

NOAH BLOUGH C Coal
 Area inside Cropline = 51.25 AS.
 " " 150' line = 36.00 AS.
 " mined to 11-5-20 = 4.25 " (see p. 28)

JOSEPH MANGES RESERVATION
 5 ACRES

MAP SHOWING
 MINING OPERATIONS
 OF THE
SHADE CREEK COAL CO.
 MINE NO 3

SHADE TWP.
 JAN. 14, 1918


SOMERSET CO. PA.
 SCALE 1" = 100'

Fetterman Eng. Co.

JOSEPH MANGES

LEGEND


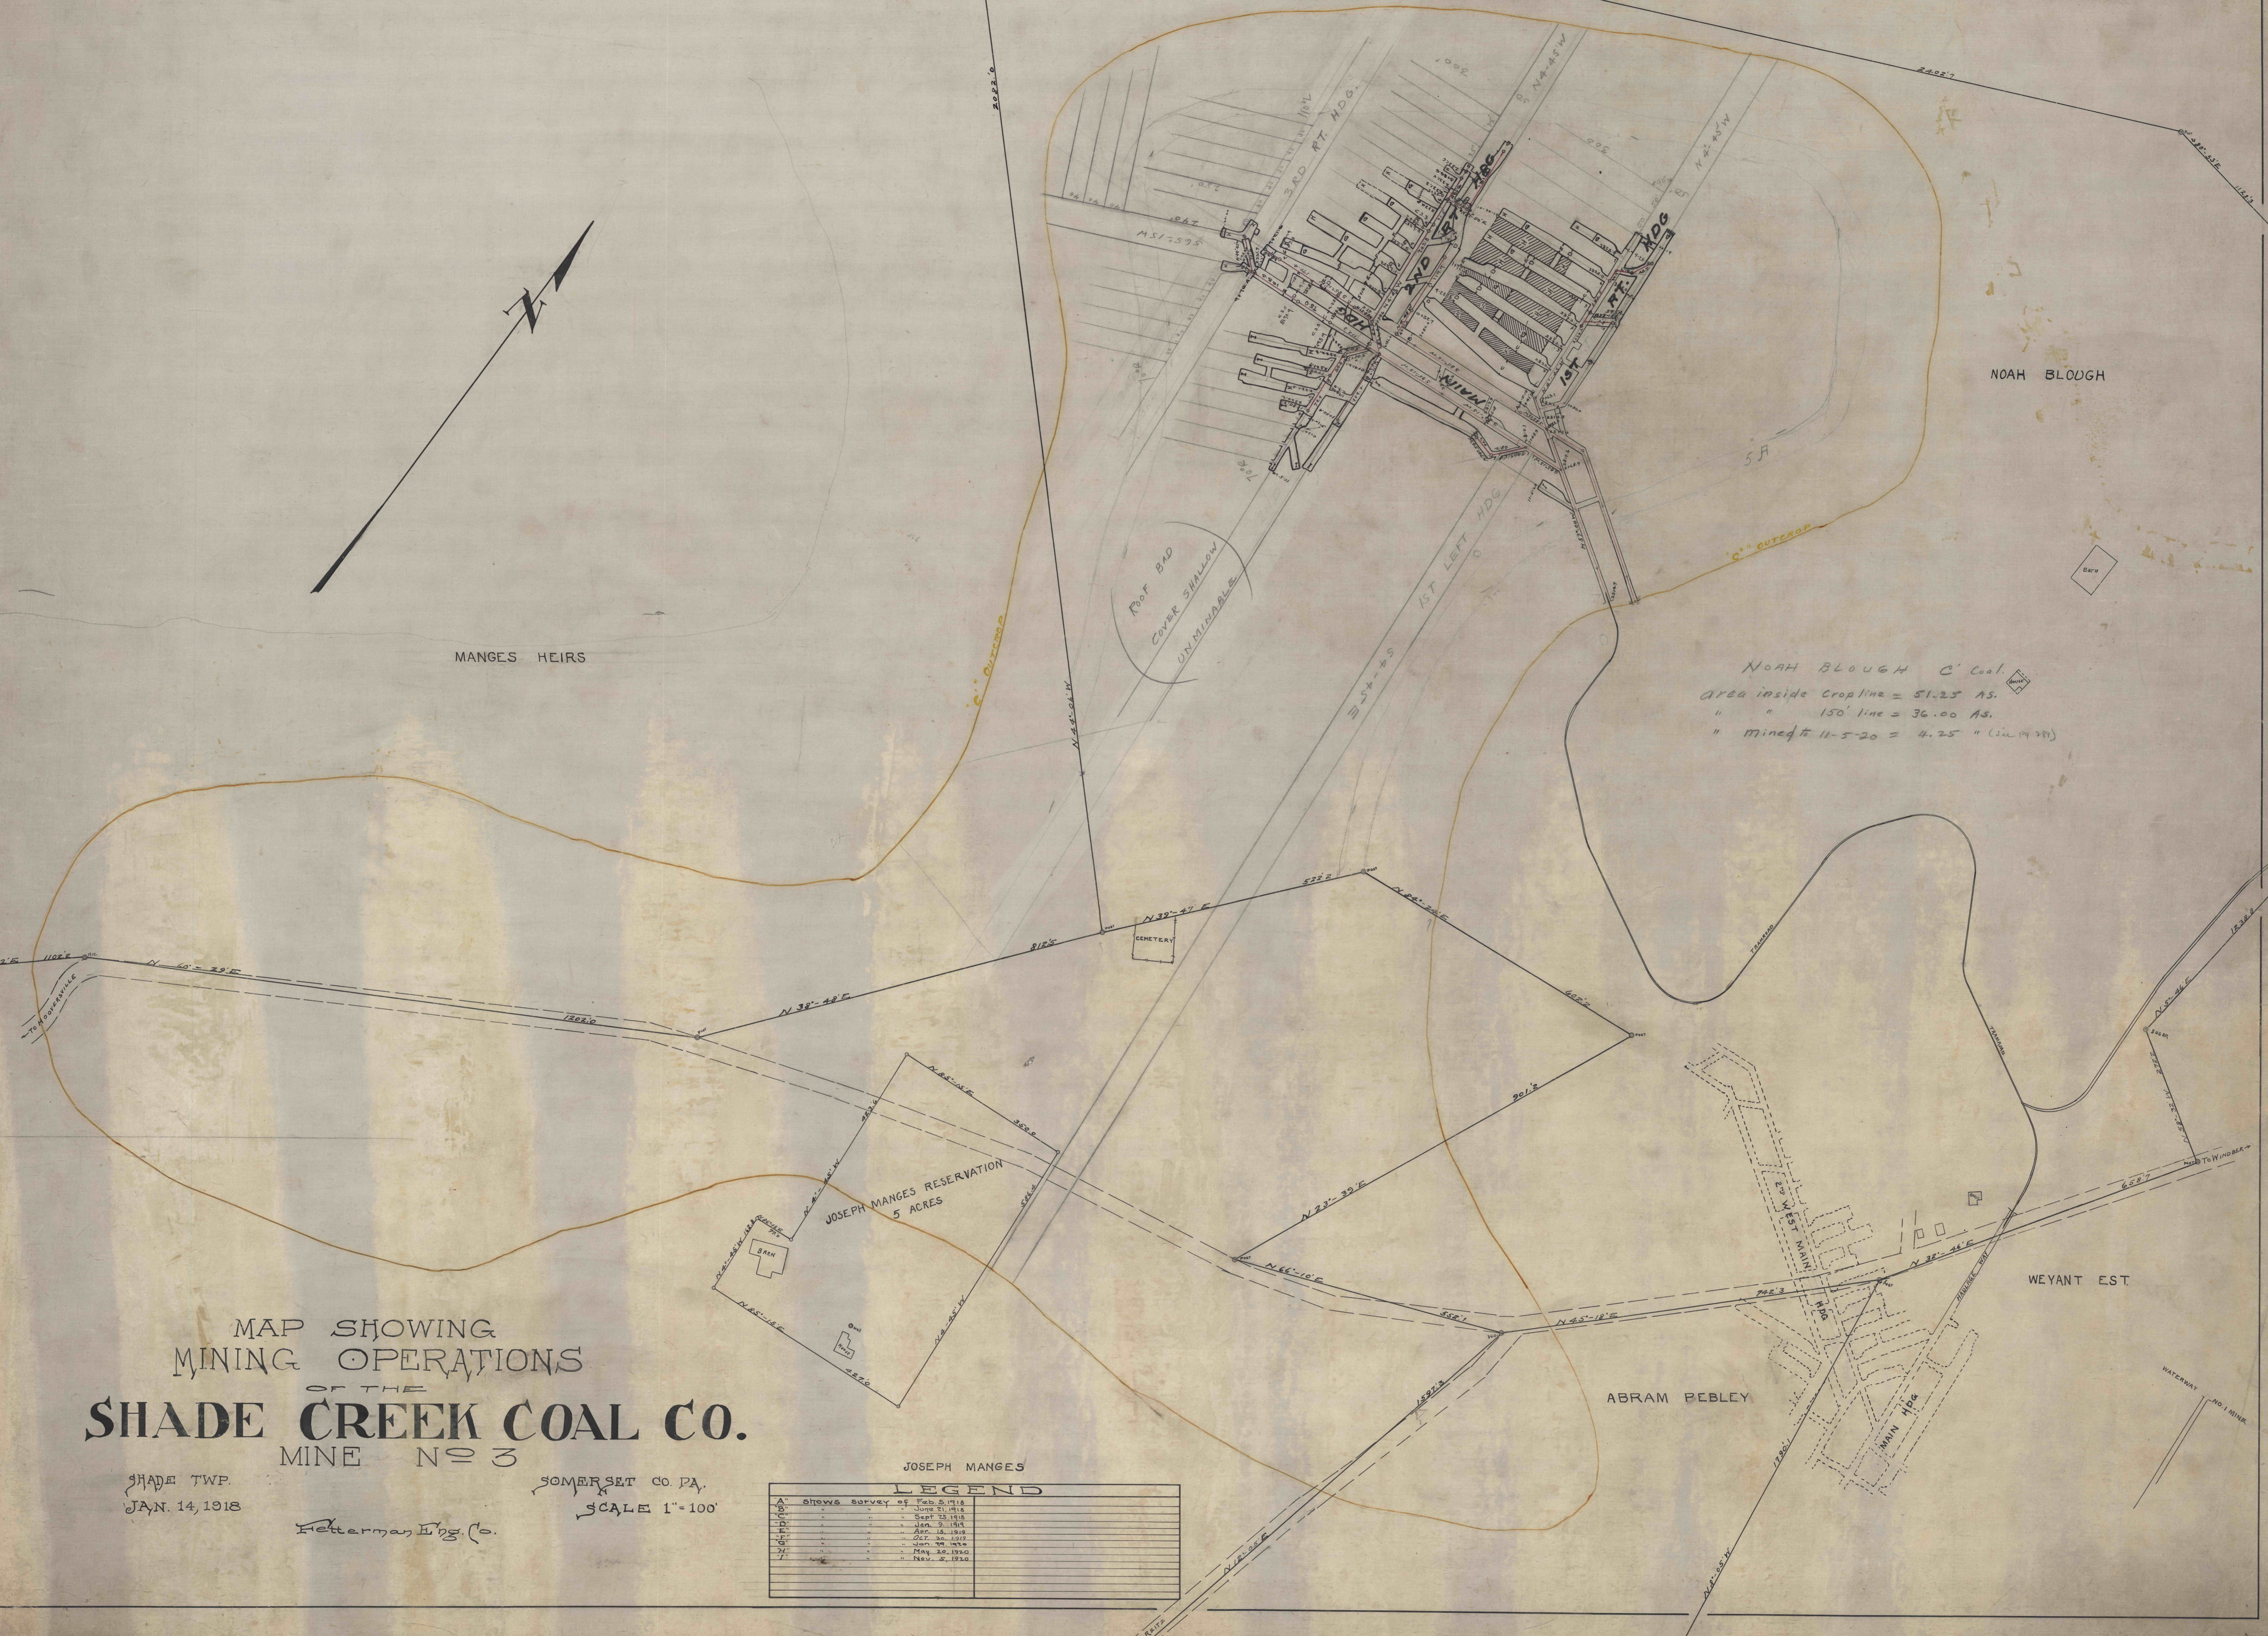

ABRAM PEBLEY

WEYANT EST.

WATCHWAY
 NO. 1 MINE