


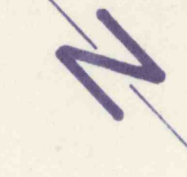

50000
50000




- TO
- CONTEMPLATED MINING
- SUPPORT AREA
- PROTECTED STRUCTURE
- MINING COMPLETED

50000
50000

TO REITZ # 384 MINE

7

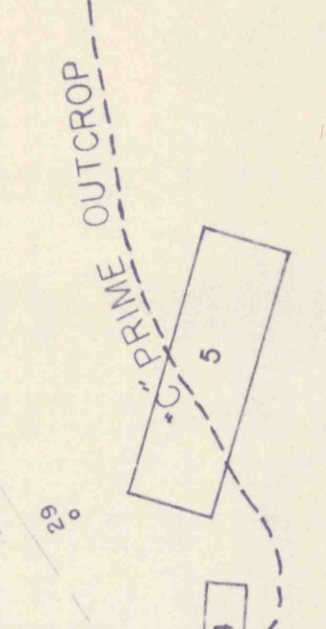

SHIPPED AND BACKFILLED
50 BARRIER

50000
50000

MATCH LINE - SEE SHEET 3

MATCH LINE - SEE SHEET 2

P.B.S. COALS, INC. SHADE #1 MINE "C" PRIME SEAM

SHADE TOWNSHIP, SOMERSET COUNTY, PENNSYLVANIA
SCALE: 1" = 100'
DONALD R. DUNCAN
REGISTERED SURVEYOR
15228-E
SHEET

