


- CONTEMPLATED MINING
- SUPPORT AREA
- PROTECTED STRUCTURE
- MINING COMPLETED

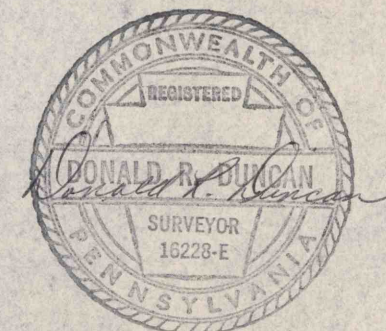

P.B.S. COALS, INC.
SHADE #1 MINE
 "C" PRIME SEAM
 SHADE TOWNSHIP, SOMERSET COUNTY, PENNSYLVANIA
 SCALE: 1" = 100' DATE: FEB 12 1973
 DONALD R. DUNCAN SHEET
 R.S. 16228-E 1-A