
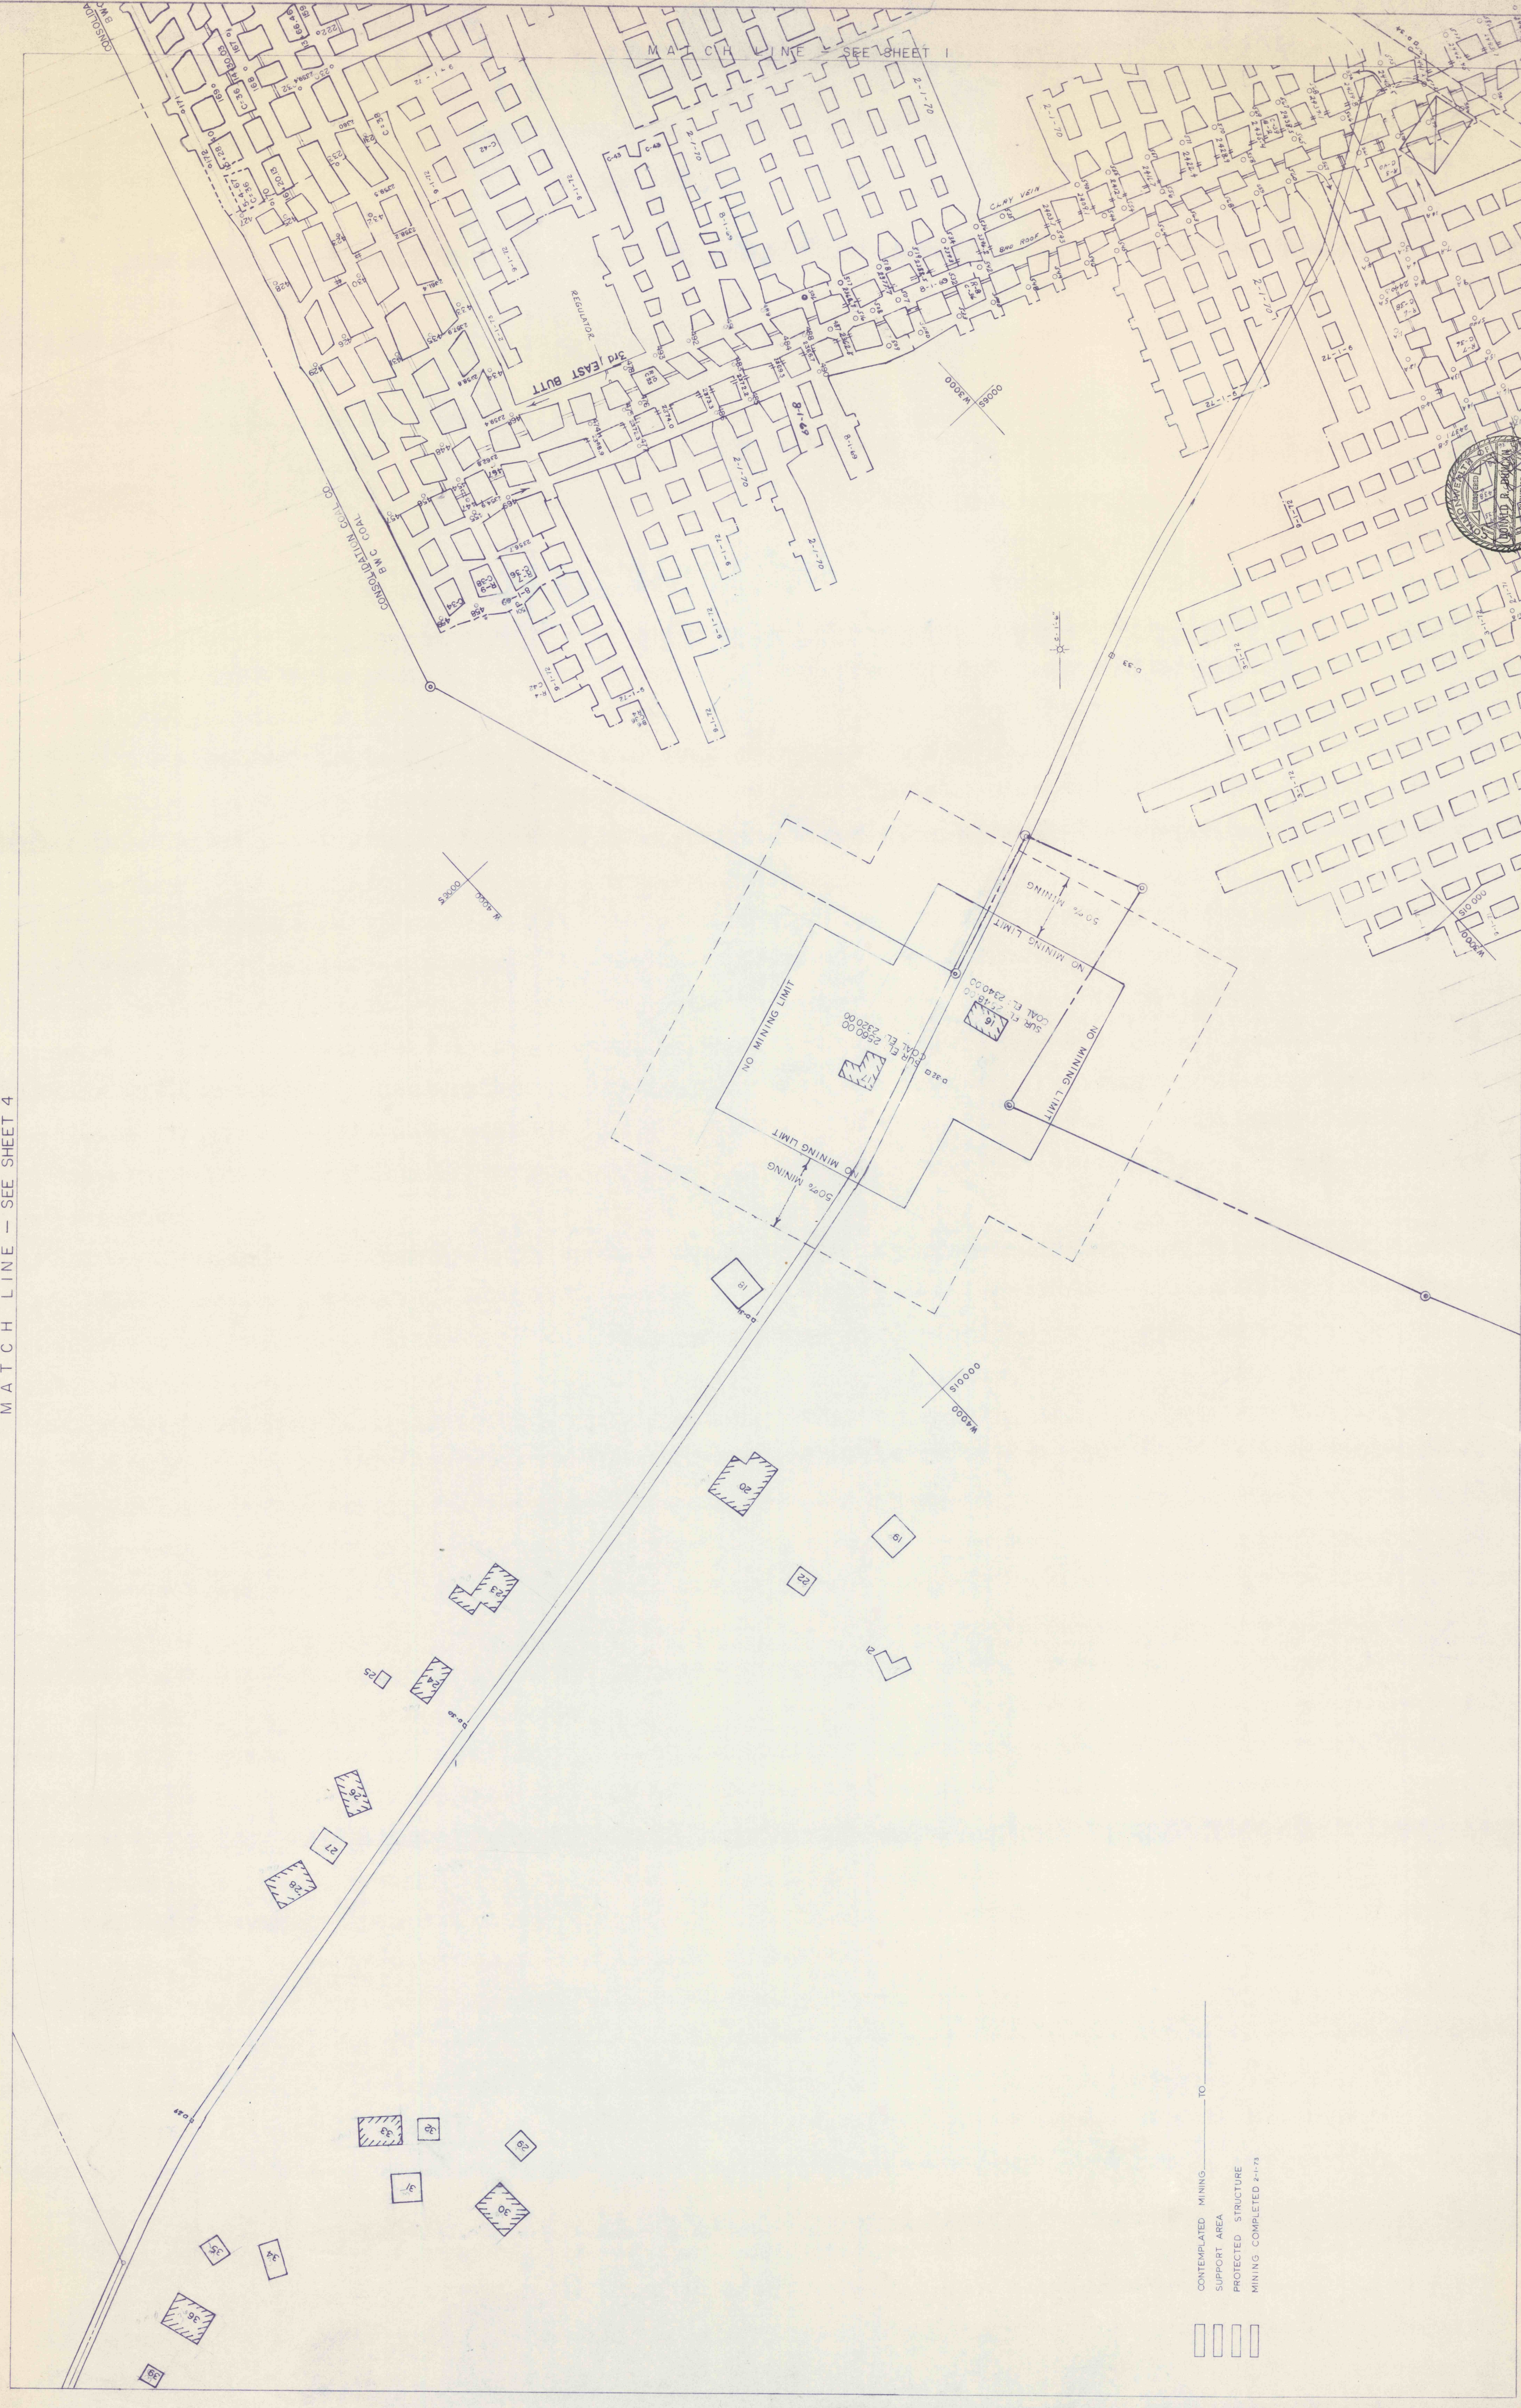


MATCH LINE - SEE SHEET 4

MATCH LINE - SEE SHEET 1

SHEET 2

P.B.S. COALS, INC. SHADE #1 MINE
FEB 12 1973

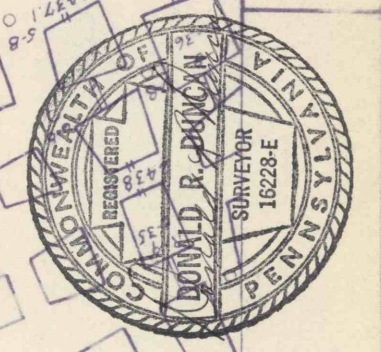

CONTEMPLATED MINING ——— TO ———
 SUPPORT AREA ———
 PROTECTED STRUCTURE ———
 MINING COMPLETED ———