

MATCH LINE - SEE SHEET 7




W4000 53000

W4000 44000

- CONTEMPLATED MINING
- SUPPORT AREA
- PROTECTED STRUCTURE
- MINING COMPLETED

MATCH LINE - SEE SHEET 6

MATCH LINE - SEE SHEET 5

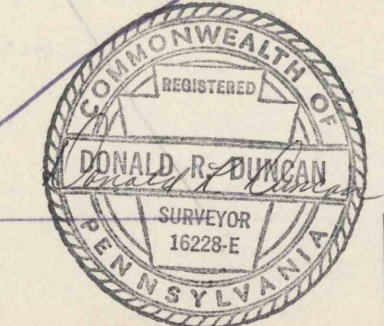

P.B.S. COALS, INC. SHADE #1 MINE

FEB 12 1973

SHEET 5