


GREEN MINE LEASE
(M.M.C.)

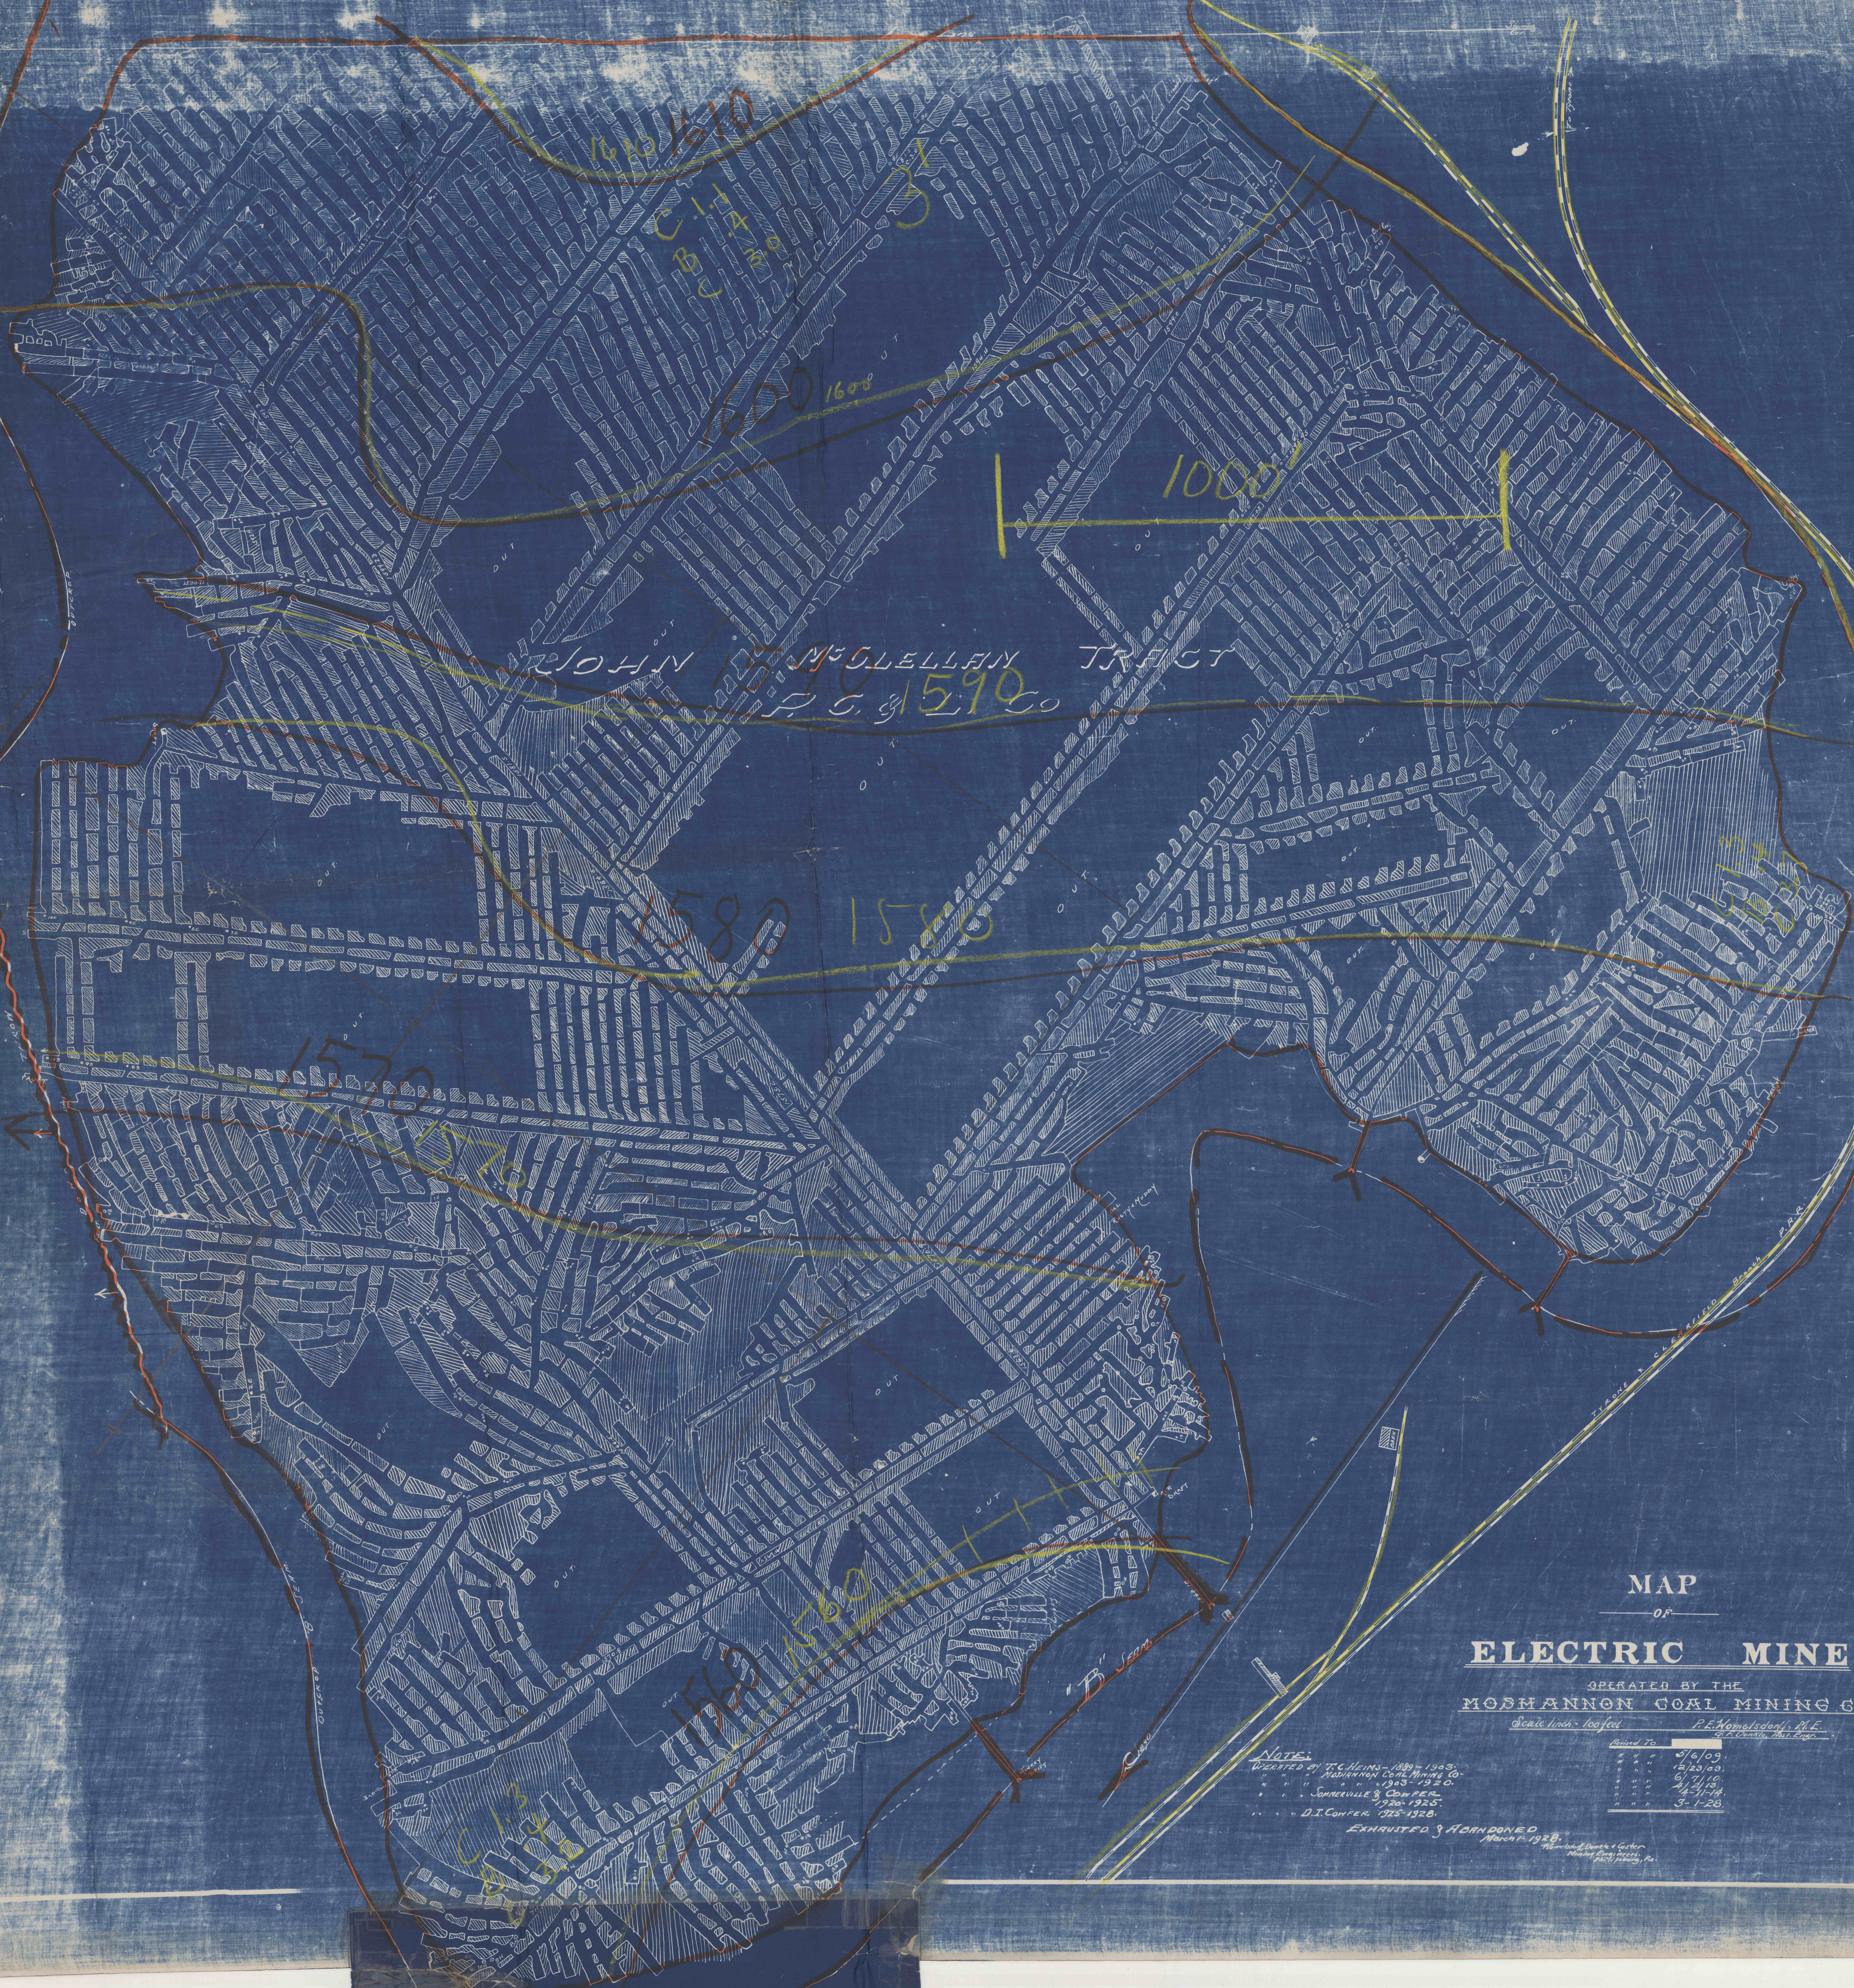

JOHN McLELLAN TRACT
P. O. # 1590

1580 1580

1570 1570

1560 1560




MAP
OF

ELECTRIC MINE

OPERATED BY THE
MOBHANNON COAL MINING CO.

Scale Inch - 100 feet
P.E. Homestead, P.E.
of the State of Pa.

NOTE:

EXHAUSTED & ABANDONED
March 1, 1928.


