


Plan No. 8 2810

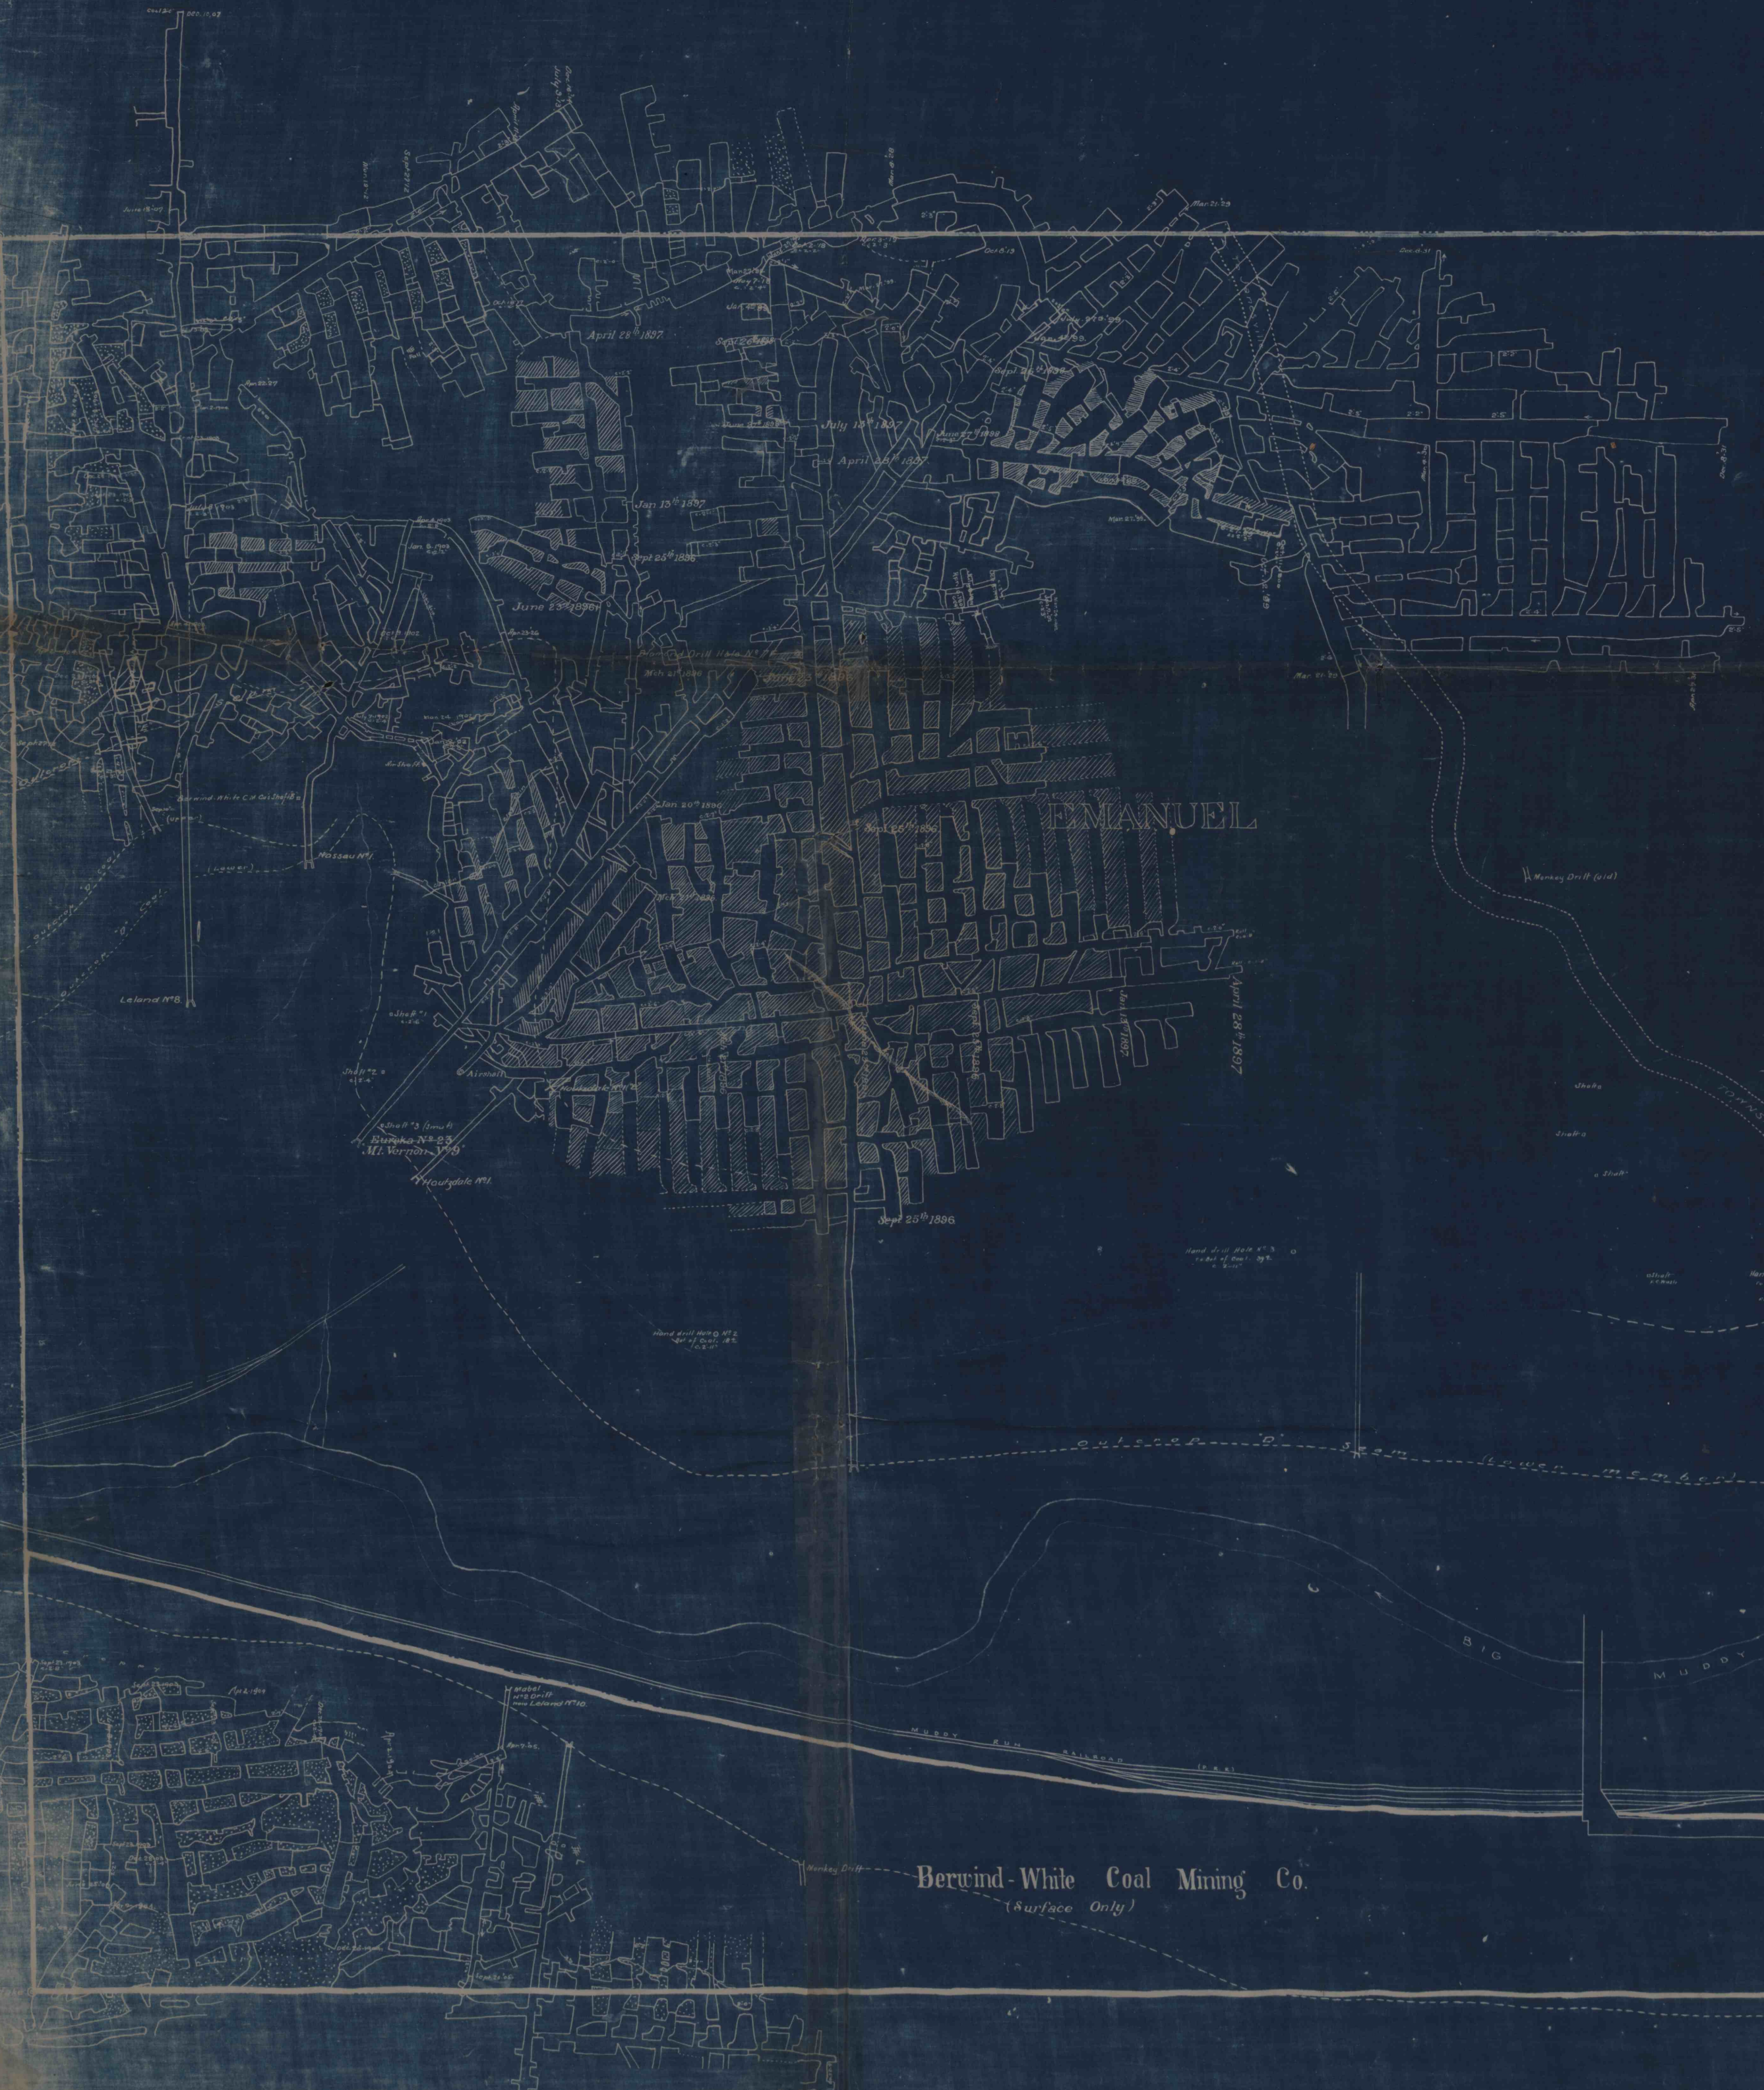

REIGHART

TRACT

Berwind-White Coal Mining Co.  
(Surface Only)

Scale 1"=100'


