


Lingle Coal Co.  
Coal Mines  
Goshen Twp., Clarfield Co.  
Scale - 1 inch = 100 feet.  
Yost, Brumfield, & Hess  
June 21, 1900  
NB: 257, 259A, 271  
File 1342A

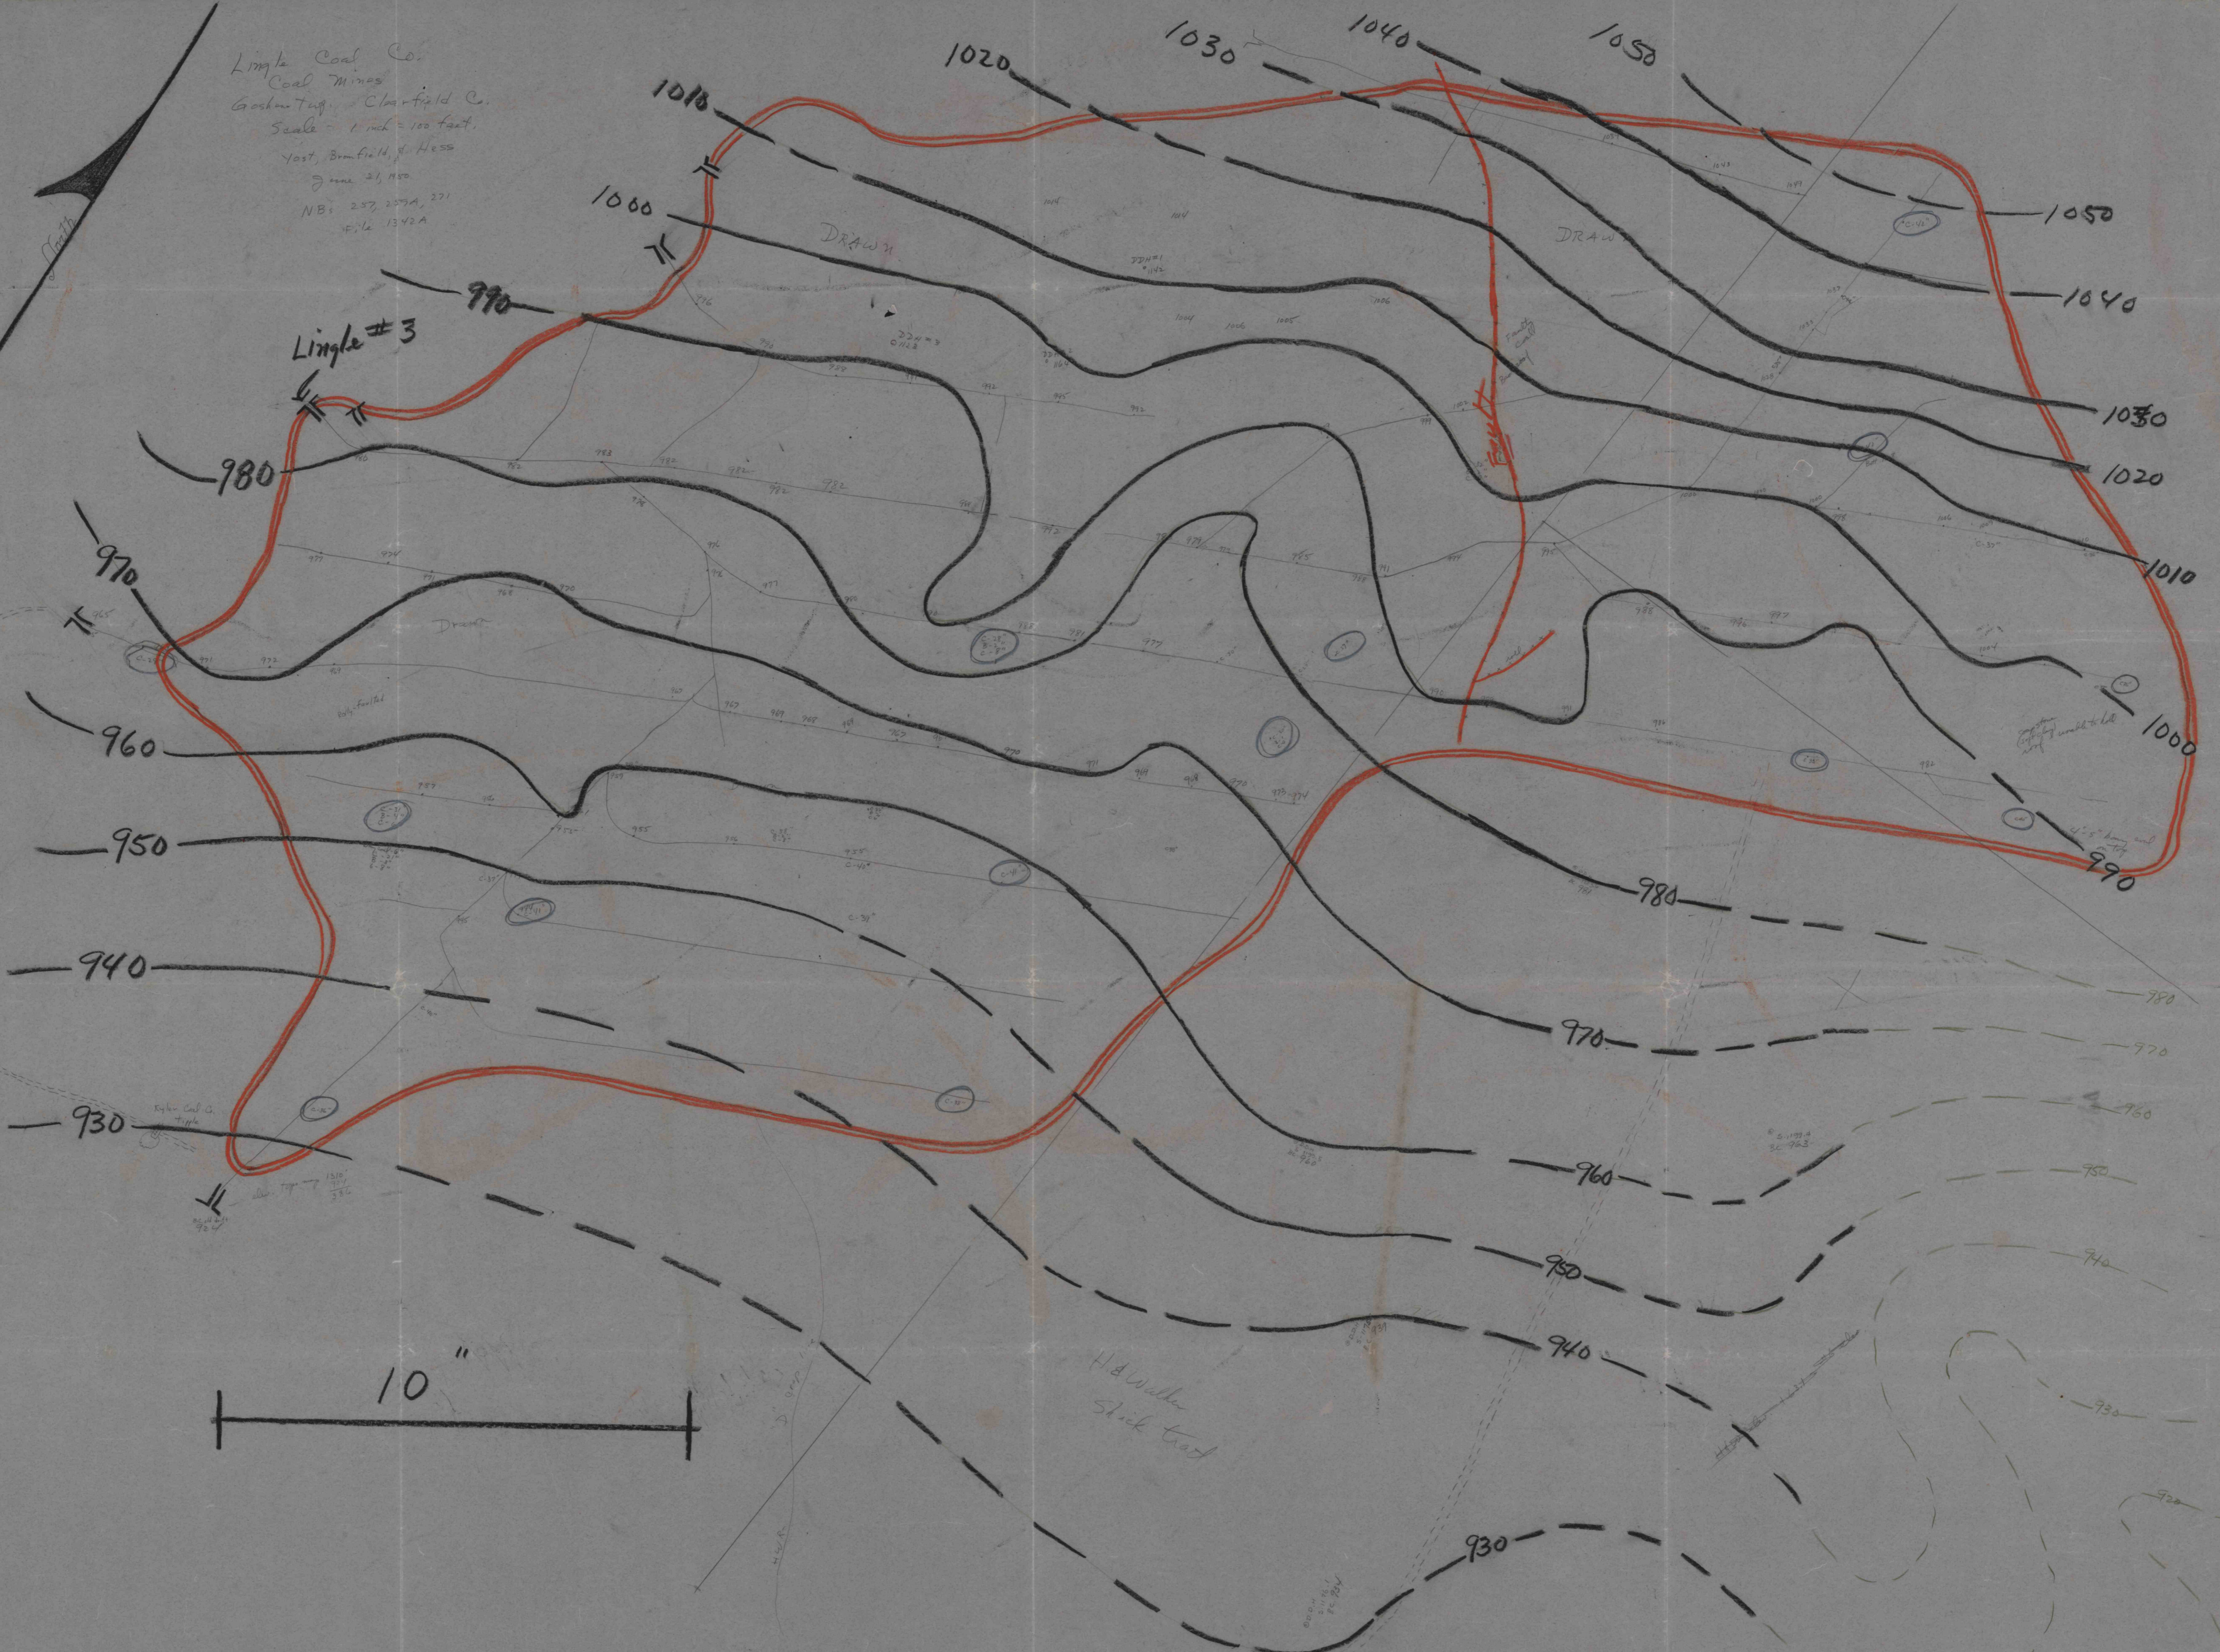

10"

H. & W. stick track

Lingle #3

DRAWN

DRAWN