


MAP SHOWING WORKINGS
 OF
 LOST RUN COAL CO. SITUATED
 IN
 BELL TOWNSHIP CLEARFIELD CO. PA.
 Scale 1"=100' Date Apr. 12-1920

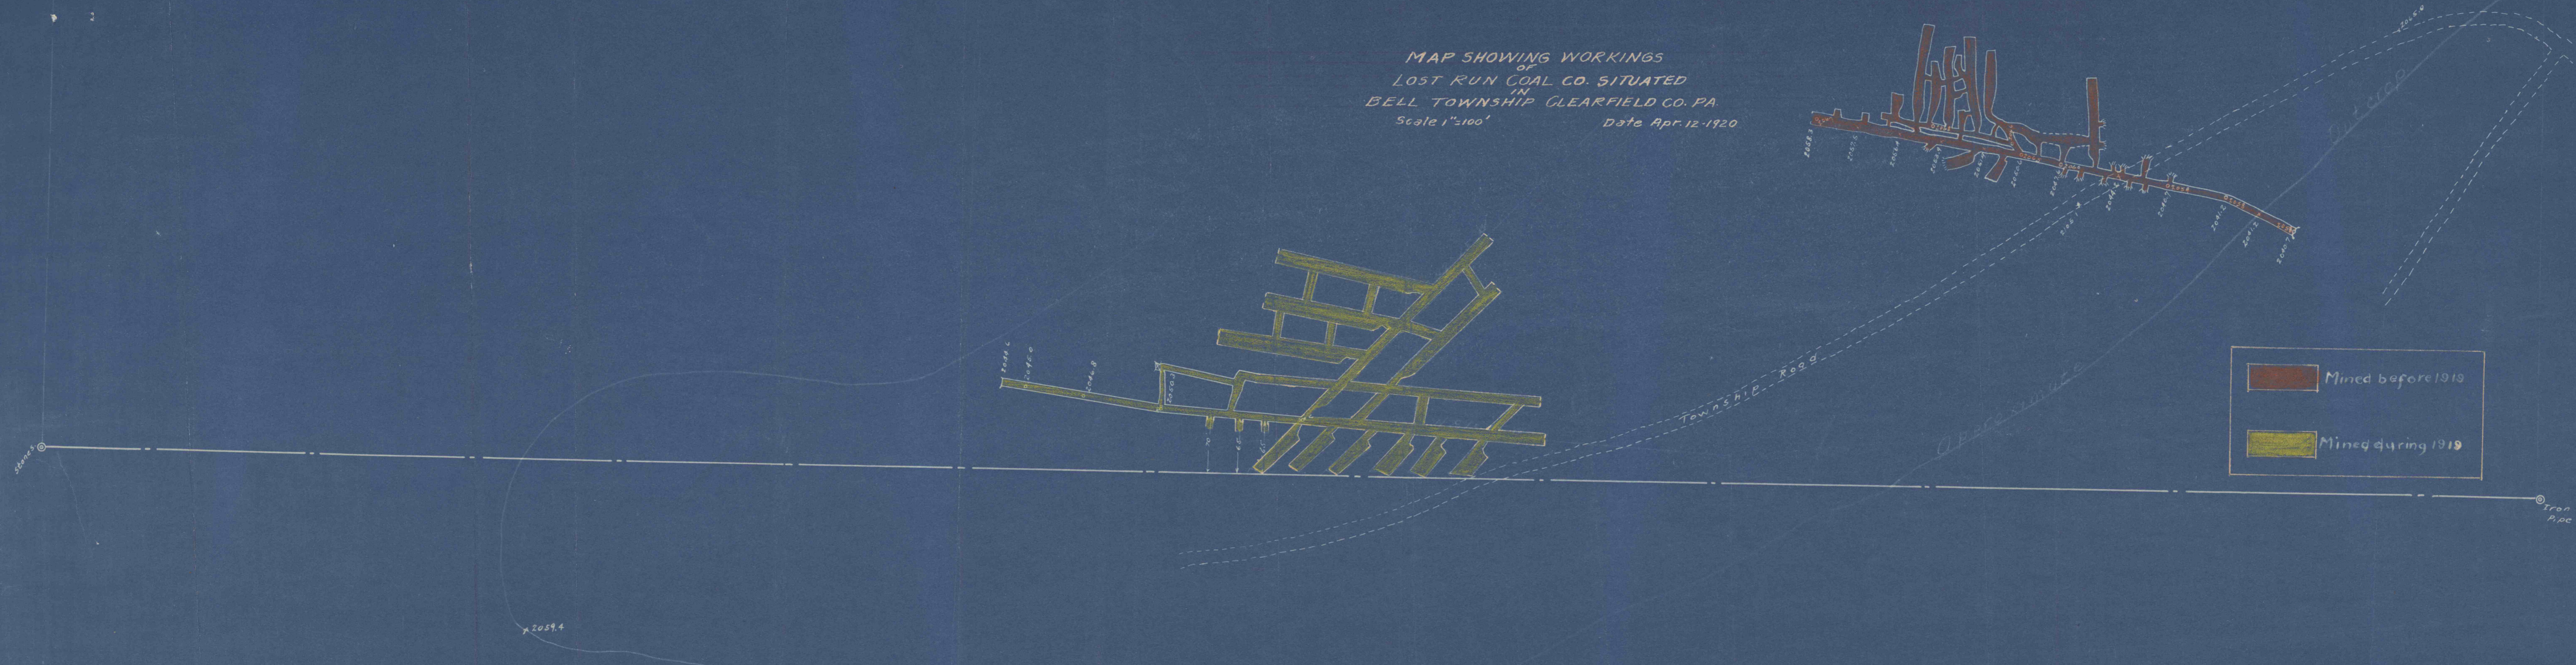

	Mined before 1919
	Mined during 1919

stone

2059.4

Iron Pipe

TOWNSHIP ROAD

DIP CROP