


APPROXIMATE LOCATION OF

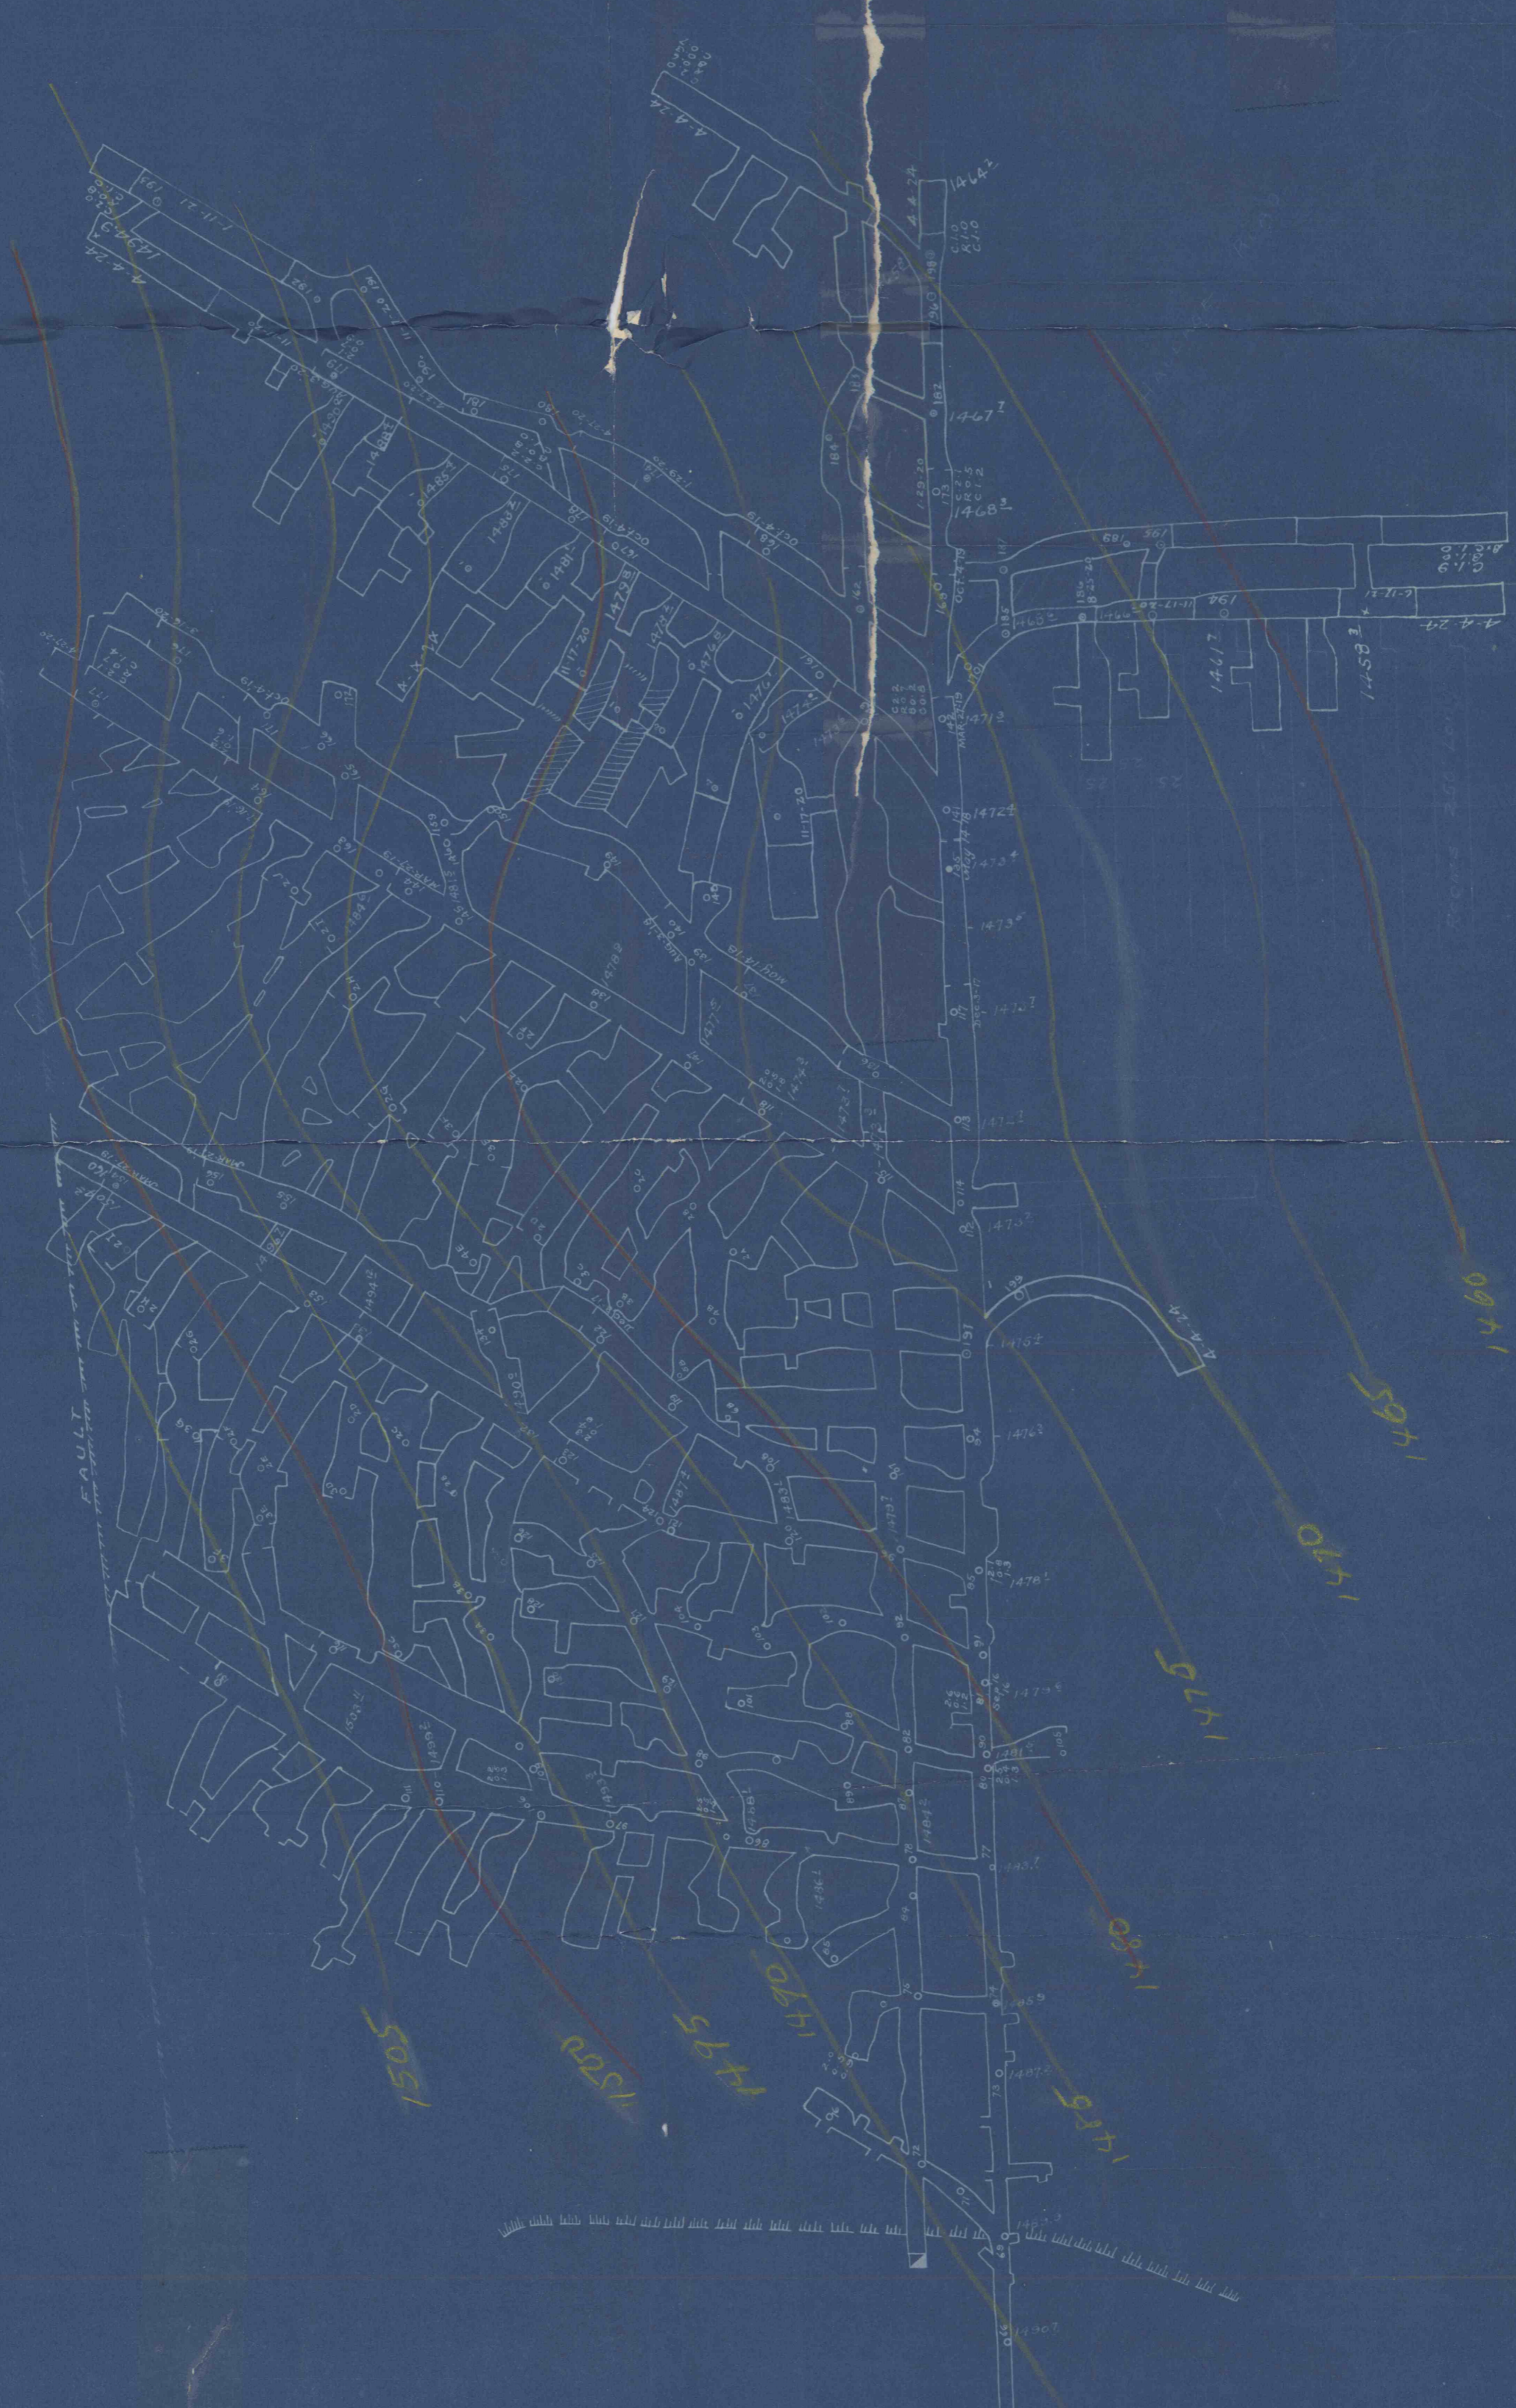

H A L L E E S T A T E

MAP OF
MOSHANNON NO. 12

OPERATED BY THE
MOSHANNON COAL MINING CO.

Scale inch = 100 Feet.

Handwritten signature and circular stamp