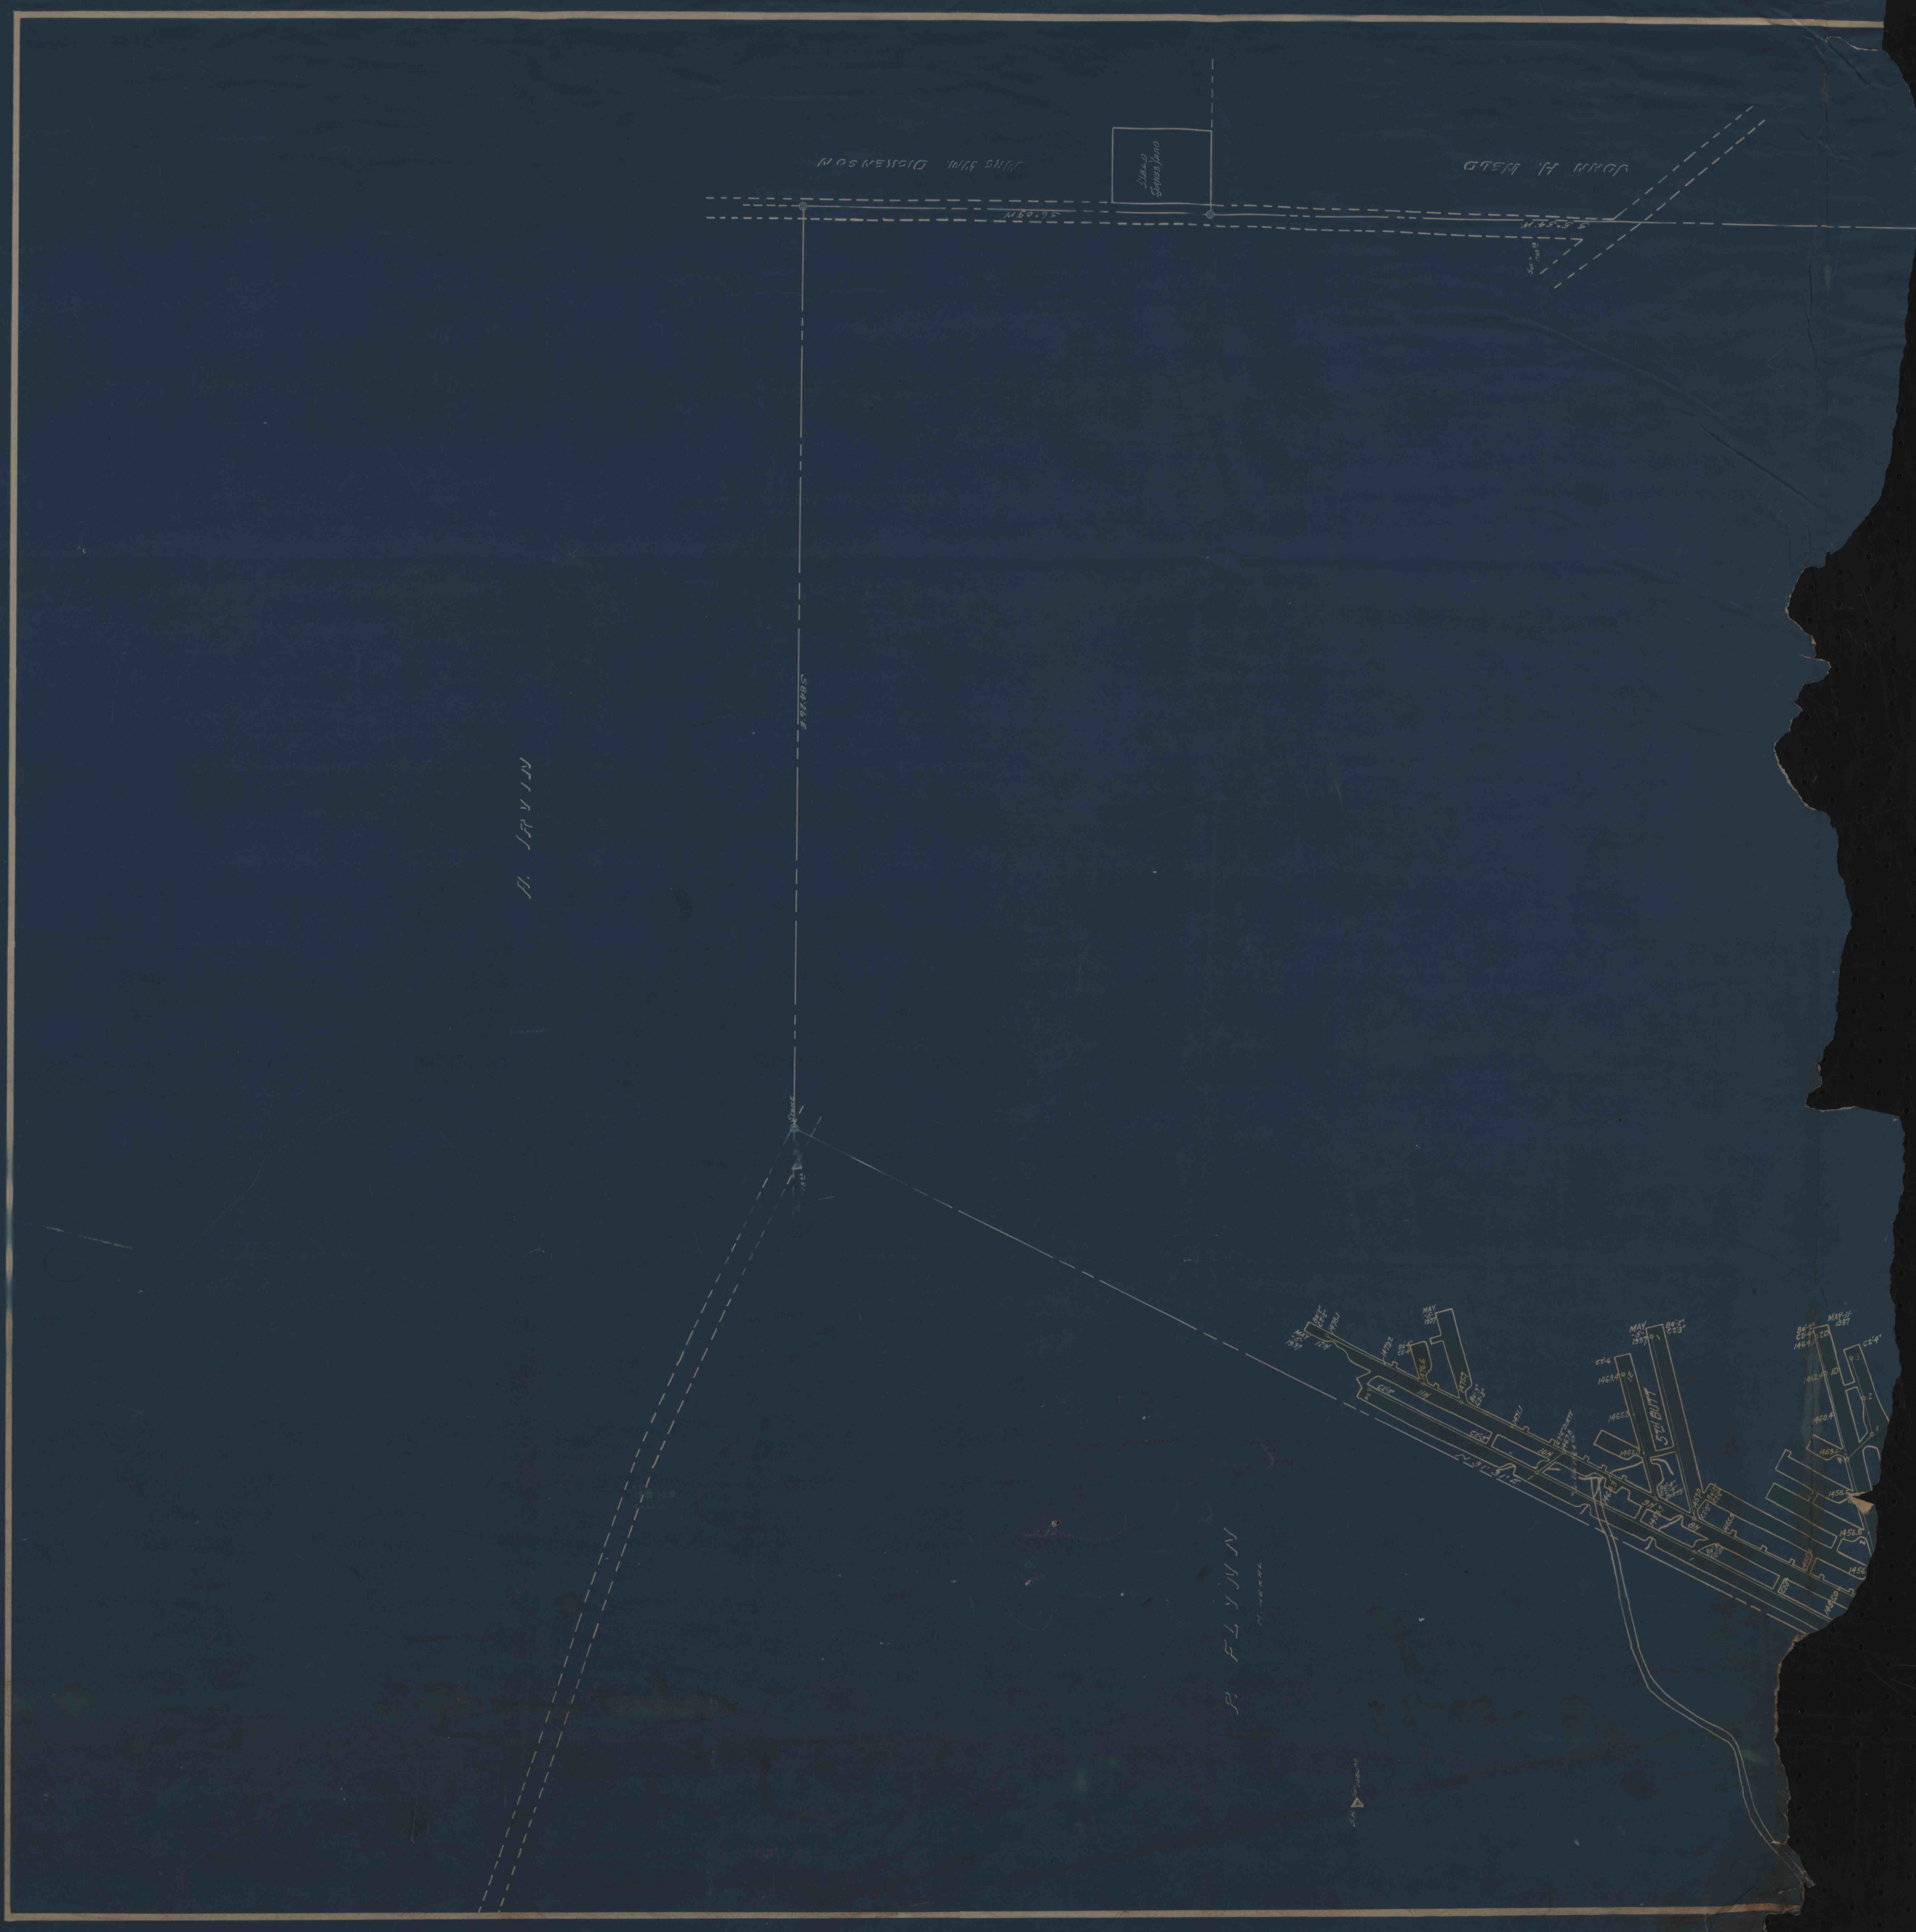
MRS. WM. DICKENSON
JOHN H. WELD
A. IRVIN
S 84°26' E
STONE
P. FLYNN
MINERAL
N 31°31' E
5TH BUTT
MAY -5- 1937
MAY-11-1937
DIRTY