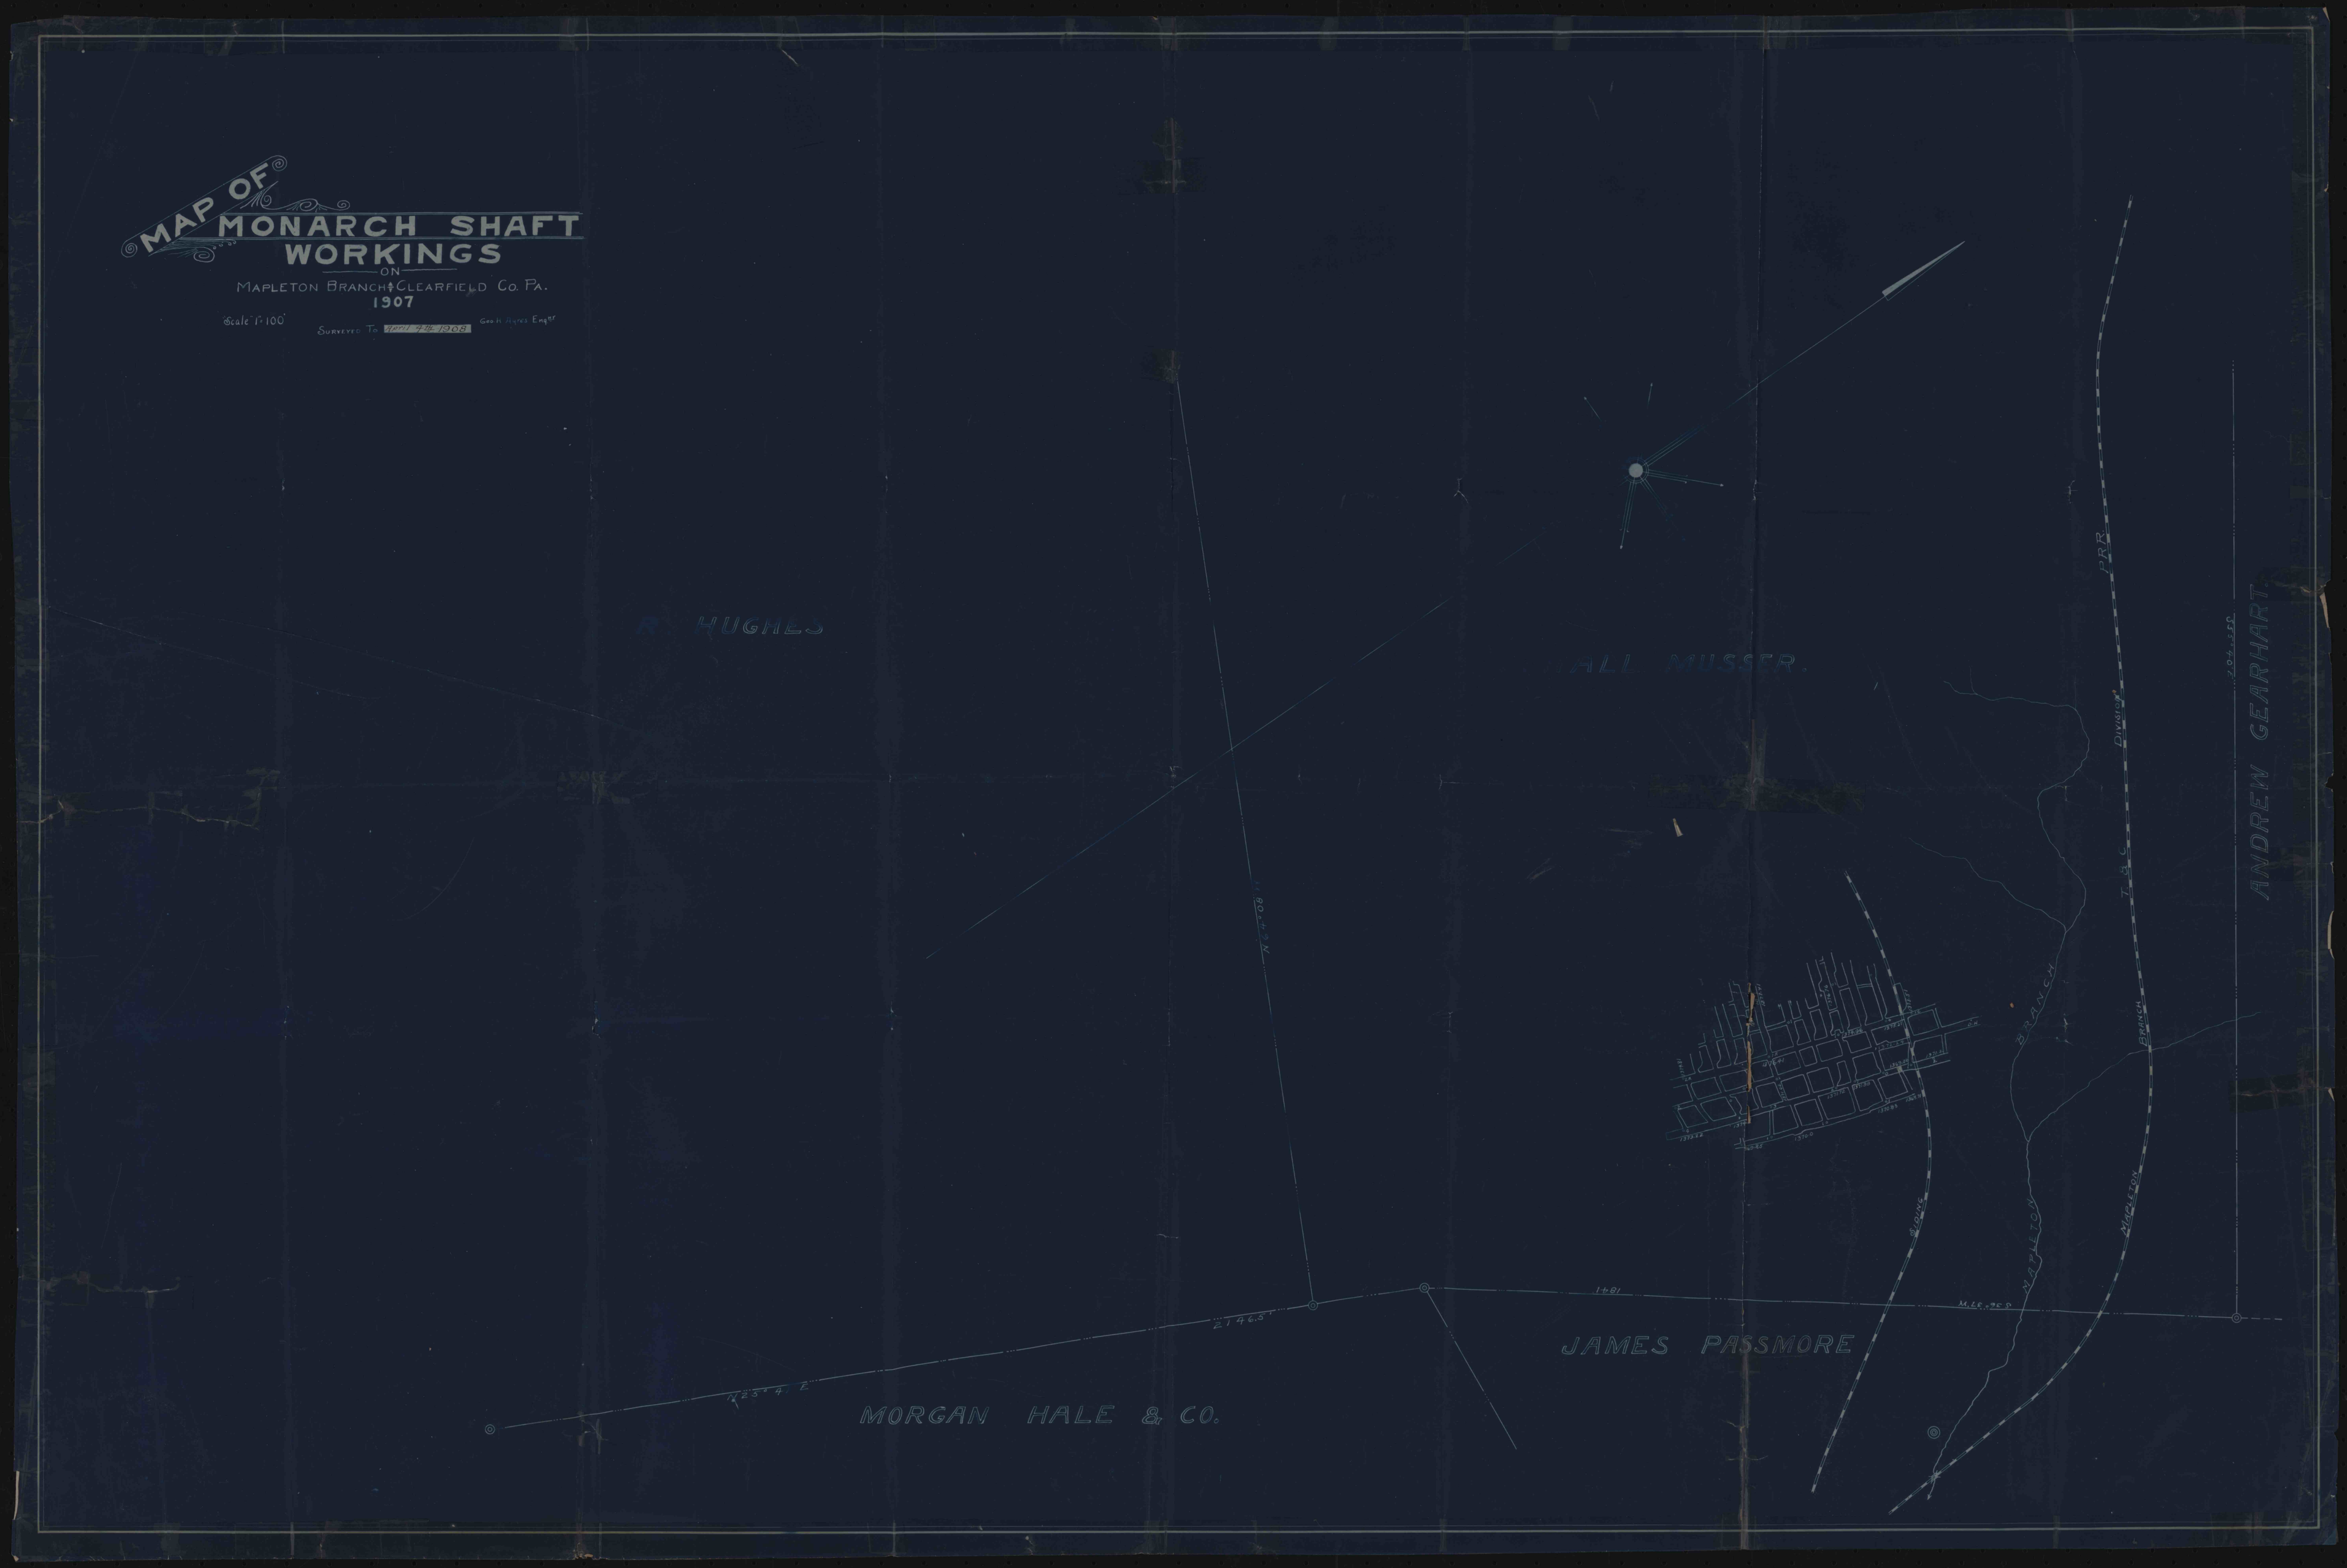
MAP OF
MONARCH SHAFT
WORKINGS
ON
MAPLETON BRANCH & CLEARFIELD CO. PA.
1907
Scale 1" = 100'
Surveyed To April 4th 1908
Geo. H. Ayres Engr
HUGHES
ALL MUSSER
ANDREW GEARHART
JAMES PASSMORE
MORGAN HALE & CO.
MAPLETON BRANCH
MAPLETON BRANCH
DIVISION
PRR
N 64° 08' W
N 25° 41' E
2146.5'
1481
M.L.R. 95.0