


SCALE 100 FT = 1 INCH

1926

IRWIN HILL MINES
BIRGE RUN-CLINTON CO.
STOWE-FULLER REFRACTORIES CO.

Structure Contours Added
to Map 12/7/44 - R.M.F. - Pa. Geol. Surv.

#8 "B" - 1062.7
#7 "A" - 1038.2

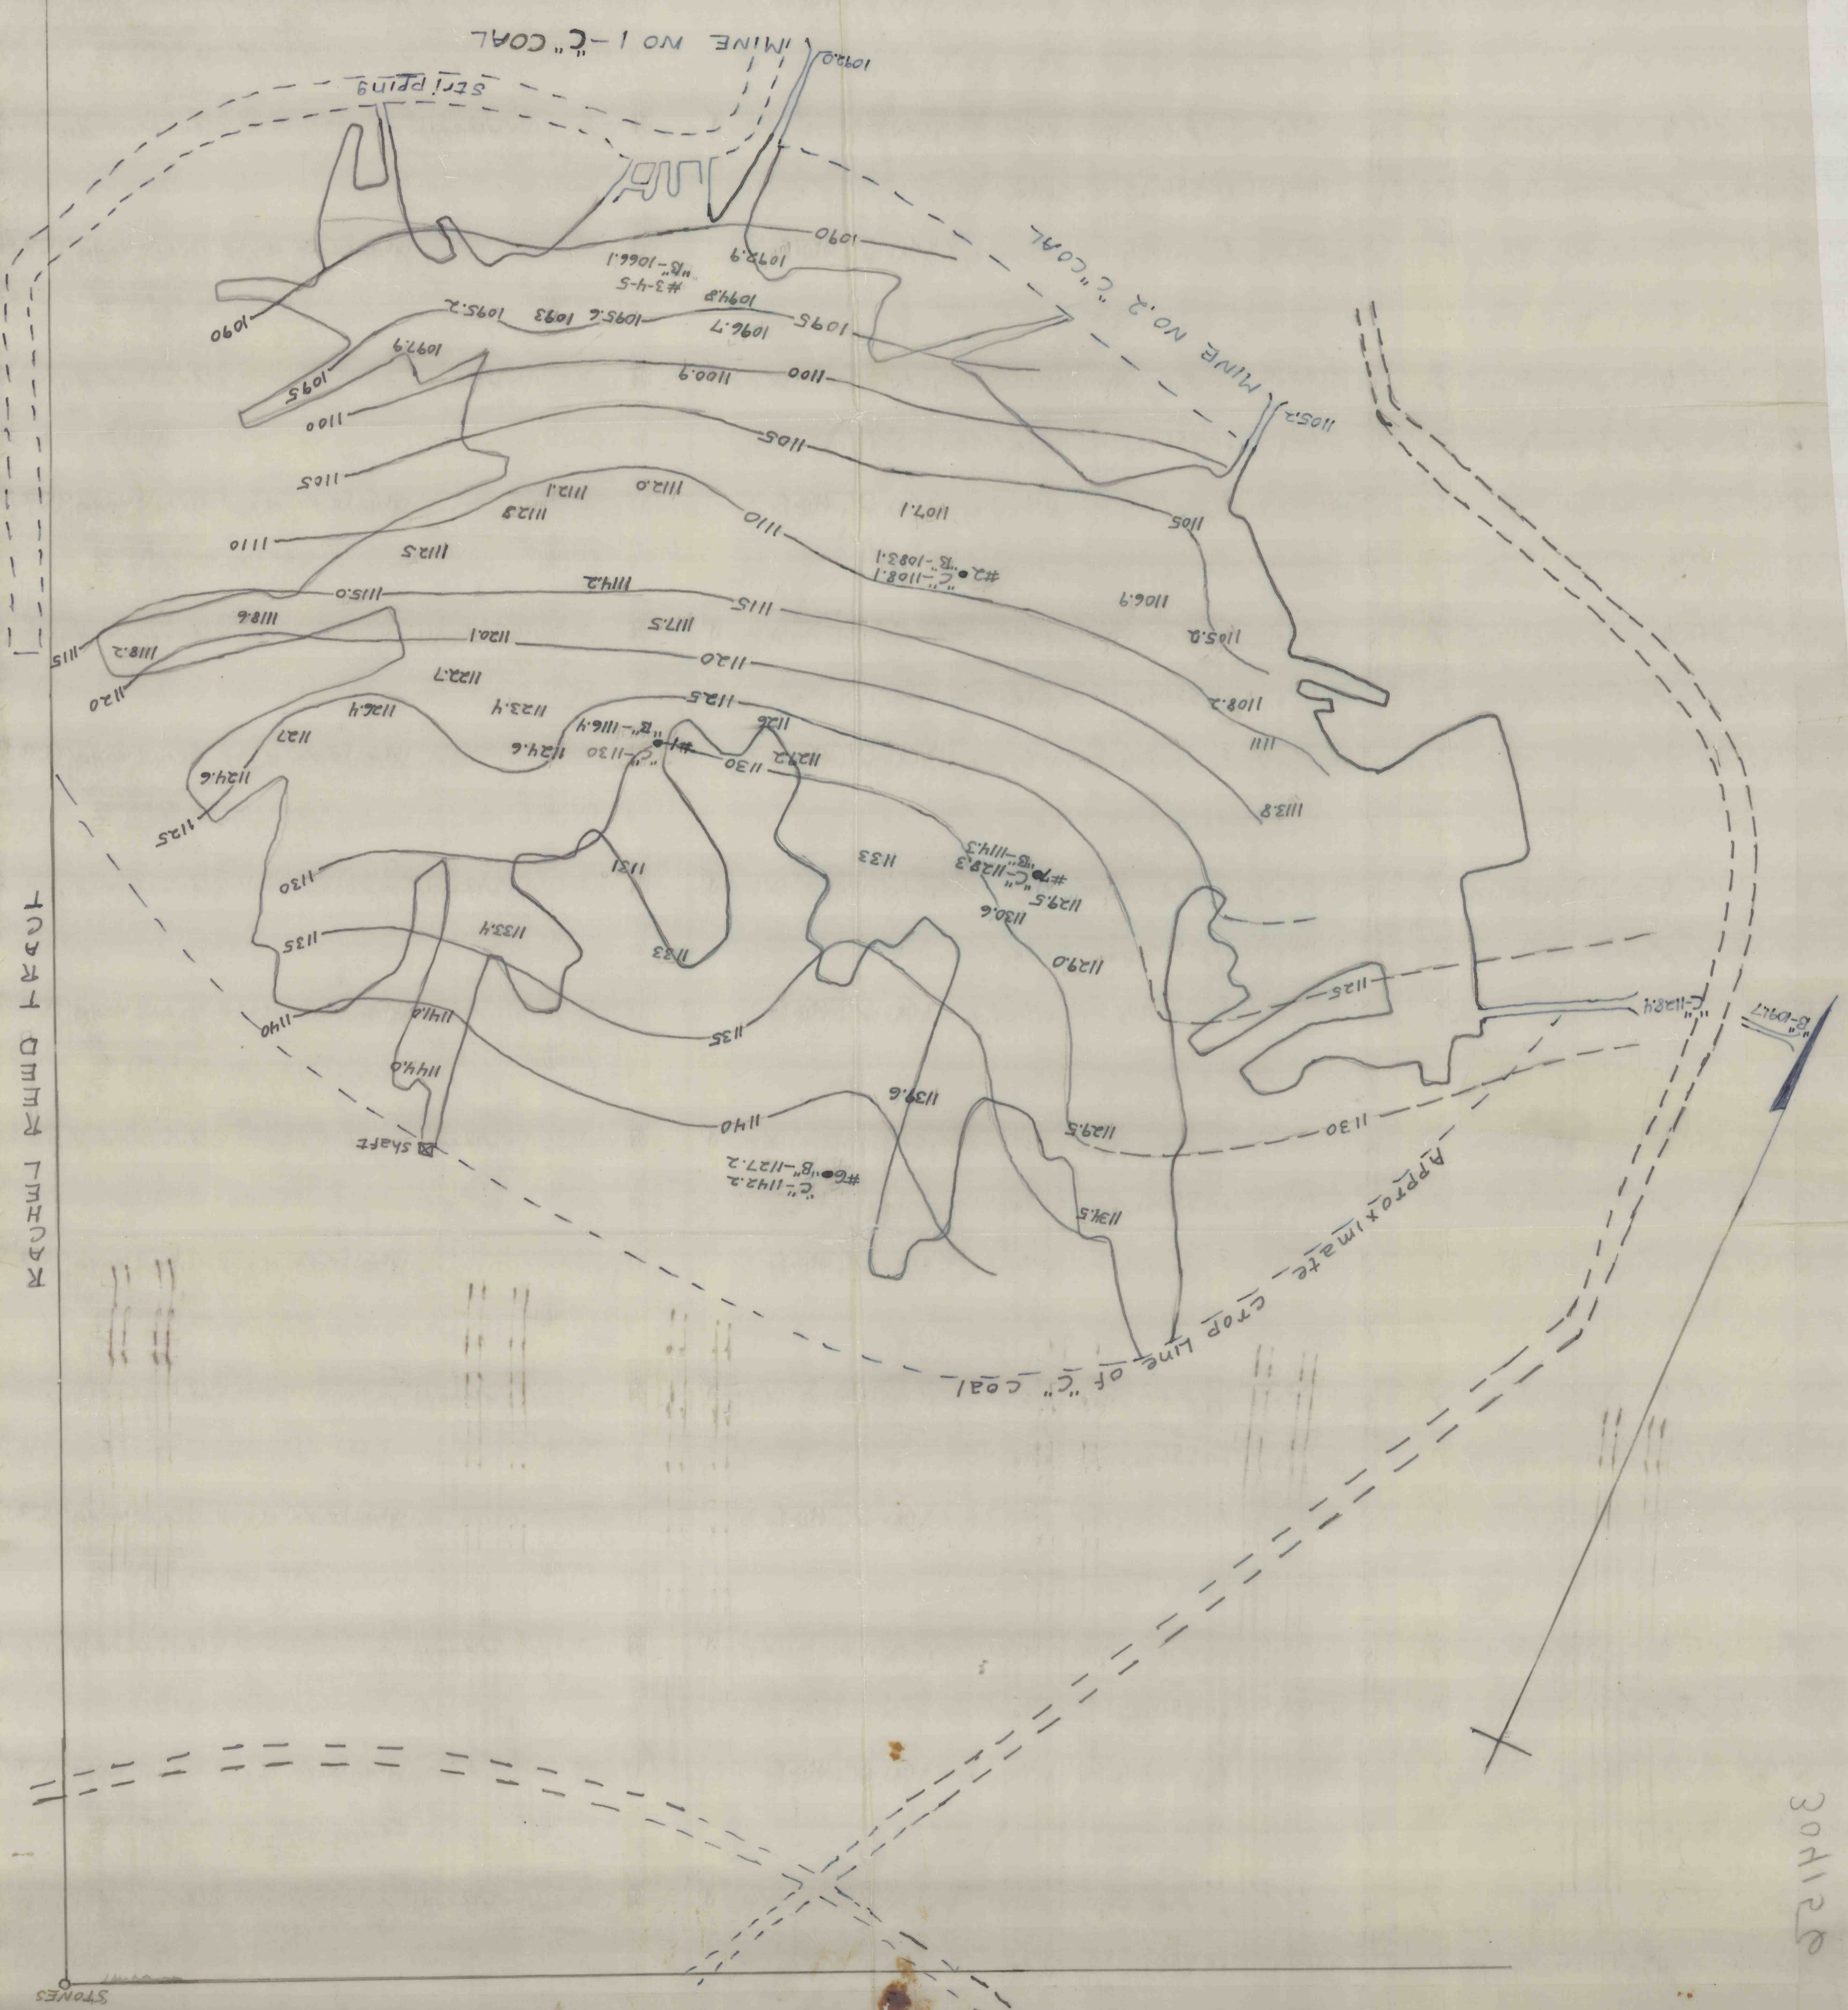

TERRACE

STONES

1926

304120