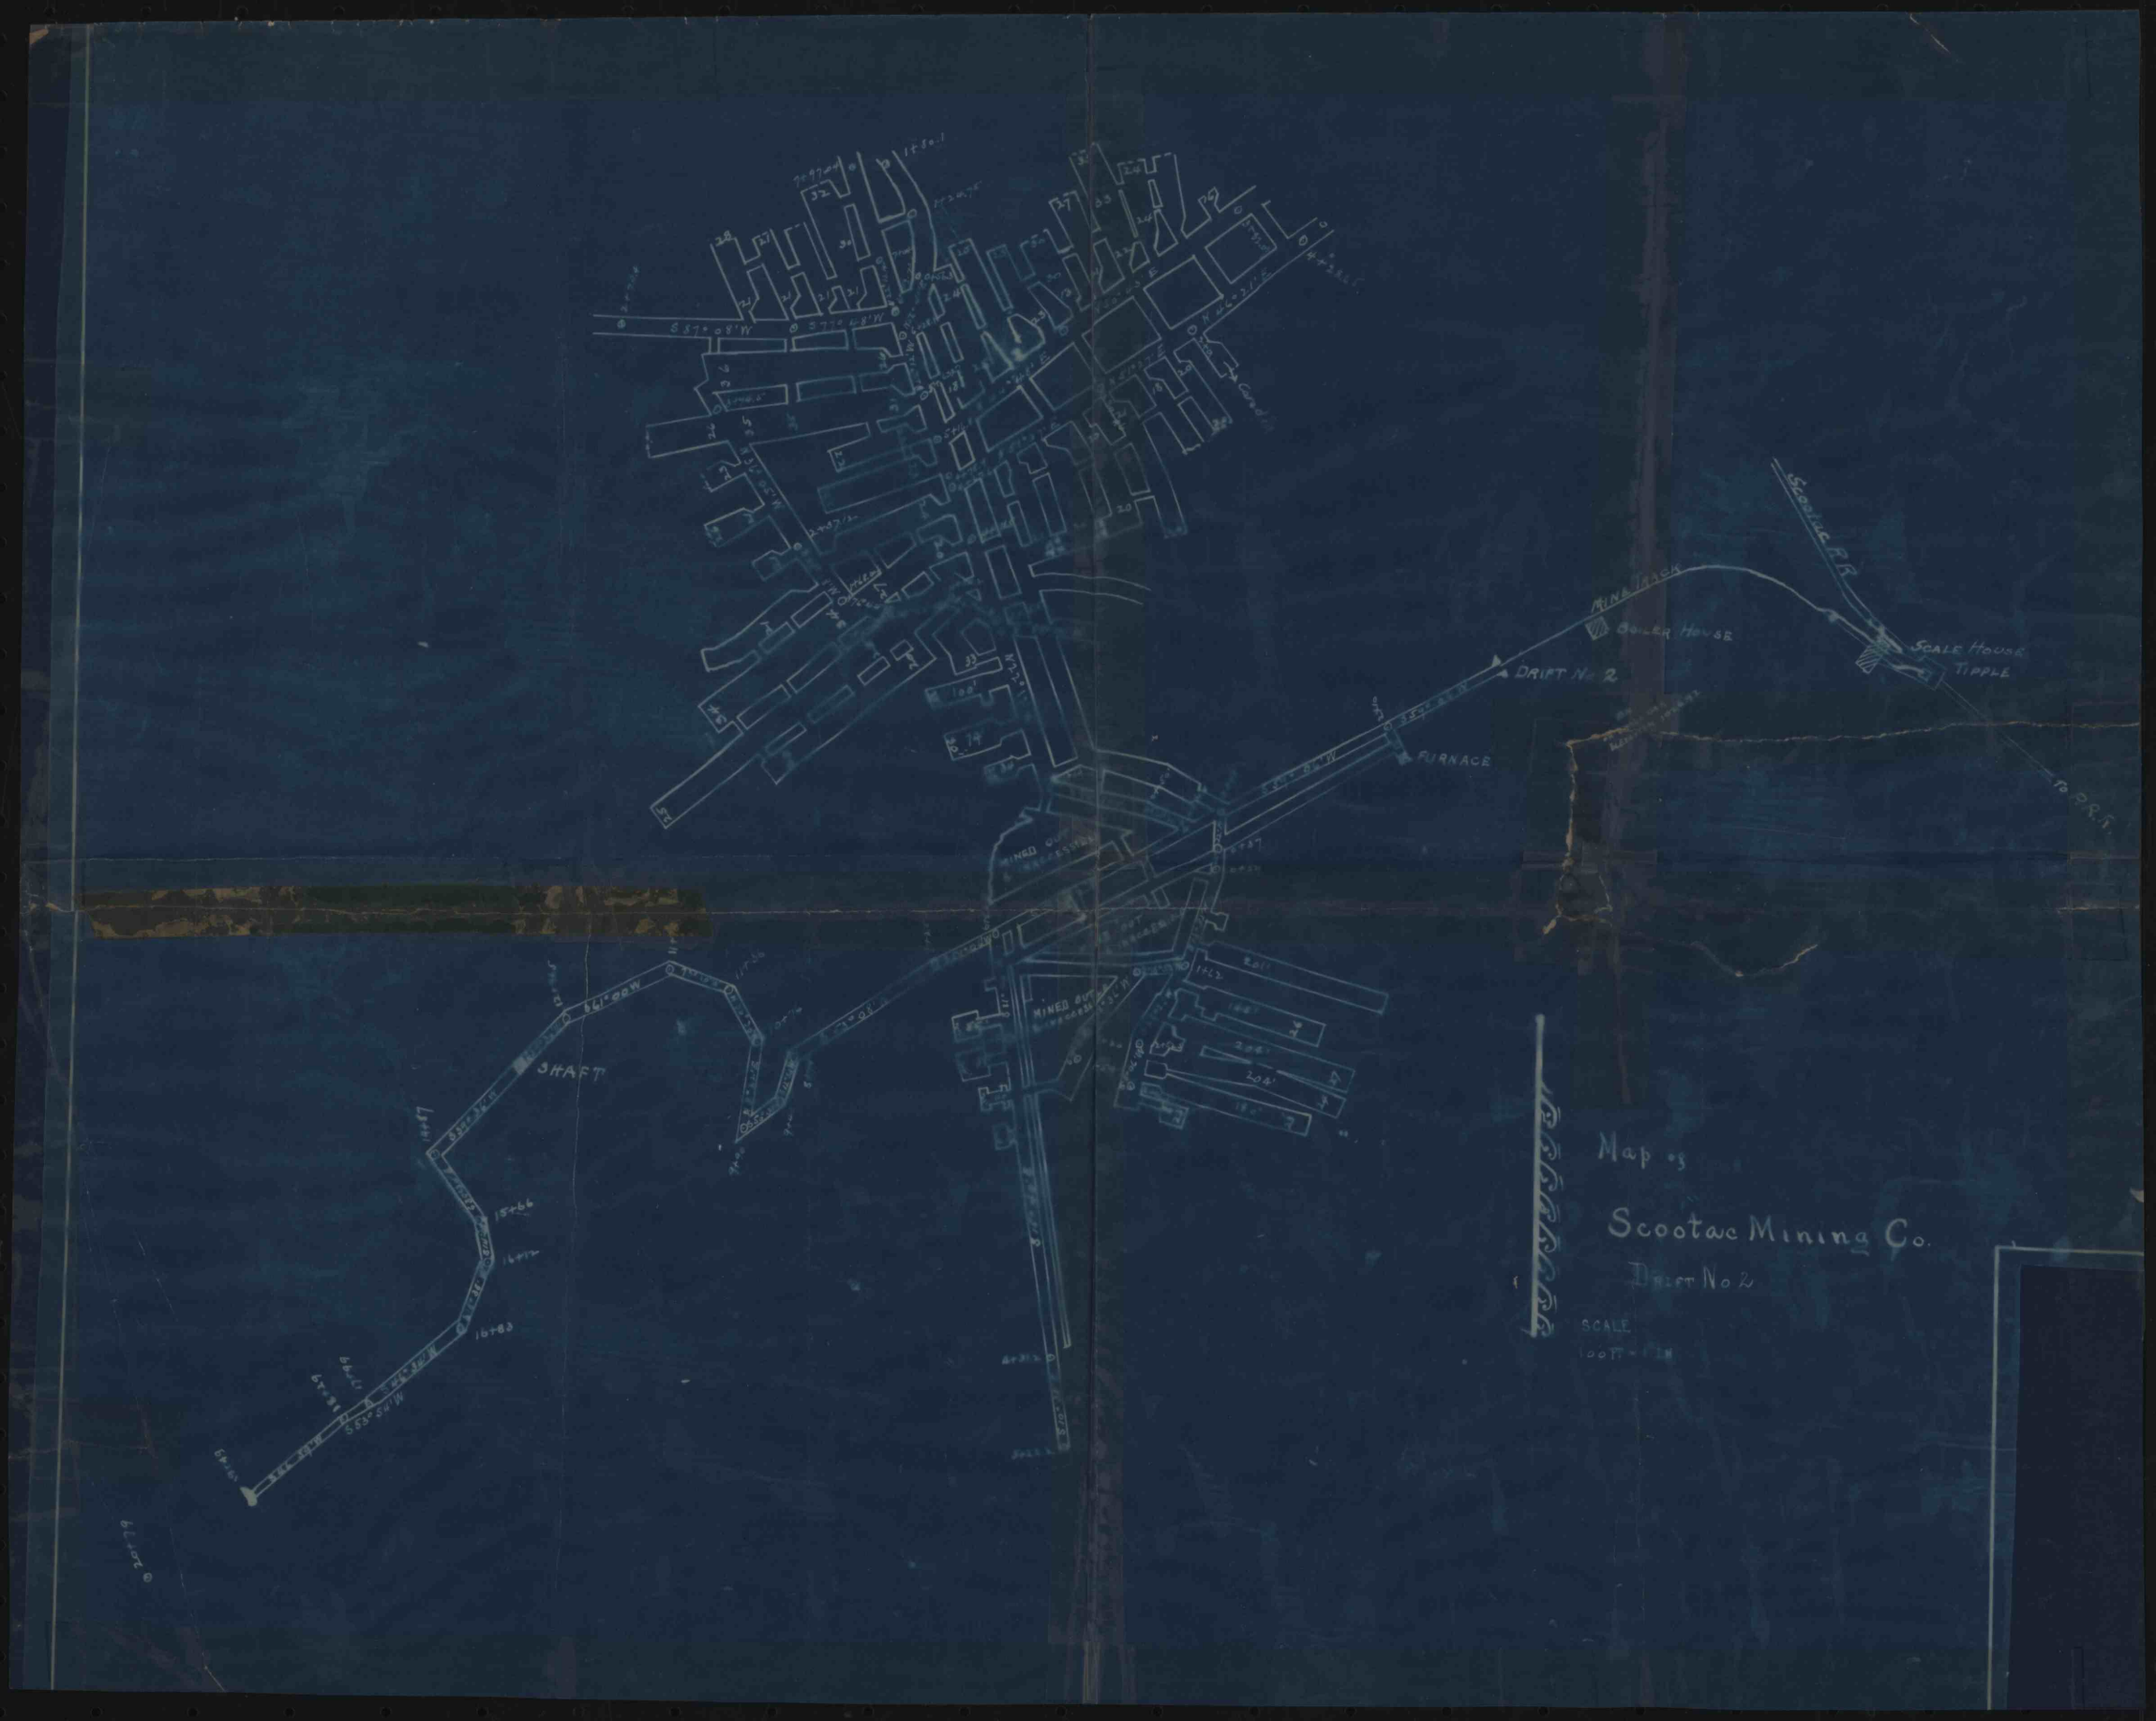
Scootac R.R.
MINE YARDS
BOILER HOUSE
SCALE HOUSE
TIPPLE
DRIFT No 2
FURNACE
To O.R.R.
3 SHAFT
Map of
Scootac Mining Co.
DRIFT No 2
SCALE
100 FT = 1 IN