


Clay and Fuel Workings
WEST BRANCH FIRE BRICK Co.

Renovo, Pa. INDEX NO-26-2-6

Scale 100 ft per inch
Surveyed by Paul F Lyon
October, 1913

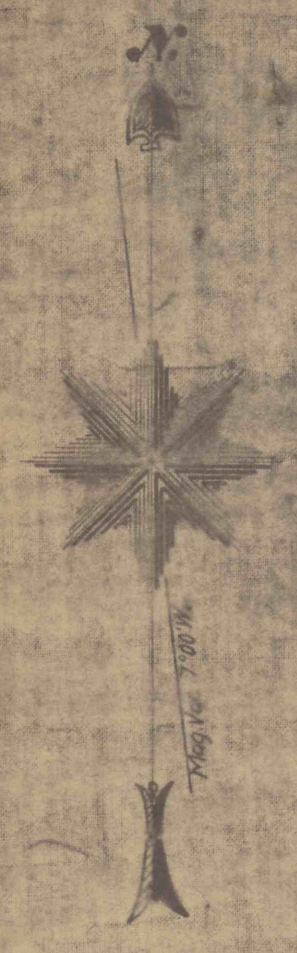

JOHN OLDOEN, No 3889
JOHN OLDOEN, No 3890

