




PENNA. NO. 17 E. MINE  
E. SEAM  
BARFESBORO  
CAMBRIA CO., PA.

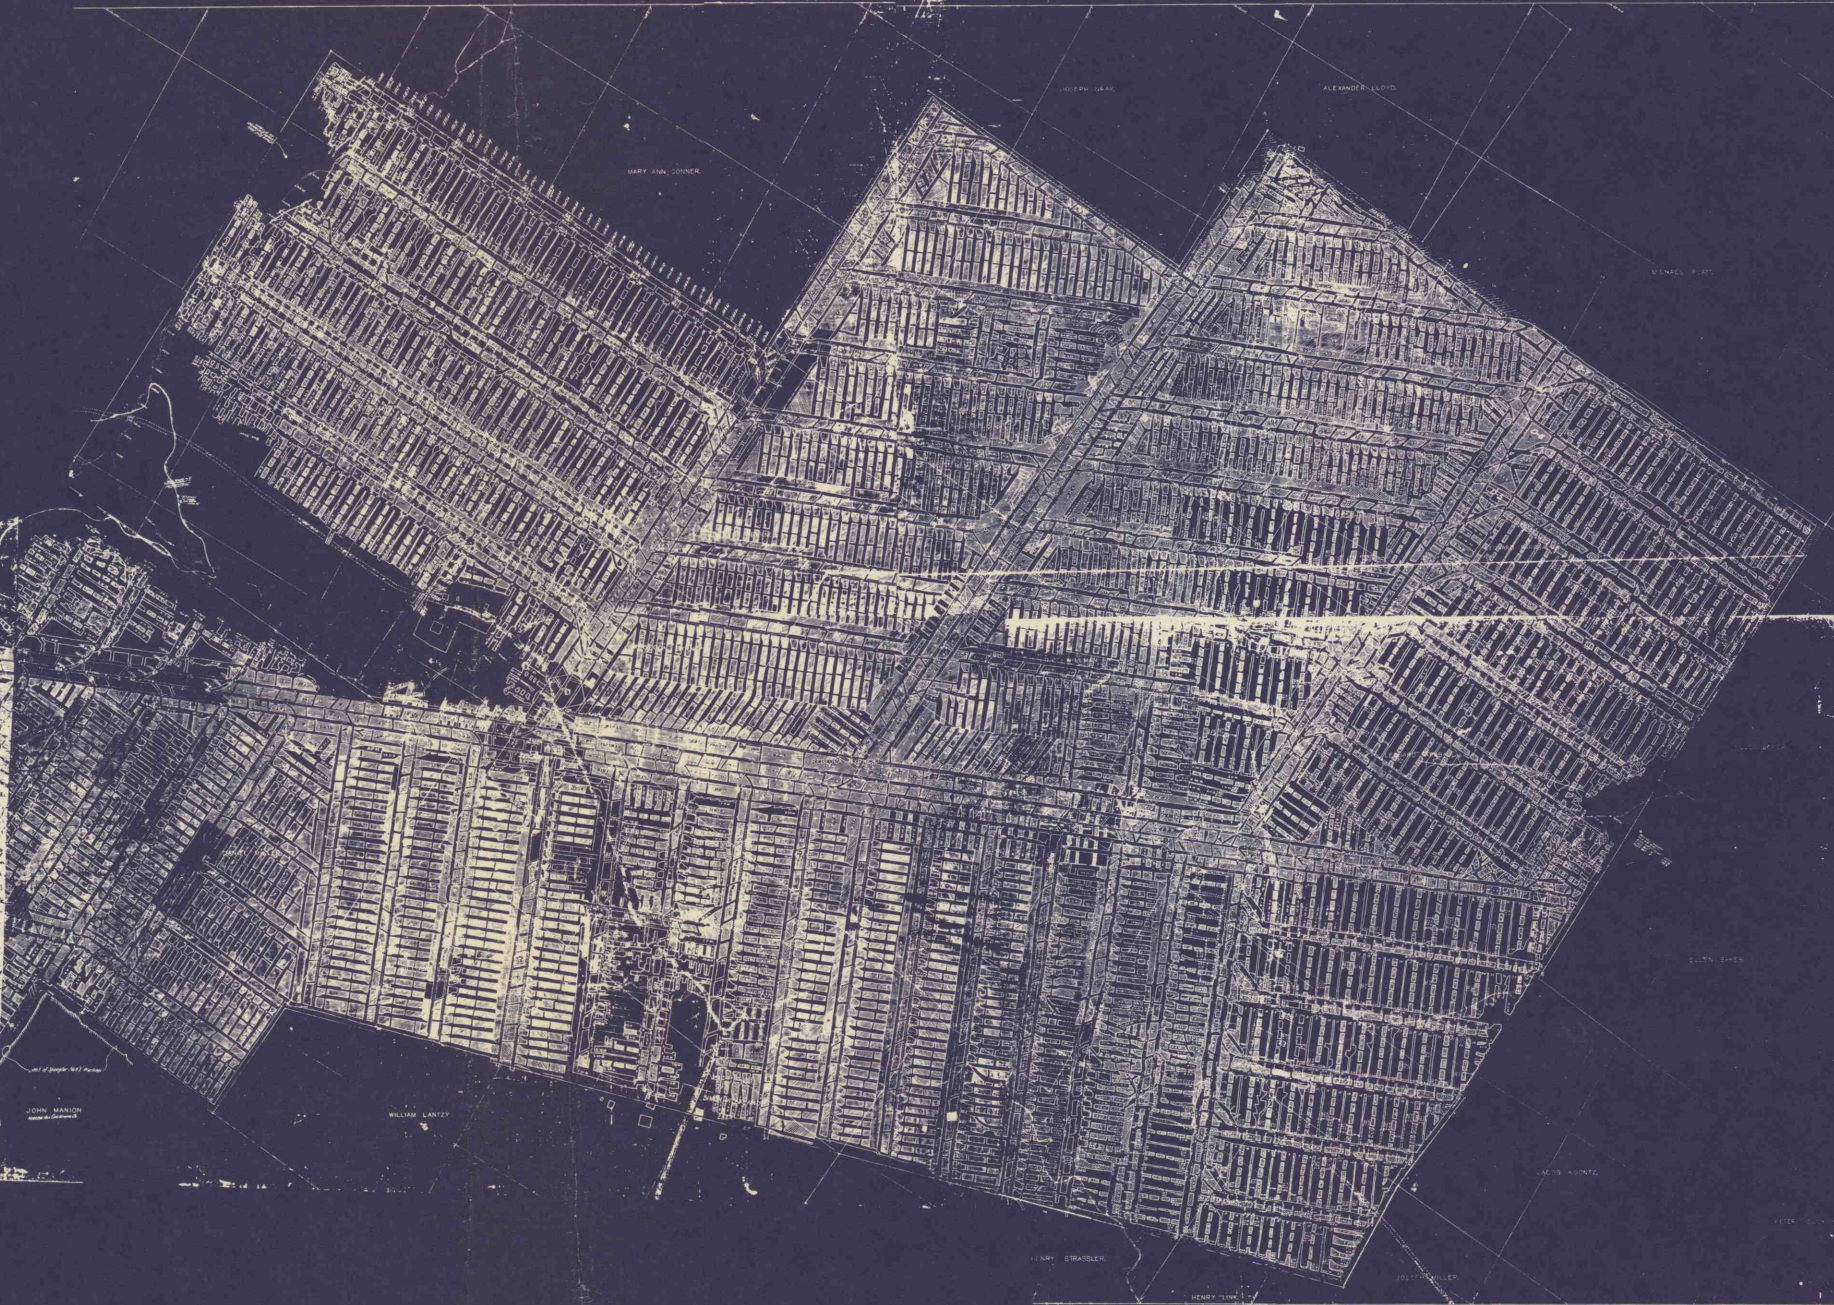

MARY ANN COVER






JOHN MARION

WILLIAM LANTZ





