



LACY COAL CO.
VIRGINIA MINE

DATE OF SURVEY.
MAY 7, 1917.

APRIL 2, 1920.
DEC. 29, 1921.
MAR. 25, 1922.

CHAMPION MINE

SITUATE IN
EAST BETHLEHEM TWP., WASHINGTON COUNTY, PA.


SCALE - 1" = 100' FEBRUARY 1914.

TRACED FROM BLUEPRINT BY JOHN M. RAYBURN.

EXTENSIONS

- MAY 14, 1925.
- DEC. 1, 1927.
- JAN. 10, 1928.
- MAY 22, 1928.
- DEC. 2, 1928.
- MAR. 10, 1930.
- NOV. 3, 1930.
- JAN. 21, 1931.
- DEC. 2, 1931.
- JUNE 1, 1932.
- JULY 17, 1932.

COLUMNAR SECTION OF BORE HOLES

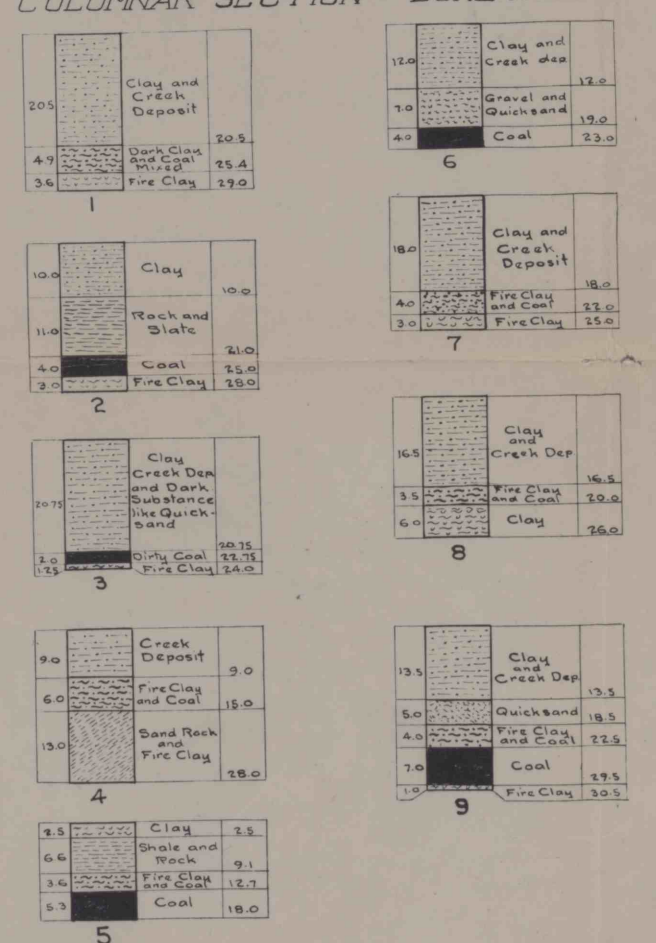

W-2
BARREN AREA = 15.372 ACRES.

TEN MILE CREEK

7A
CHAMPION