


CHAMPION MINE

CHAMPION GAS COAL CO

SITUATE IN
EAST BETHLEHEM TWP., WASHINGTON COUNTY, PA.
SCALE: 1"=100' - FEBRUARY 1914.

COLUMNAR SECTION OF BORE HOLES

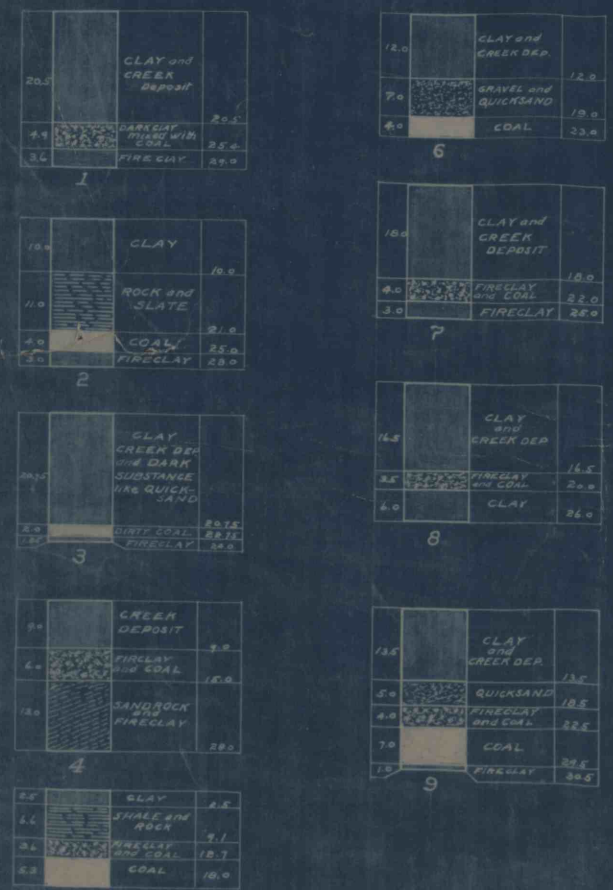

W-2
BARREN AREA = 15.372 ACRES.