

PROPERTY OF THE
GREENE COUNTY COAL & COKE CO.

SITUATE IN
 DUNKARD TOWNSHIP, GREENE COUNTY, PA.

SCALE: 1"=100' —X— JUNE 26, 1917.


F.E. Co.

DATE OF SURVEY.

DEC. 21, 1918 = A.

JULY 30, 1919 = B.

NOV. 3, 77 = C.

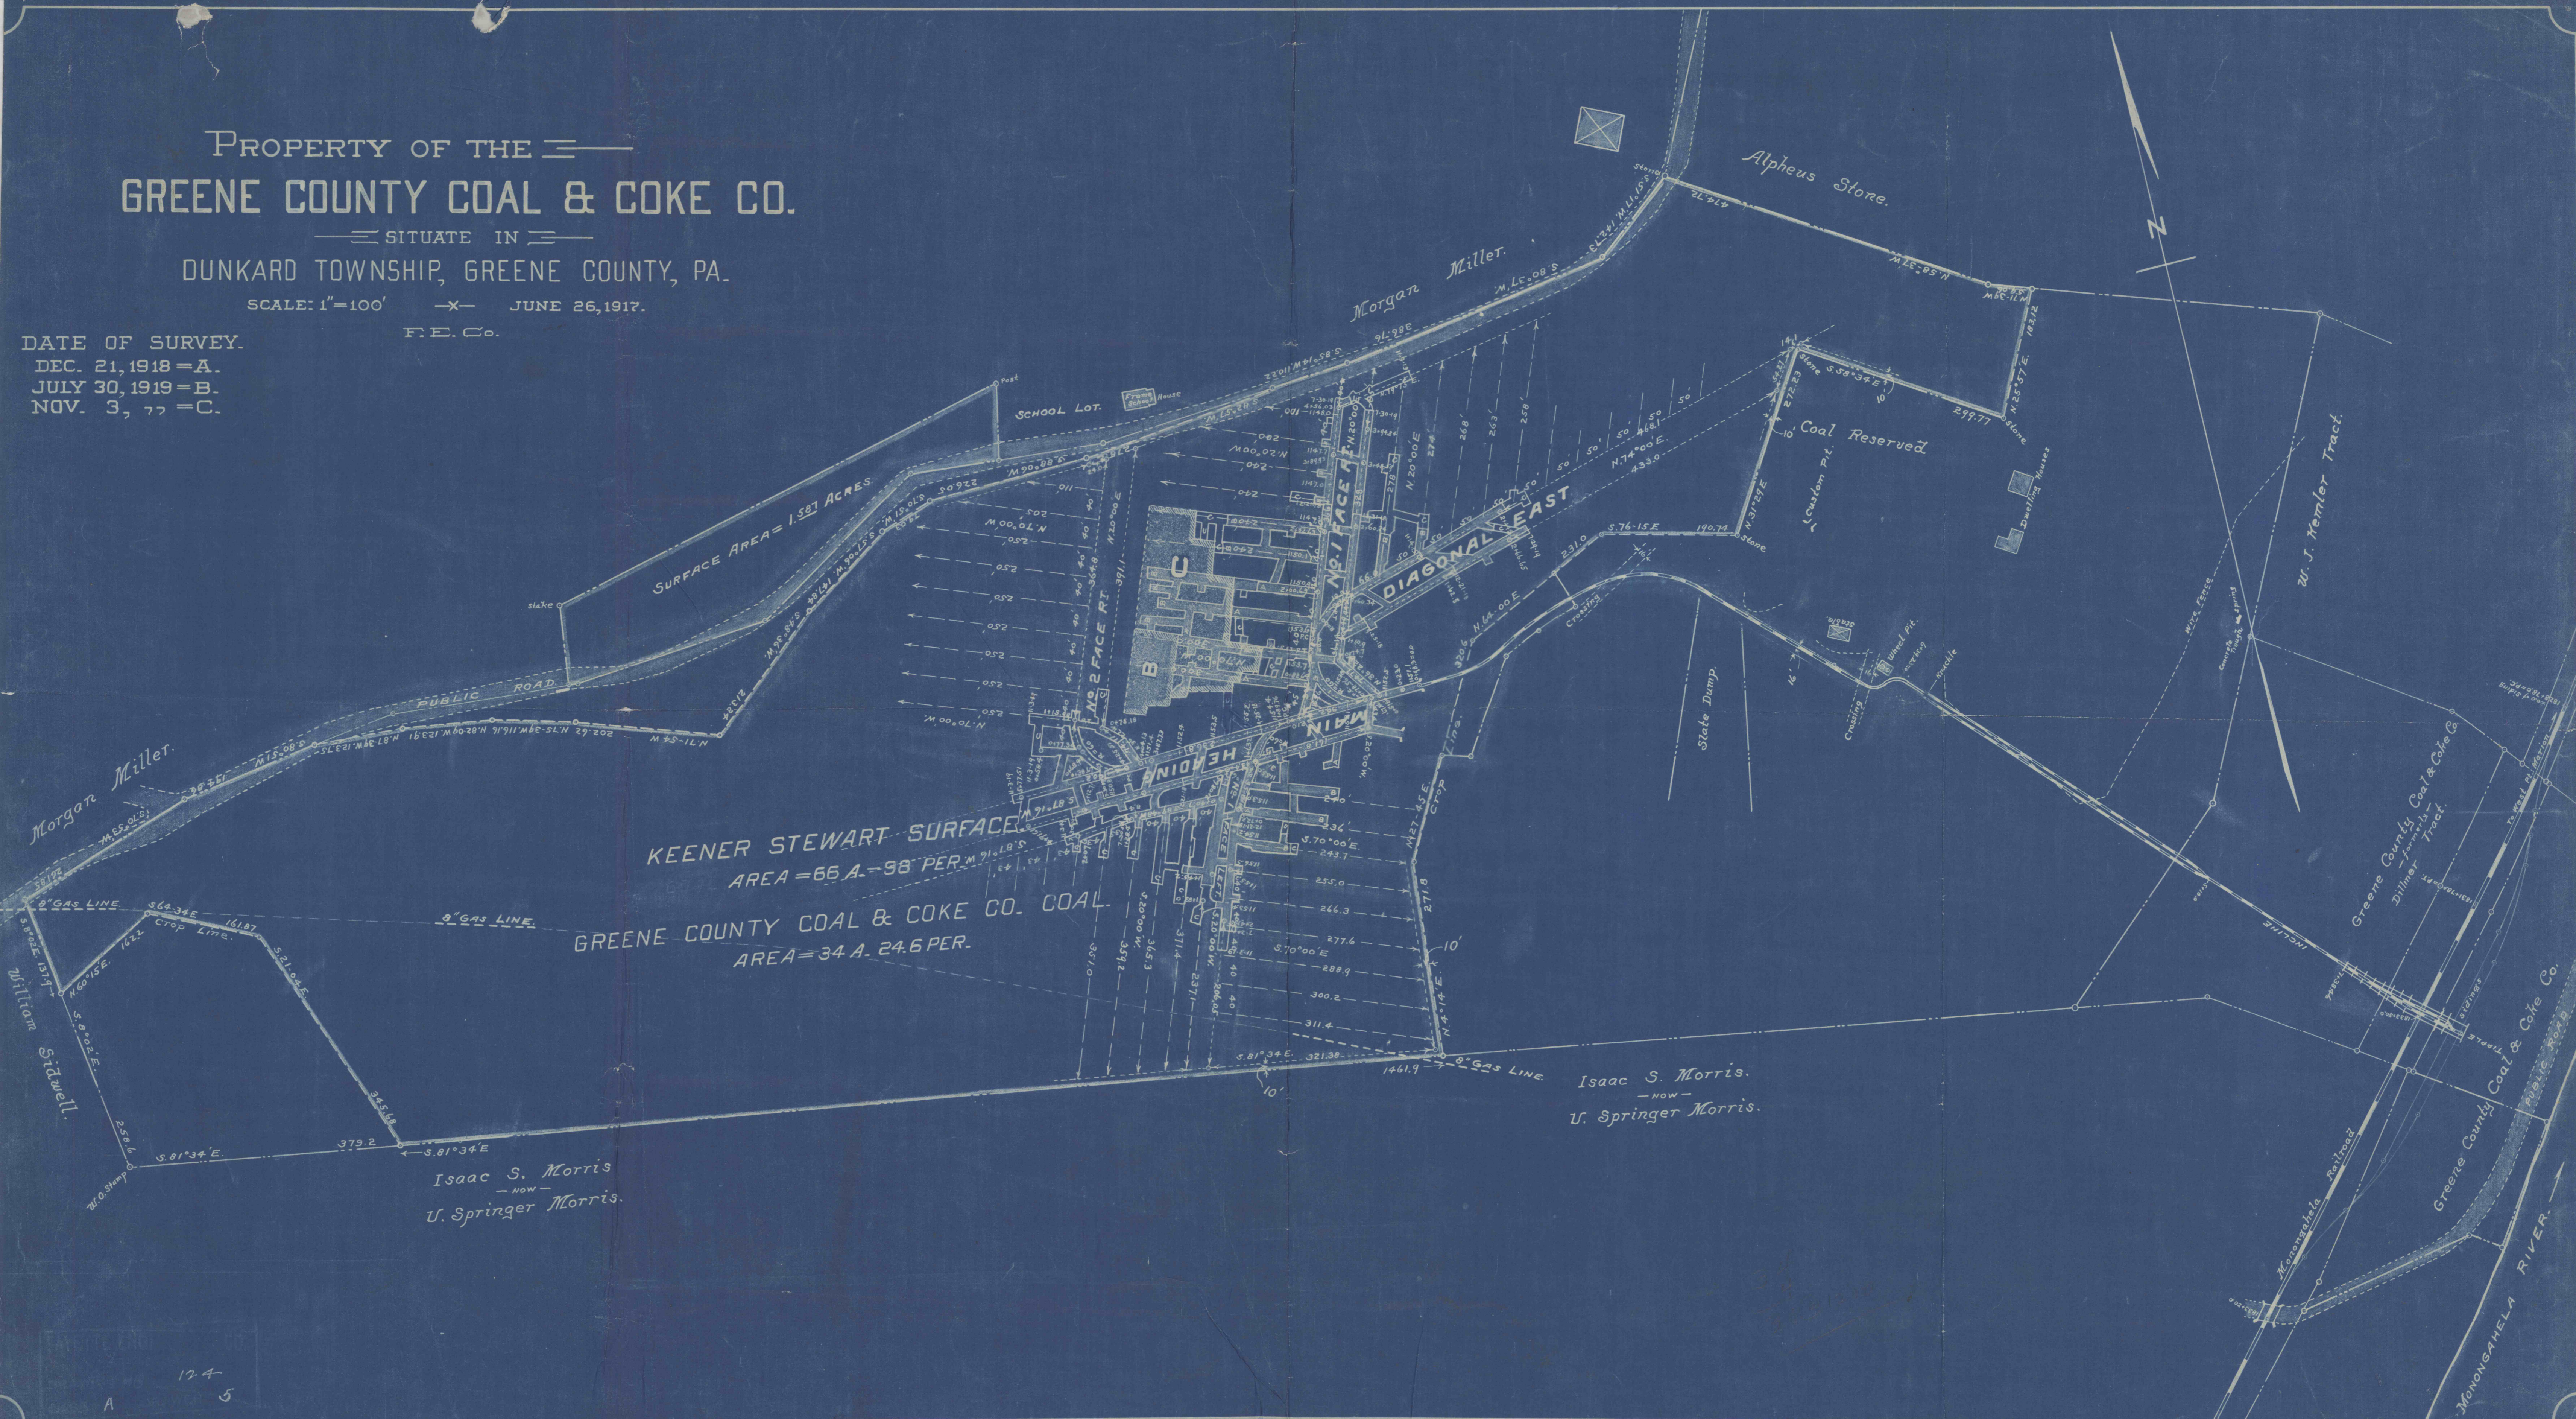

Isaac S. Morris
 —NOW—
 U. Springer Morris.

Isaac S. Morris.
 —NOW—
 U. Springer Morris.