



SURVEYS CORRECT TO:

- A-7-21-65
- B-6-15-66
- C-1-24-67
- 6-15-67 BY M.F.


B. G. & L. COAL CO.
 UNION MINE NO. 1
 SITUATE IN
 BURRELL TWP, ARMSTRONG CO., PA.

SCALE: 1" = 100 FT.
 MINING: MAHONING SEAM

FINAL MAP

MINING TAKEN FROM MAP BY OTHERS.
 FINAL LOCATION OF WORKINGS AT PILLAR
 EXTRACTION AREA BY MINE FOREMAN.
 MINE OPENINGS SEALED AUGUST, 1972
 NOTE: NO MINE ELEVATIONS SHOWN ON
 MAP OF MINE OTHER THAN INDICATED.
 ABANDONED MARCH 31, 1967

DRAWN BY CHARLES S. KRAVETSKY #512782E
 AVONMORE, PA.

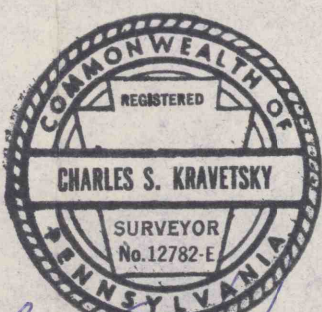

Charles S. Kravetsky

