


2826 #

303059

MAG 1914

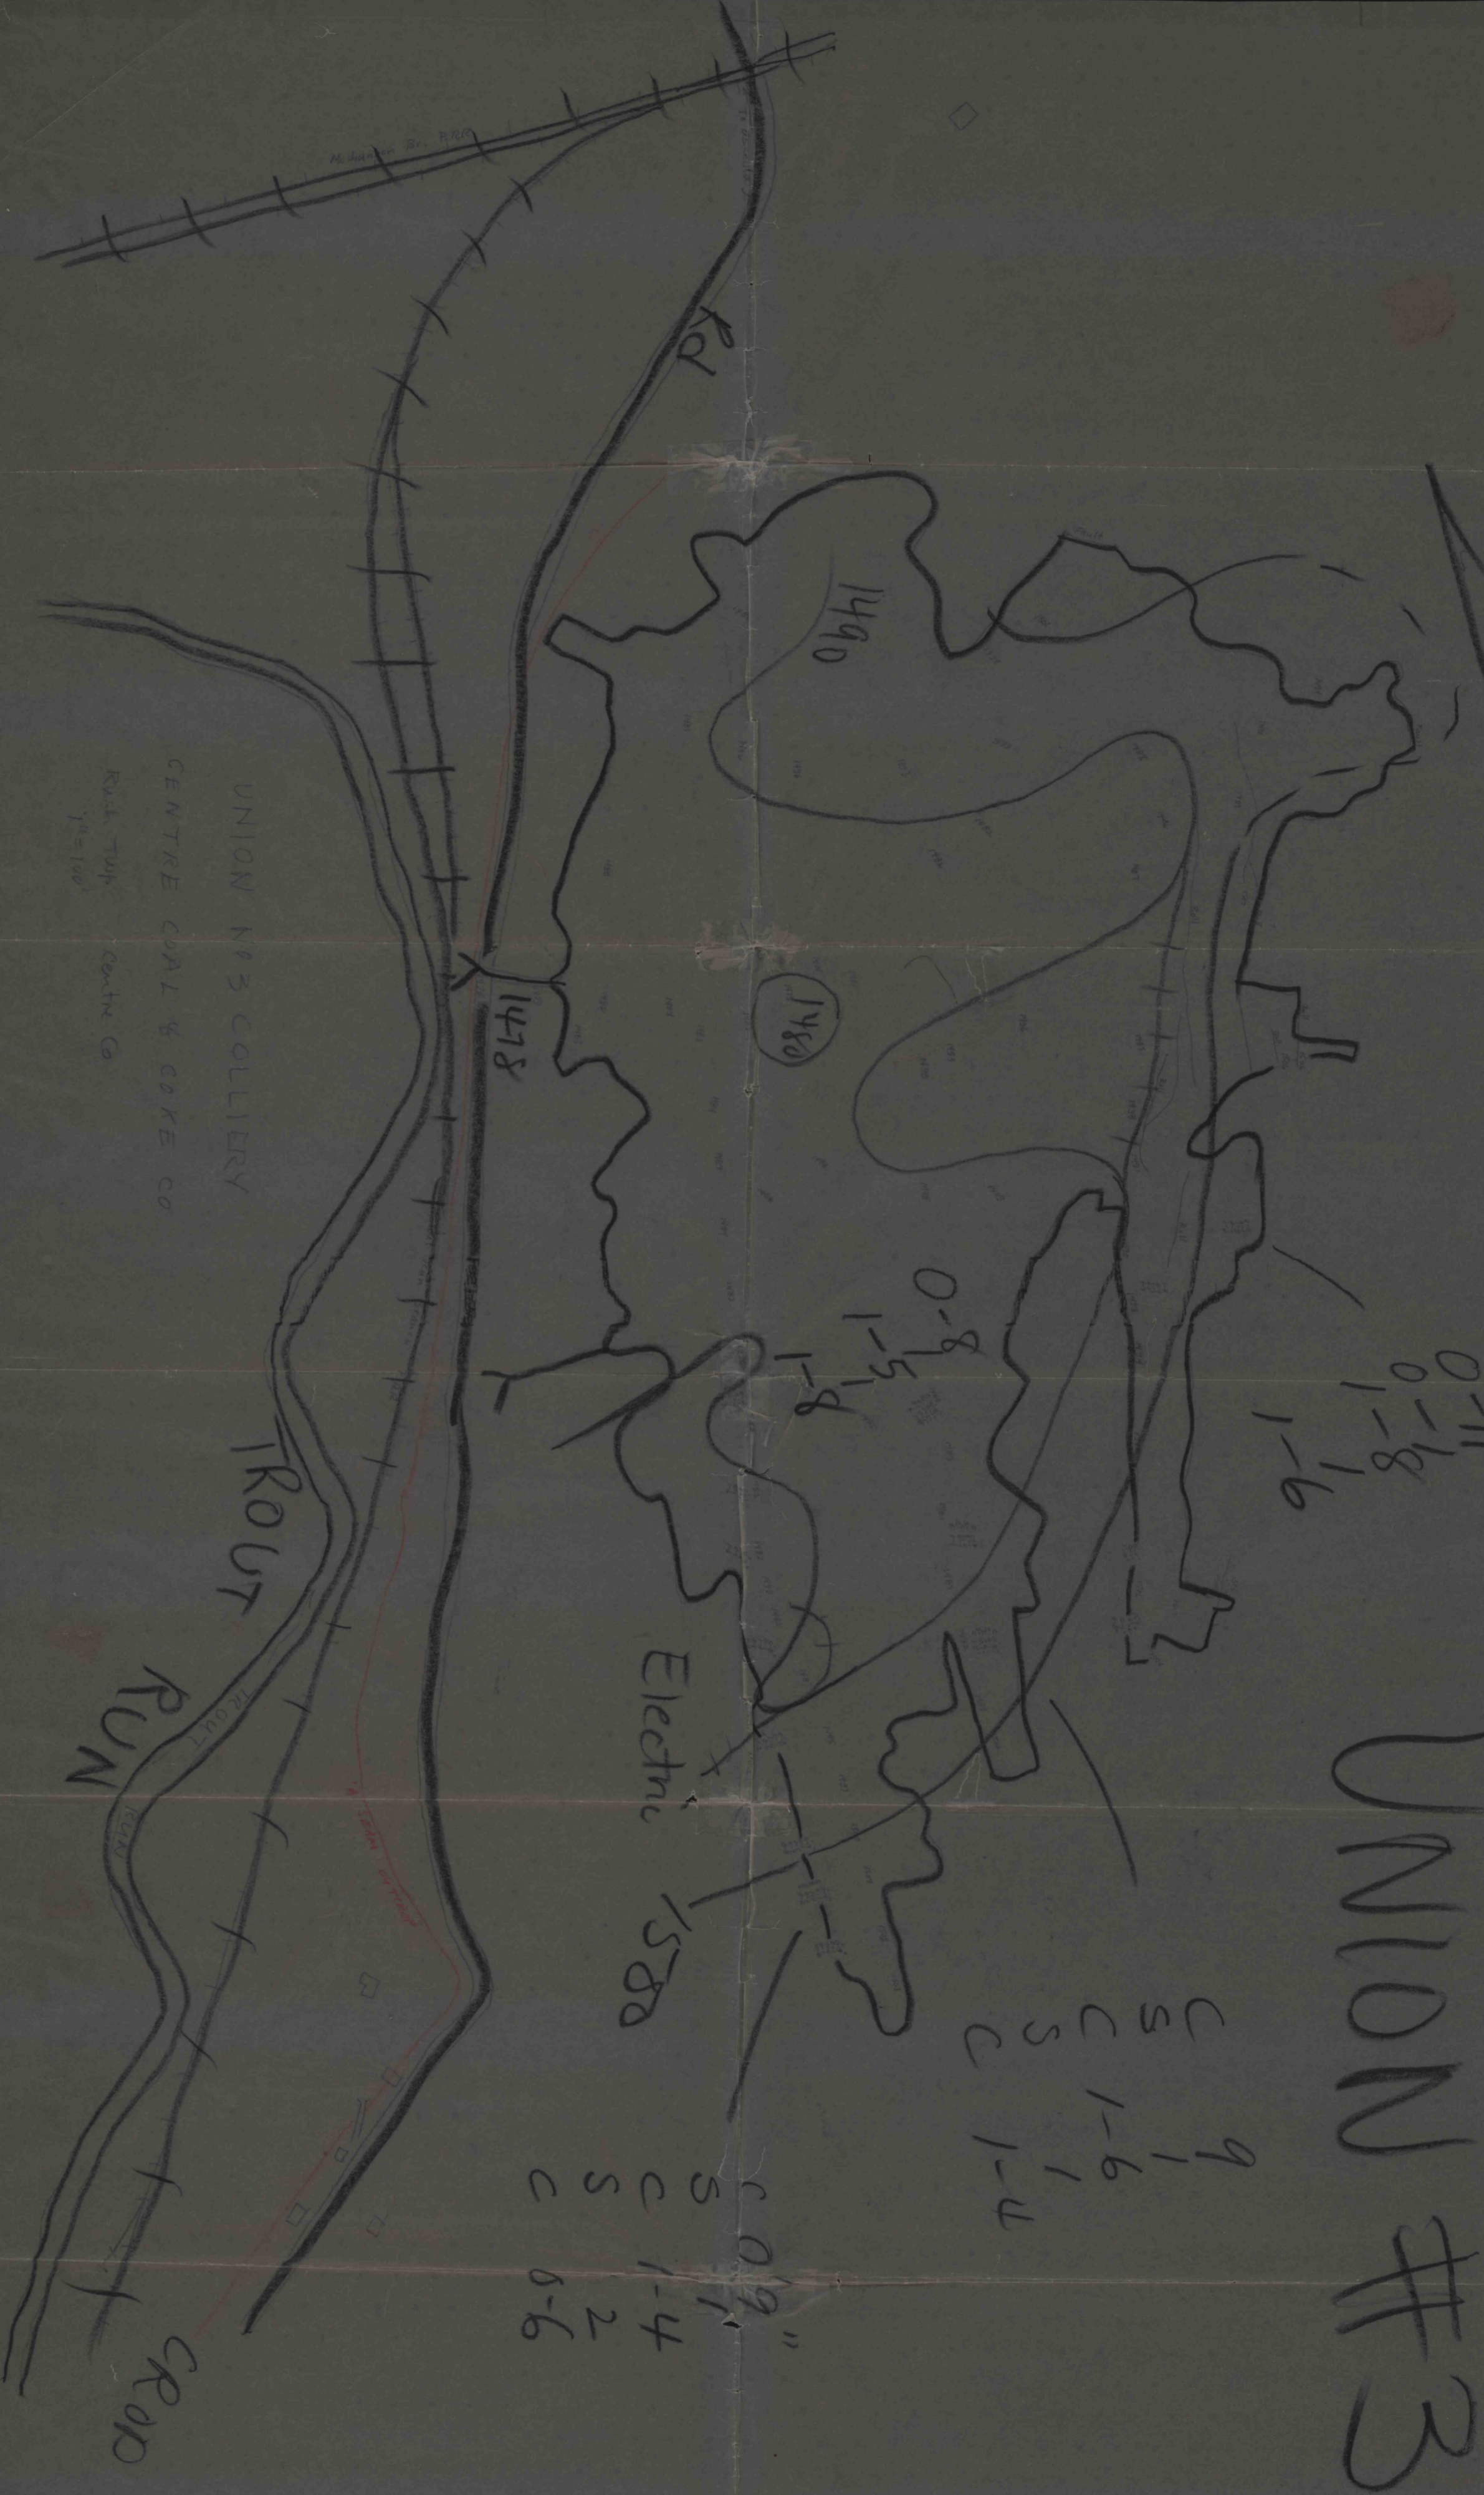

UNION #3 COLLIERY  
 CENTRE COAL & COKE CO  
 Centre Co  
 14=100'

0-11  
 0-1-8  
 1-6

0-8  
 1-5  
 1-8

Electric  
 1588  
 "0-19"  
 S C 1-4  
 S C 2  
 S C 6-6

C S C  
 C S C  
 1-6  
 1-4

UNION #3

KROUT  
 RUN

CRAP

0-11  
 0-1-8  
 1-6